


1 FRAMING PLAN
1/4"=1'-0"

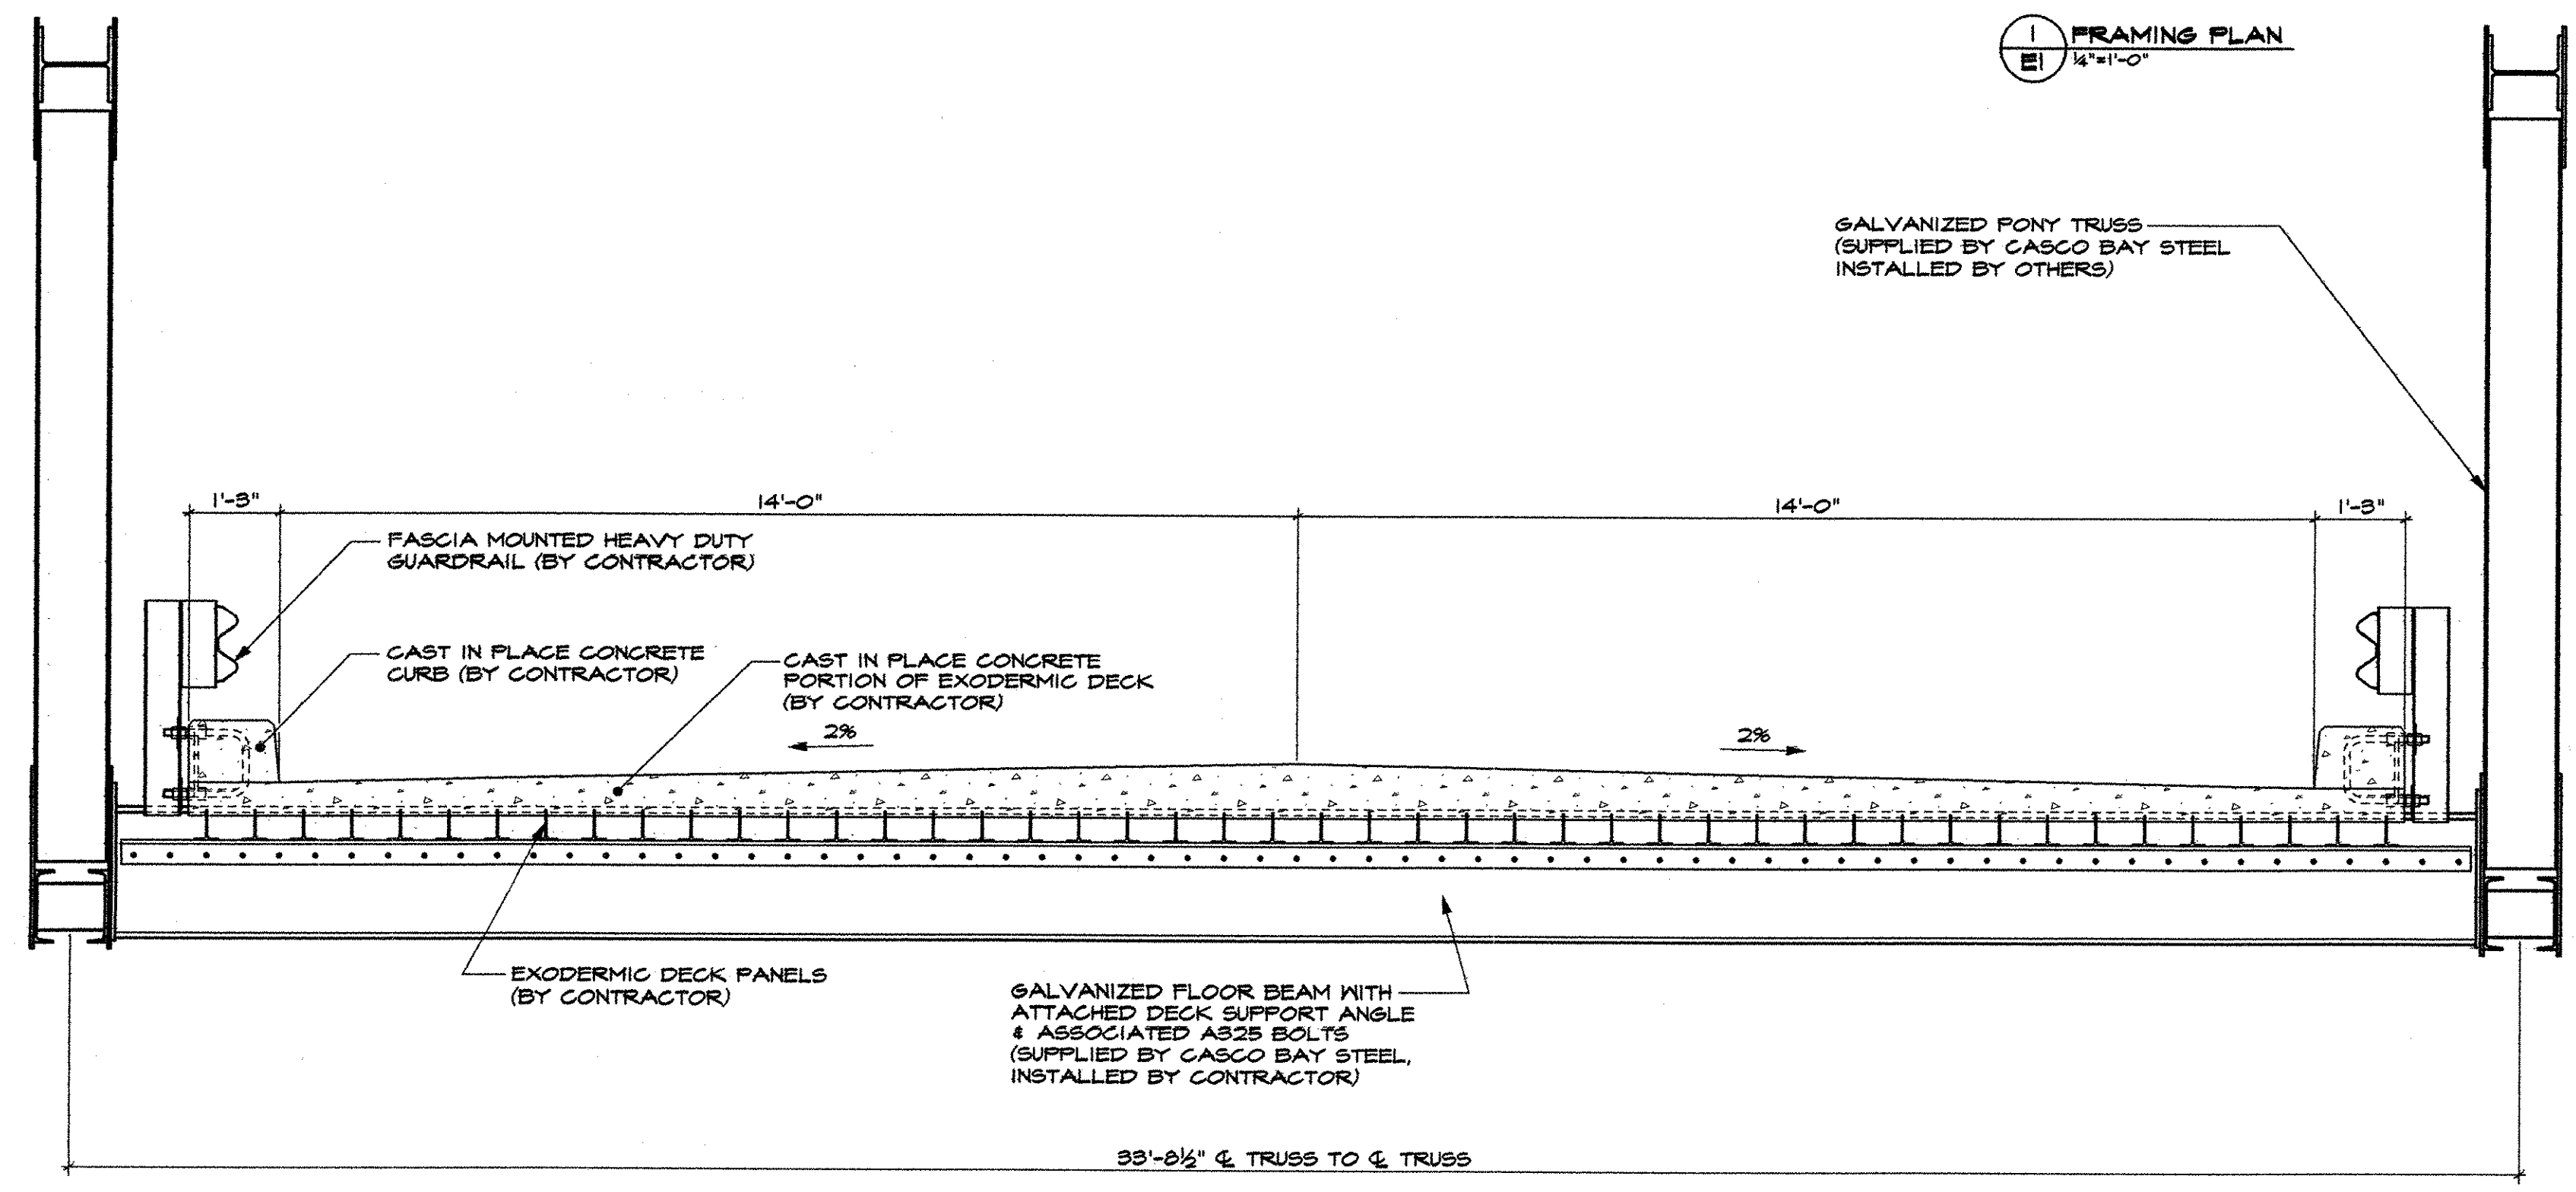

2 TRANSVERSE SECTION
1/2"=1'-0"

GALVANIZED PONY TRUSS
(SUPPLIED BY CASCO BAY STEEL
INSTALLED BY OTHERS)

UNIVERSITY OF VERMONT
STATE OF VERMONT
NO. 871
LICENSED
PROFESSIONAL ENGINEER
6/26/07

REVIEWED
JUN 29 2007
CPM CONSTRUCTORS

INVENTORY RATING = 24.12 T H 45.86 T HS
OPERATING RATING = 65.88 T HS

APPROVAL/STAMP:
 REJECTED
 SUBMIT SPECIFIED ITEM
 MAKE CORRECTIONS NOTED
 REVISE AND RESUBMIT
 CUSTOMER IS ONLY FOR GENERAL CONFORMANCE WITH THE
 STANDARD SPECIFICATIONS OF THE PROJECT AND GENERAL
 CONTRACT DOCUMENTS. THE INFORMATION GIVEN IN THE
 DRAWINGS AND QUOTE. ANY ACTION SHOWN TO SUBJECT
 TO THE CONTRACTOR'S OWNERS AND INSURANCE.
 CONTRACTOR SHALL BE RESPONSIBLE FOR THE
 FABRICATION, ERECTION AND MAINTENANCE OF
 CONSTRUCTION, OPERATING AND MAINTENANCE
 OF ALL OTHER TRADING AND THE OPERATIONAL
 PERFORMANCE OF THE WORK.
 CLAUDIA HANCOCK & ASSOCIATES LLP
 ENGINEERS, SURVEYORS, ARCHITECTS
 100 WASHINGTON STREET
 FREETOWN, VERMONT 05740
 DATE 6/26/07 BY [Signature]

MATERIAL NOTED	ELECTRODES E-70XX	HOLES	SHOP BOLTS NONE
SURFACE PREP & PAINT: SPPC SP-8, GALVANIZE IN ACCORDANCE WITH ASTM A123 (TYP. ALL SHEETS)			
DESCRIPTION: FRAMING PLAN & TRANS SECTION		DRAWN BY: ETC	DATE: MAY 2007
JOB: ST. JOHNSBURY VERMONT, TOWN HIGHWAY #85 OVER THE PASSUMPSIC RIVER BRIDGE #24			
PROJ. NO. BRO-1447(19)			
CUSTOMER: CPM CONSTRUCTORS, FREEPORT MAINE PH. (207) 865-0000			
CASCO BAY STEEL STRUCTURES		JOB NO.	DRG. NO.
75 SPRING HILL ROAD PH. (207) 282-7360		SACO, MAINE 04072 FAX (207) 282-1179	E REV. Δ
		076 55	