


SEE VALUE ENGINEERING DESIGN

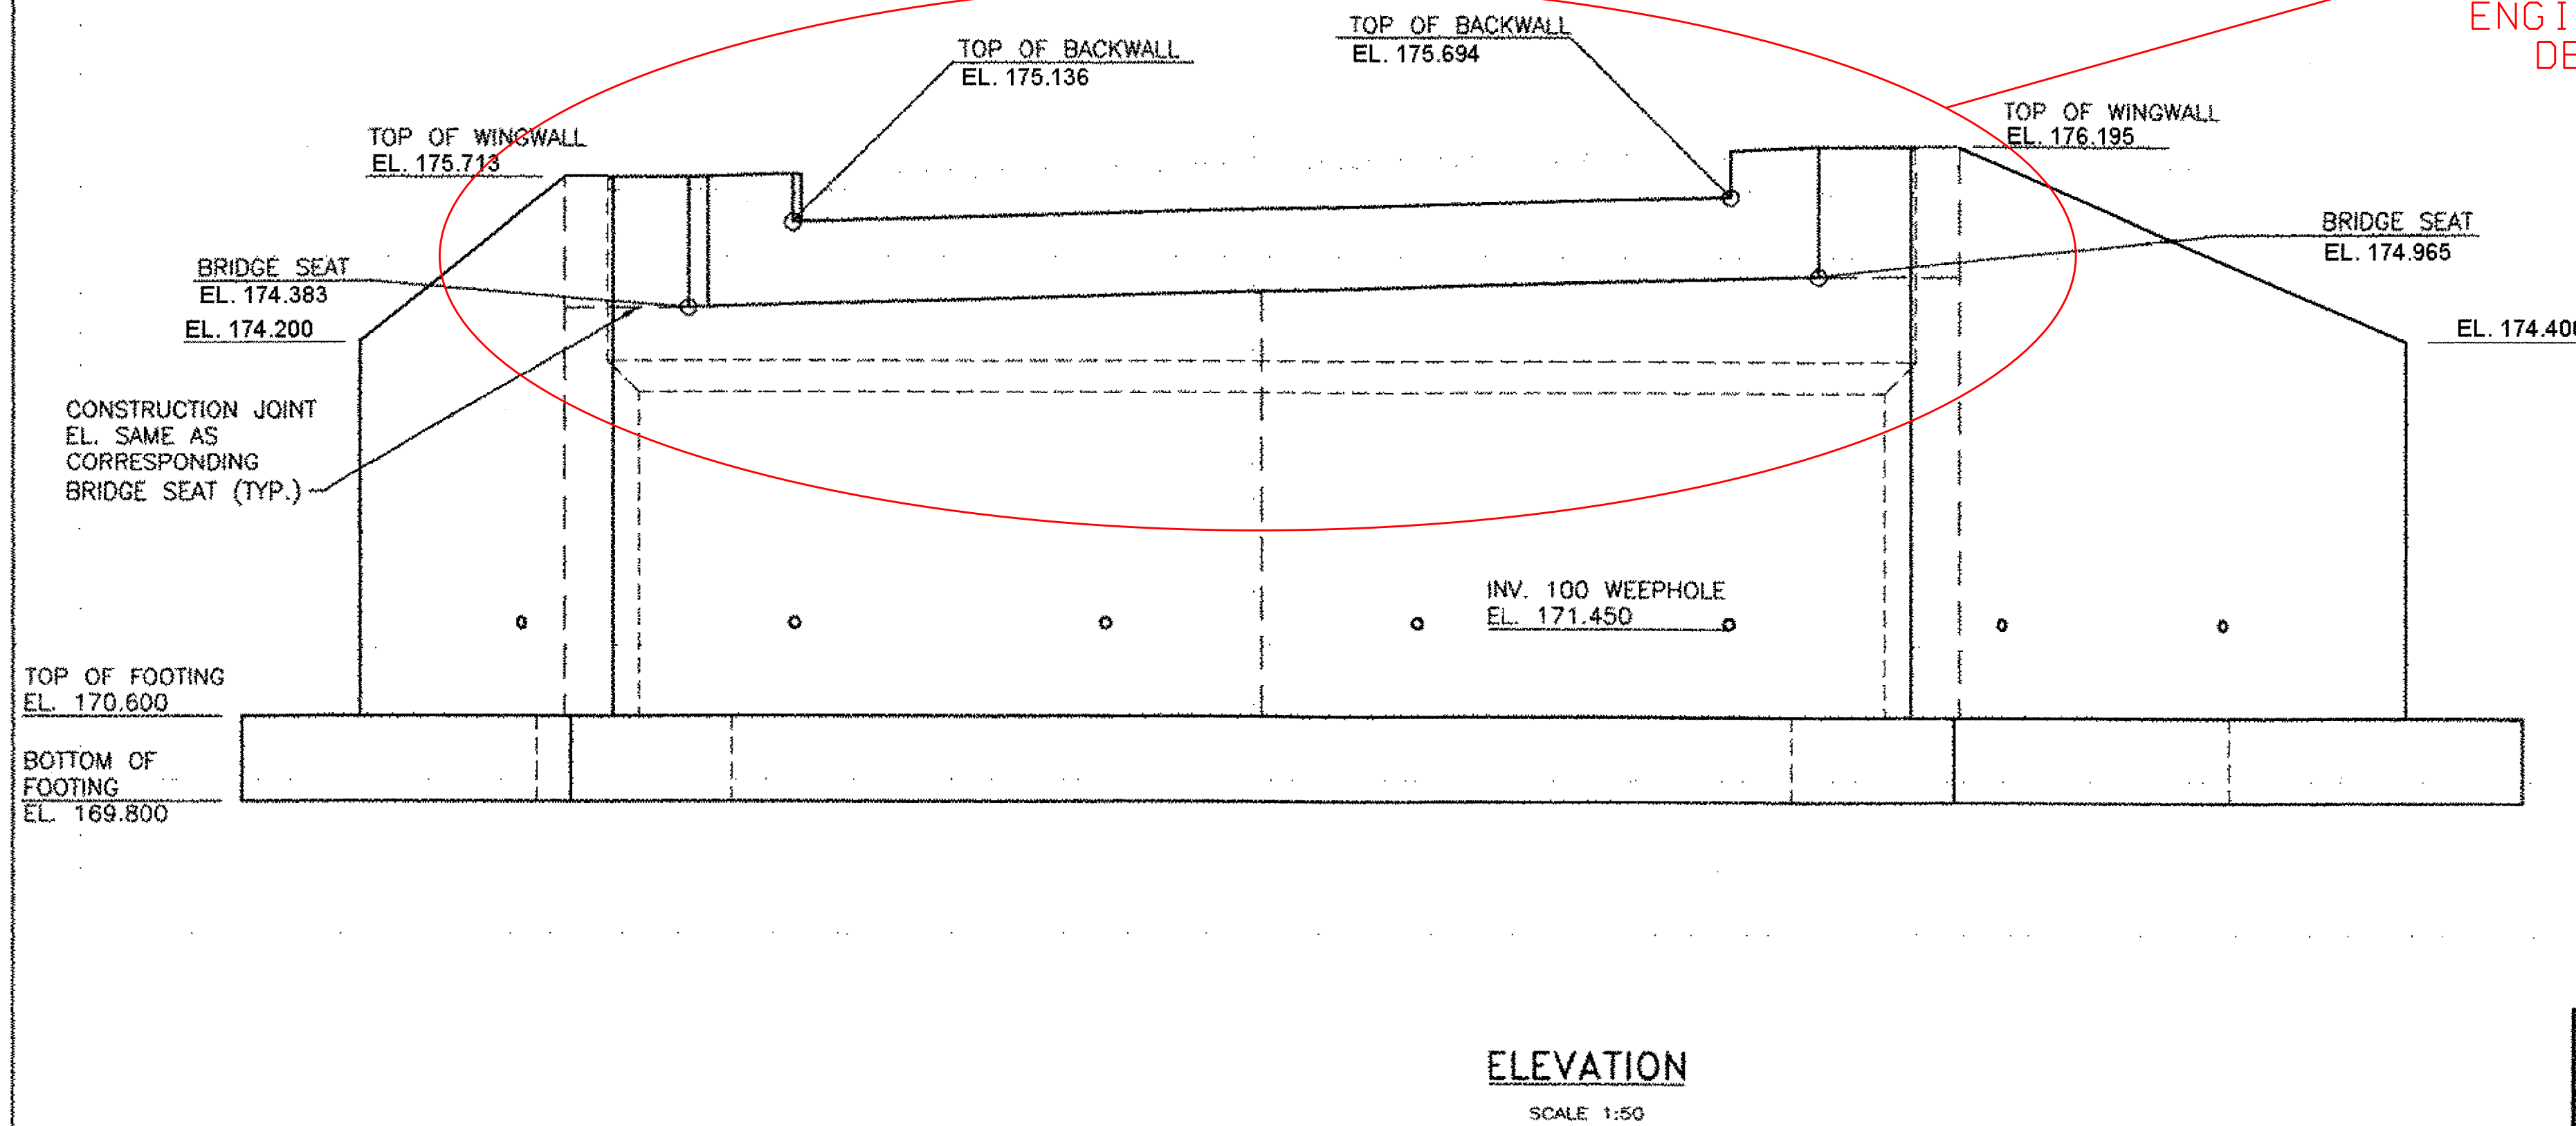

REVISIONS			STATE OF VERMONT AGENCY OF TRANSPORTATION	
NO.	DESCRIPTION	BY & DATE		
			CLARENDON, VERMONT	Bridge No. 14
			TOWN HIGHWAY NO. 1	Log Sta.
				Surv. Sta.
TOWN HIGHWAY NO. 1 OVER THE COLD RIVER				
ABUTMENT NO. 1 MASONRY				
Designed by: B. C. AUSTIN			Drawn by: E. B. SMALL	
Checked by: K. S. MARSHIA date 05/02			Bridge Design Supervisor J.W. TUCKER date 05/02	
PROJECT CLARENDON			PROJECT NO. BR0 1443(29)	
Bridge Sheet No.			SHEET 23 OF 41	

