



ADD LOCATE
BRIDGE PLAQUE
DETAIL

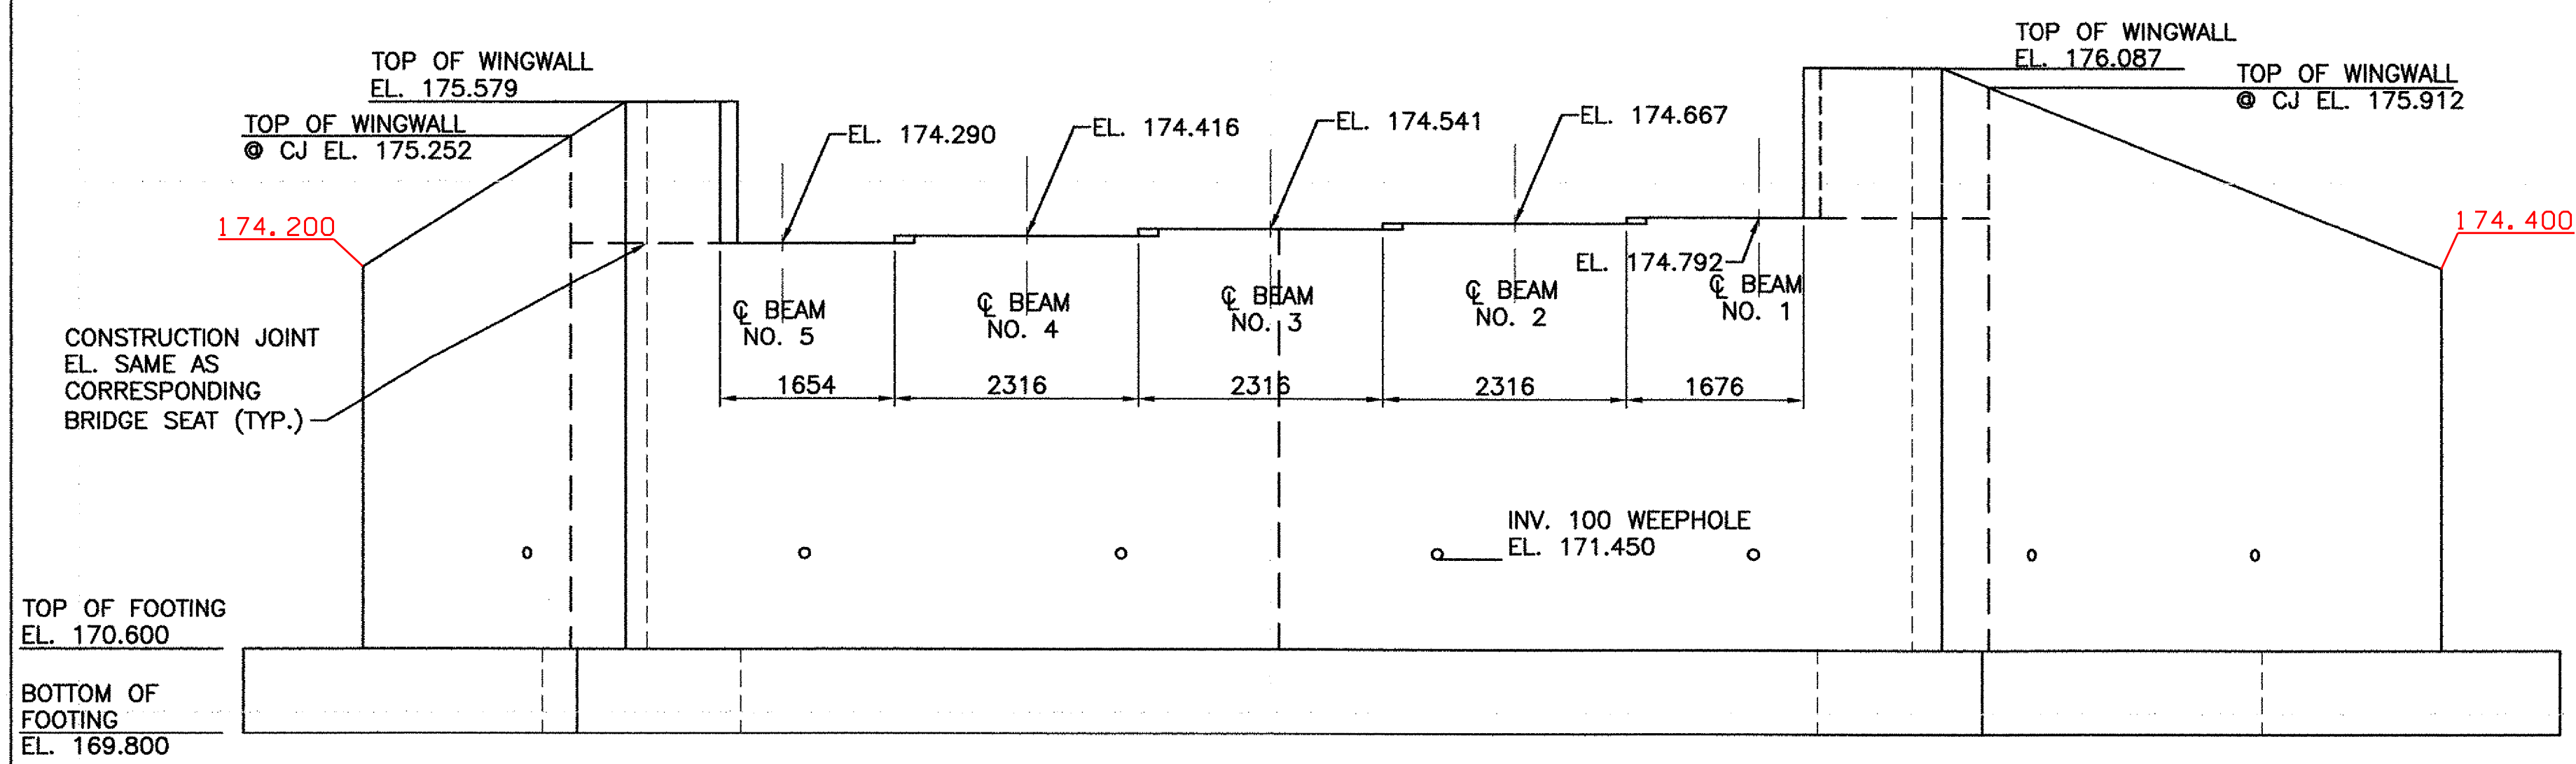

| REVISIONS | | | STATE OF VERMONT AGENCY OF TRANSPORTATION | |
|-----------|-------------|-----------|--|--|
| NO. | DESCRIPTION | BY & DATE | | |
| | | | CLARENDON, VERMONT | Bridge No. 14 |
| | | | TOWN HIGHWAY NO. 1 | Log Sta. |
| | | | TOWN HIGHWAY NO. 1 OVER THE COLD RIVER | |
| | | | ABUTMENT NO. 1 MASONRY | |
| | | | Designed by: A.P. GUYETTE | Drawn by: A.P. GUYETTE |
| | | | Checked by: J.W. TUCKER date 1/06 | Bridge Design Supervisor J.W. TUCKER date 1/06 |
| | | | PROJECT CLARENDON | PROJECT NO. BRO 1443(29) |
| | | | Bridge Sheet No. | SHEET 23A OF 41 |

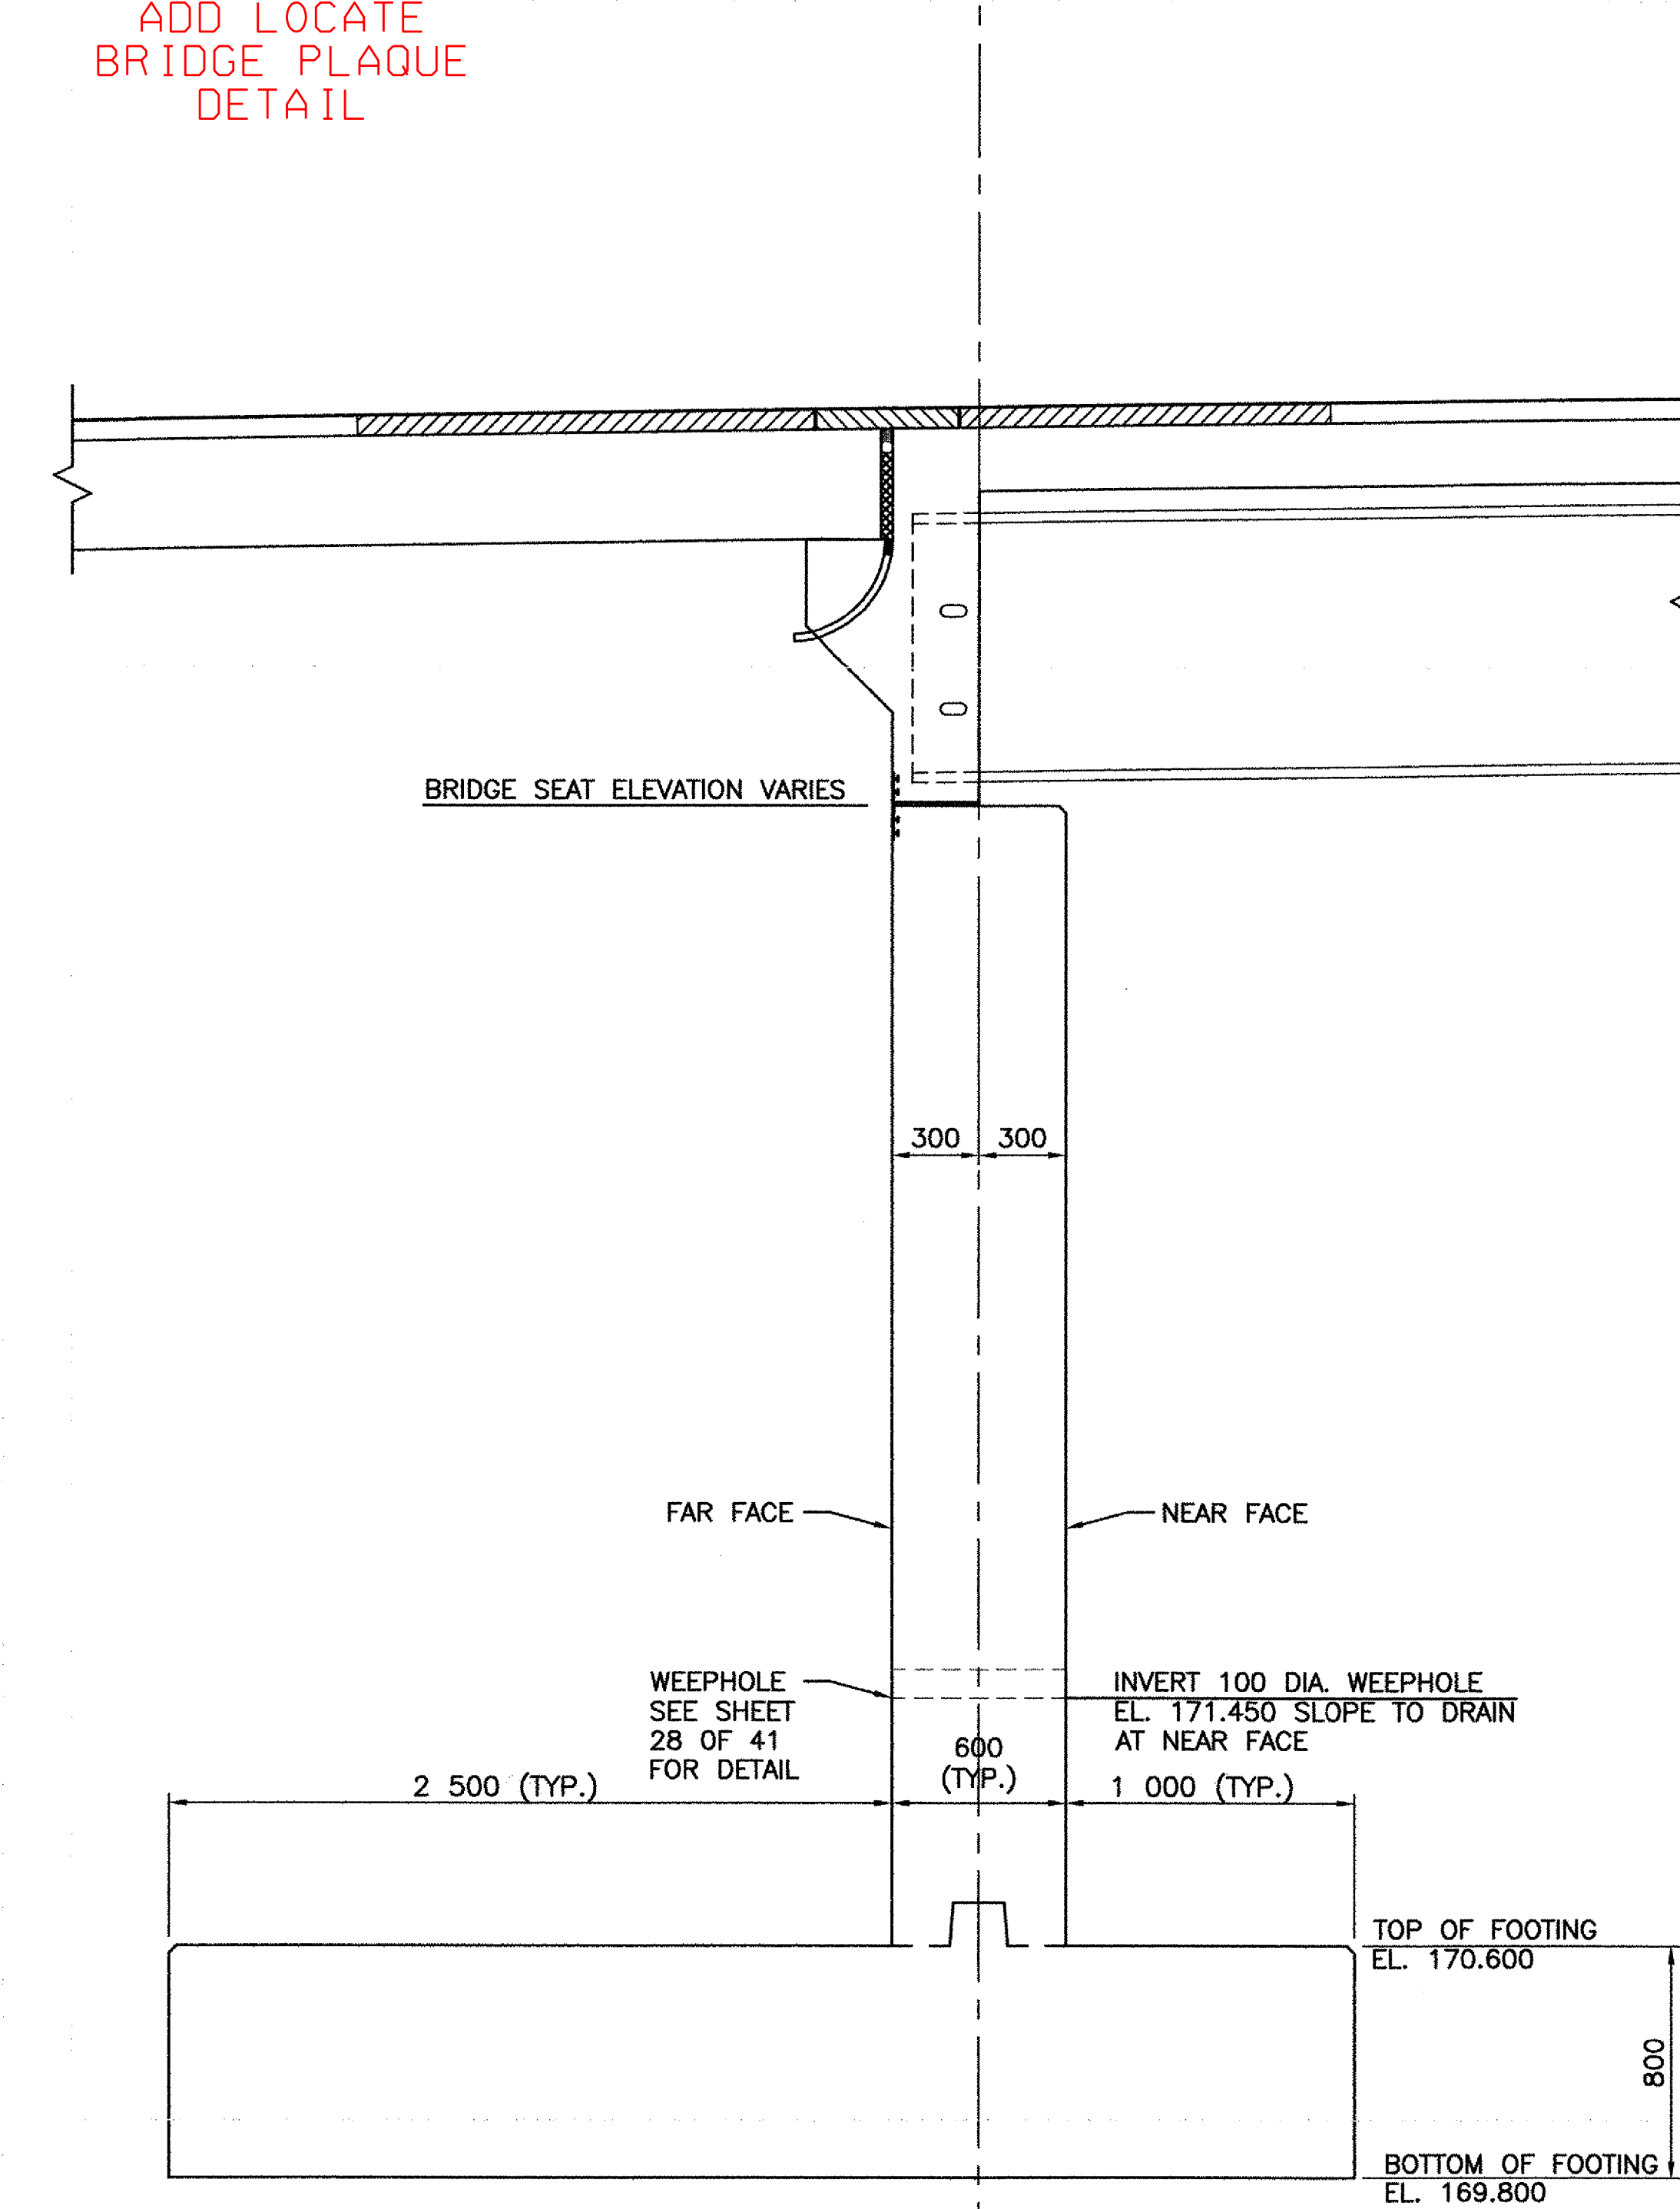