



TYPICAL CORNER DETAIL ABUTMENT NO 1
BELOW HAUNCH
SCALE 1:20

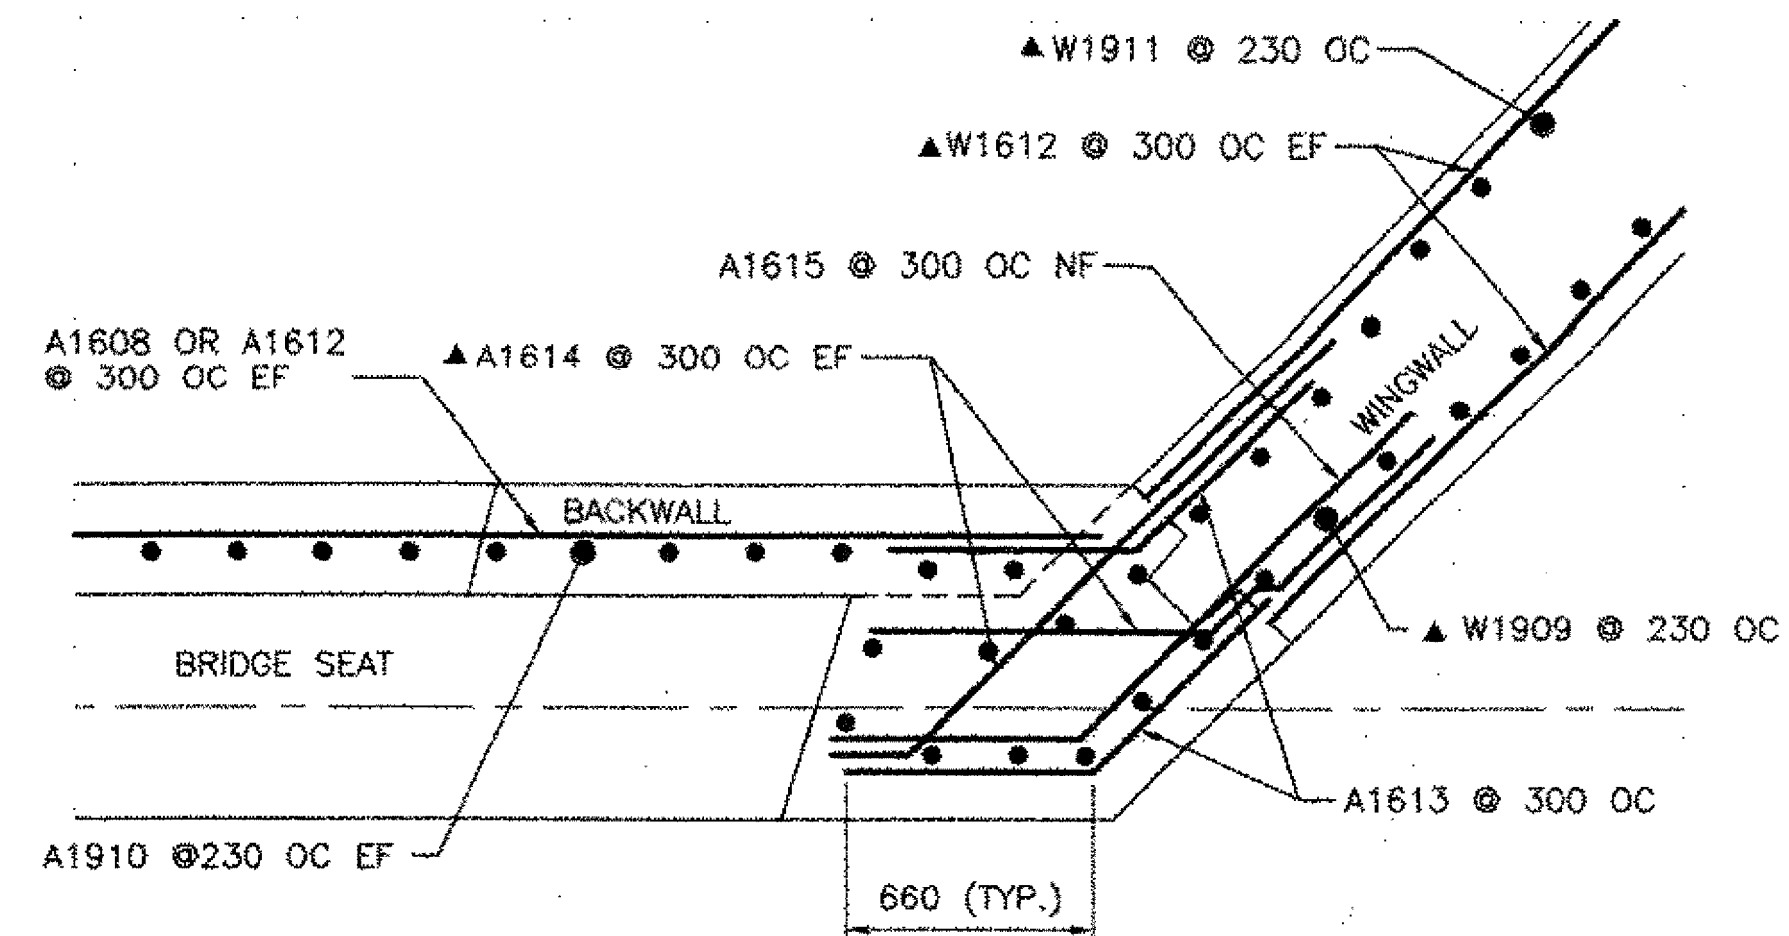


TYPICAL CORNER DETAIL ABUTMENT NO 1
ABOVE BRIDGE SEAT
SCALE 1:20

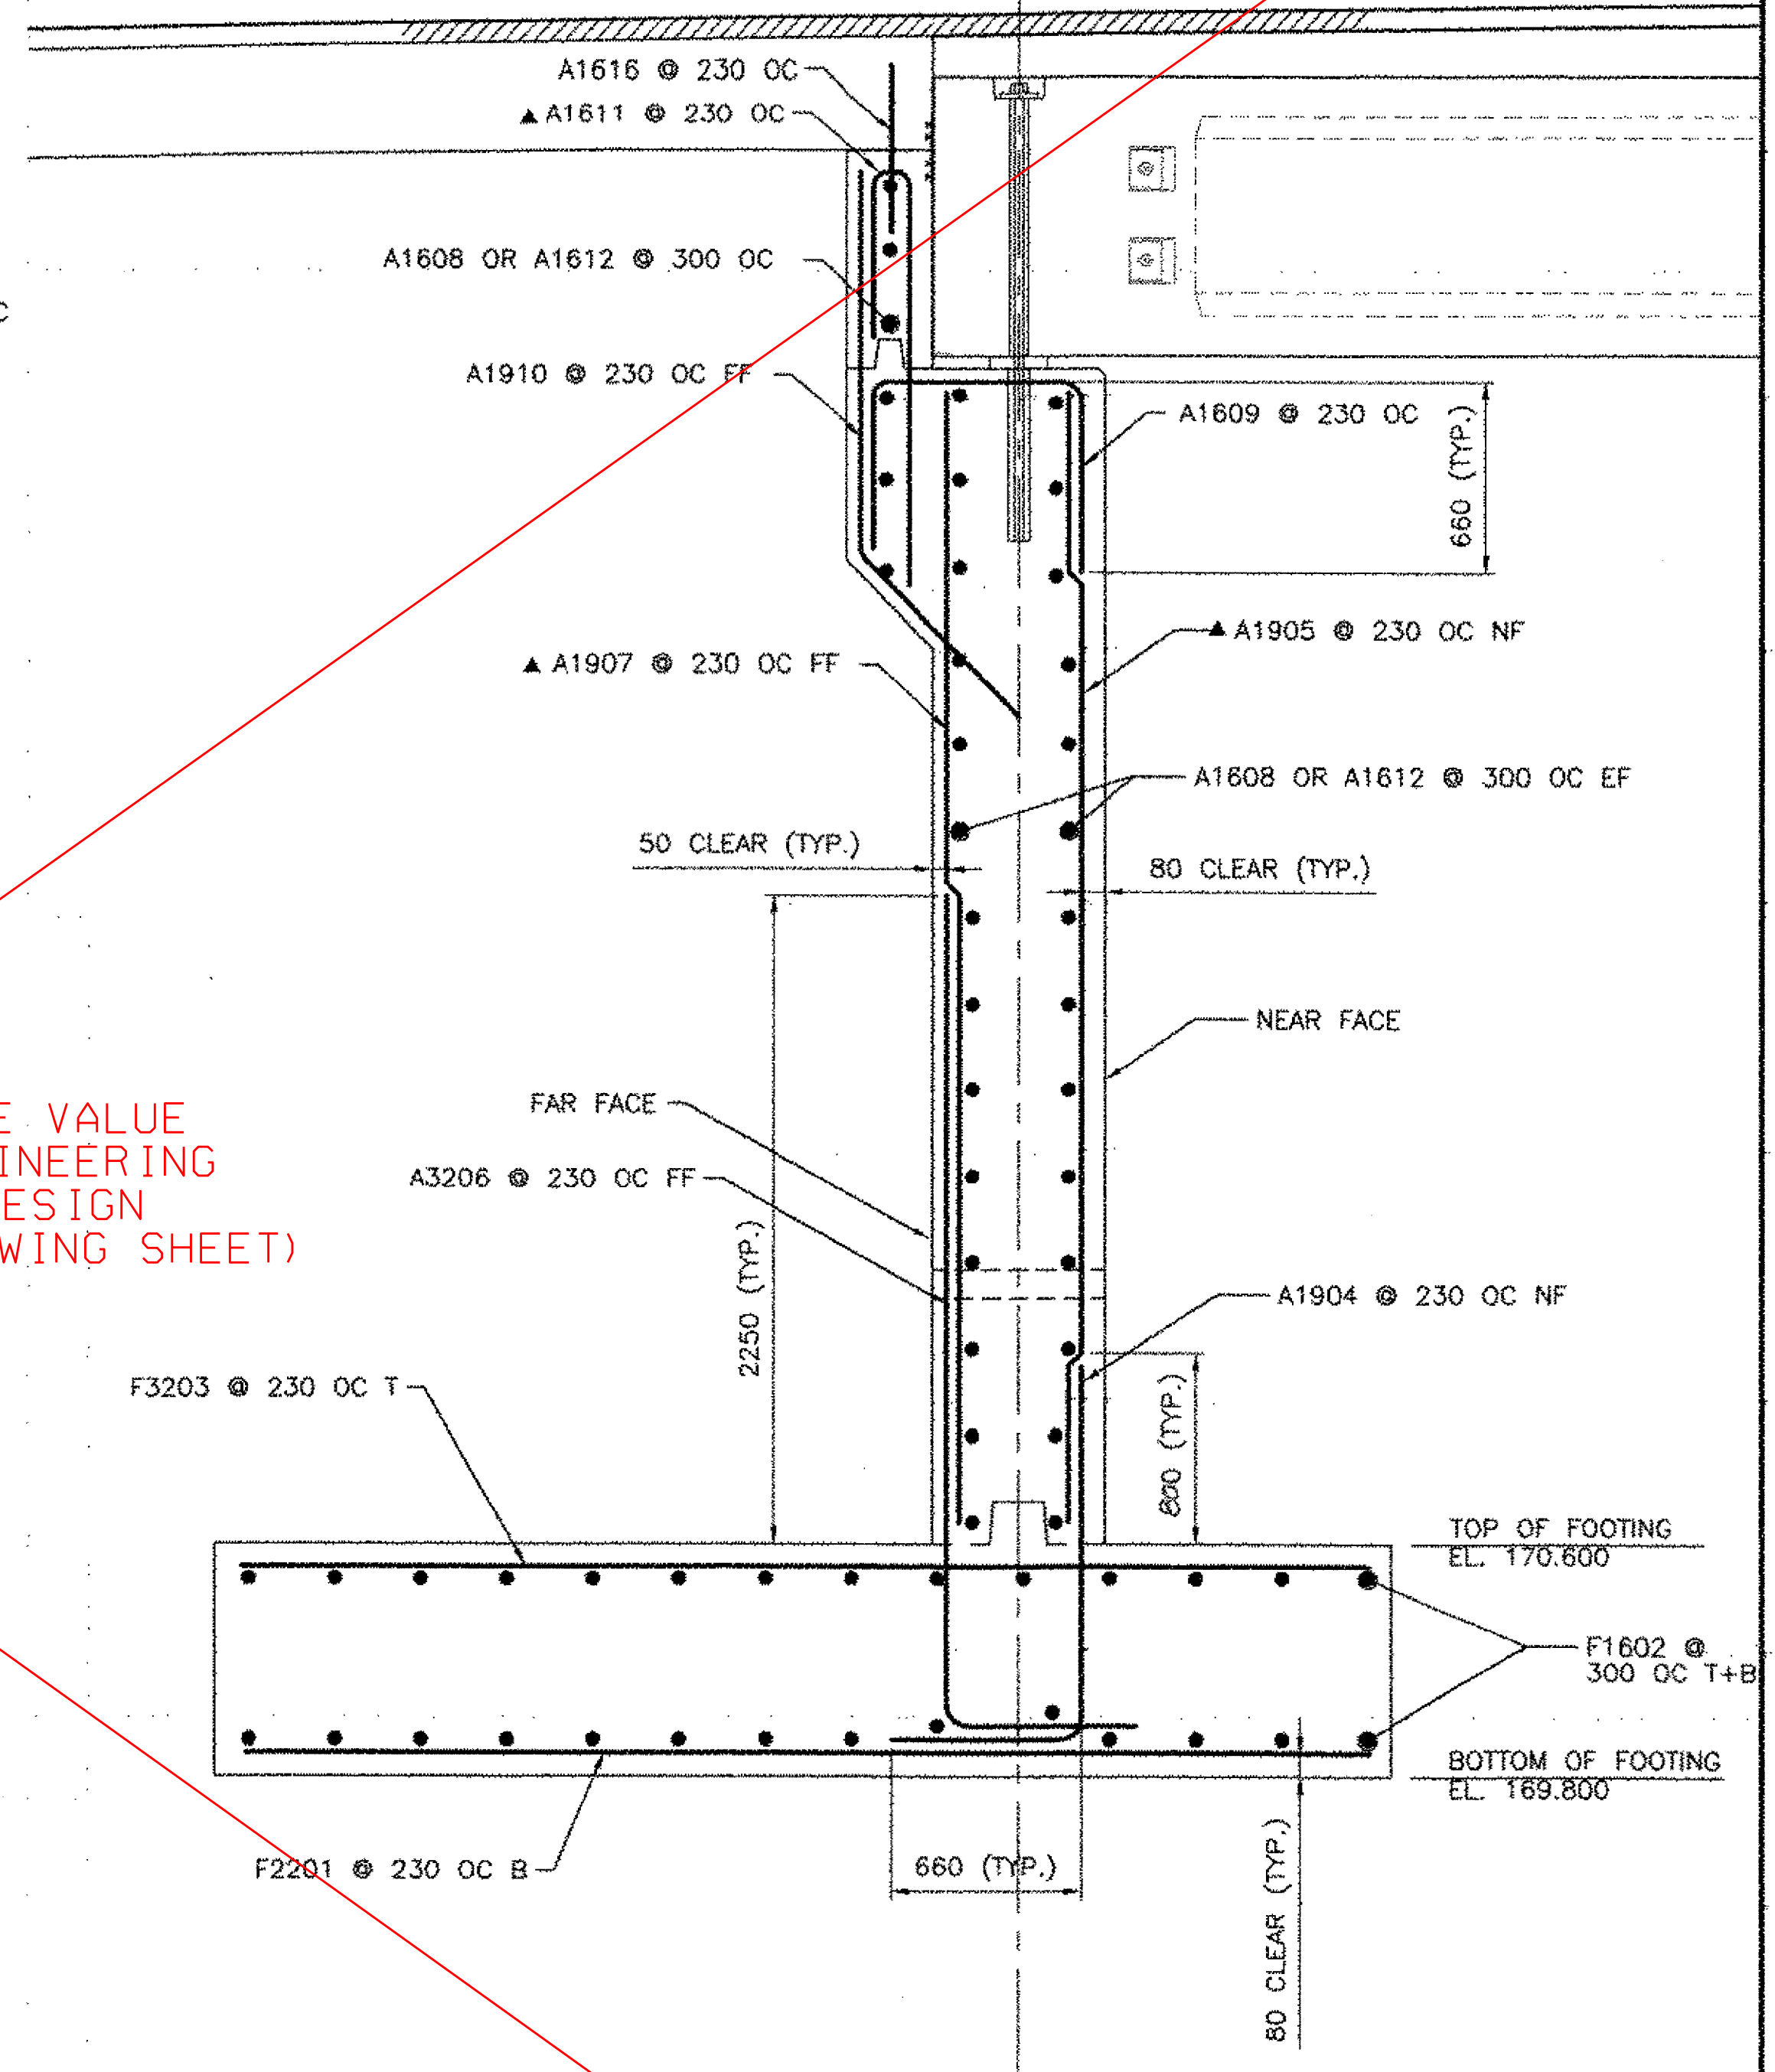

ABUTMENT NO. 1 SECTION
SCALE 1:20

SEE VALUE
ENGINEERING
DESIGN
(FOLLOWING SHEET)

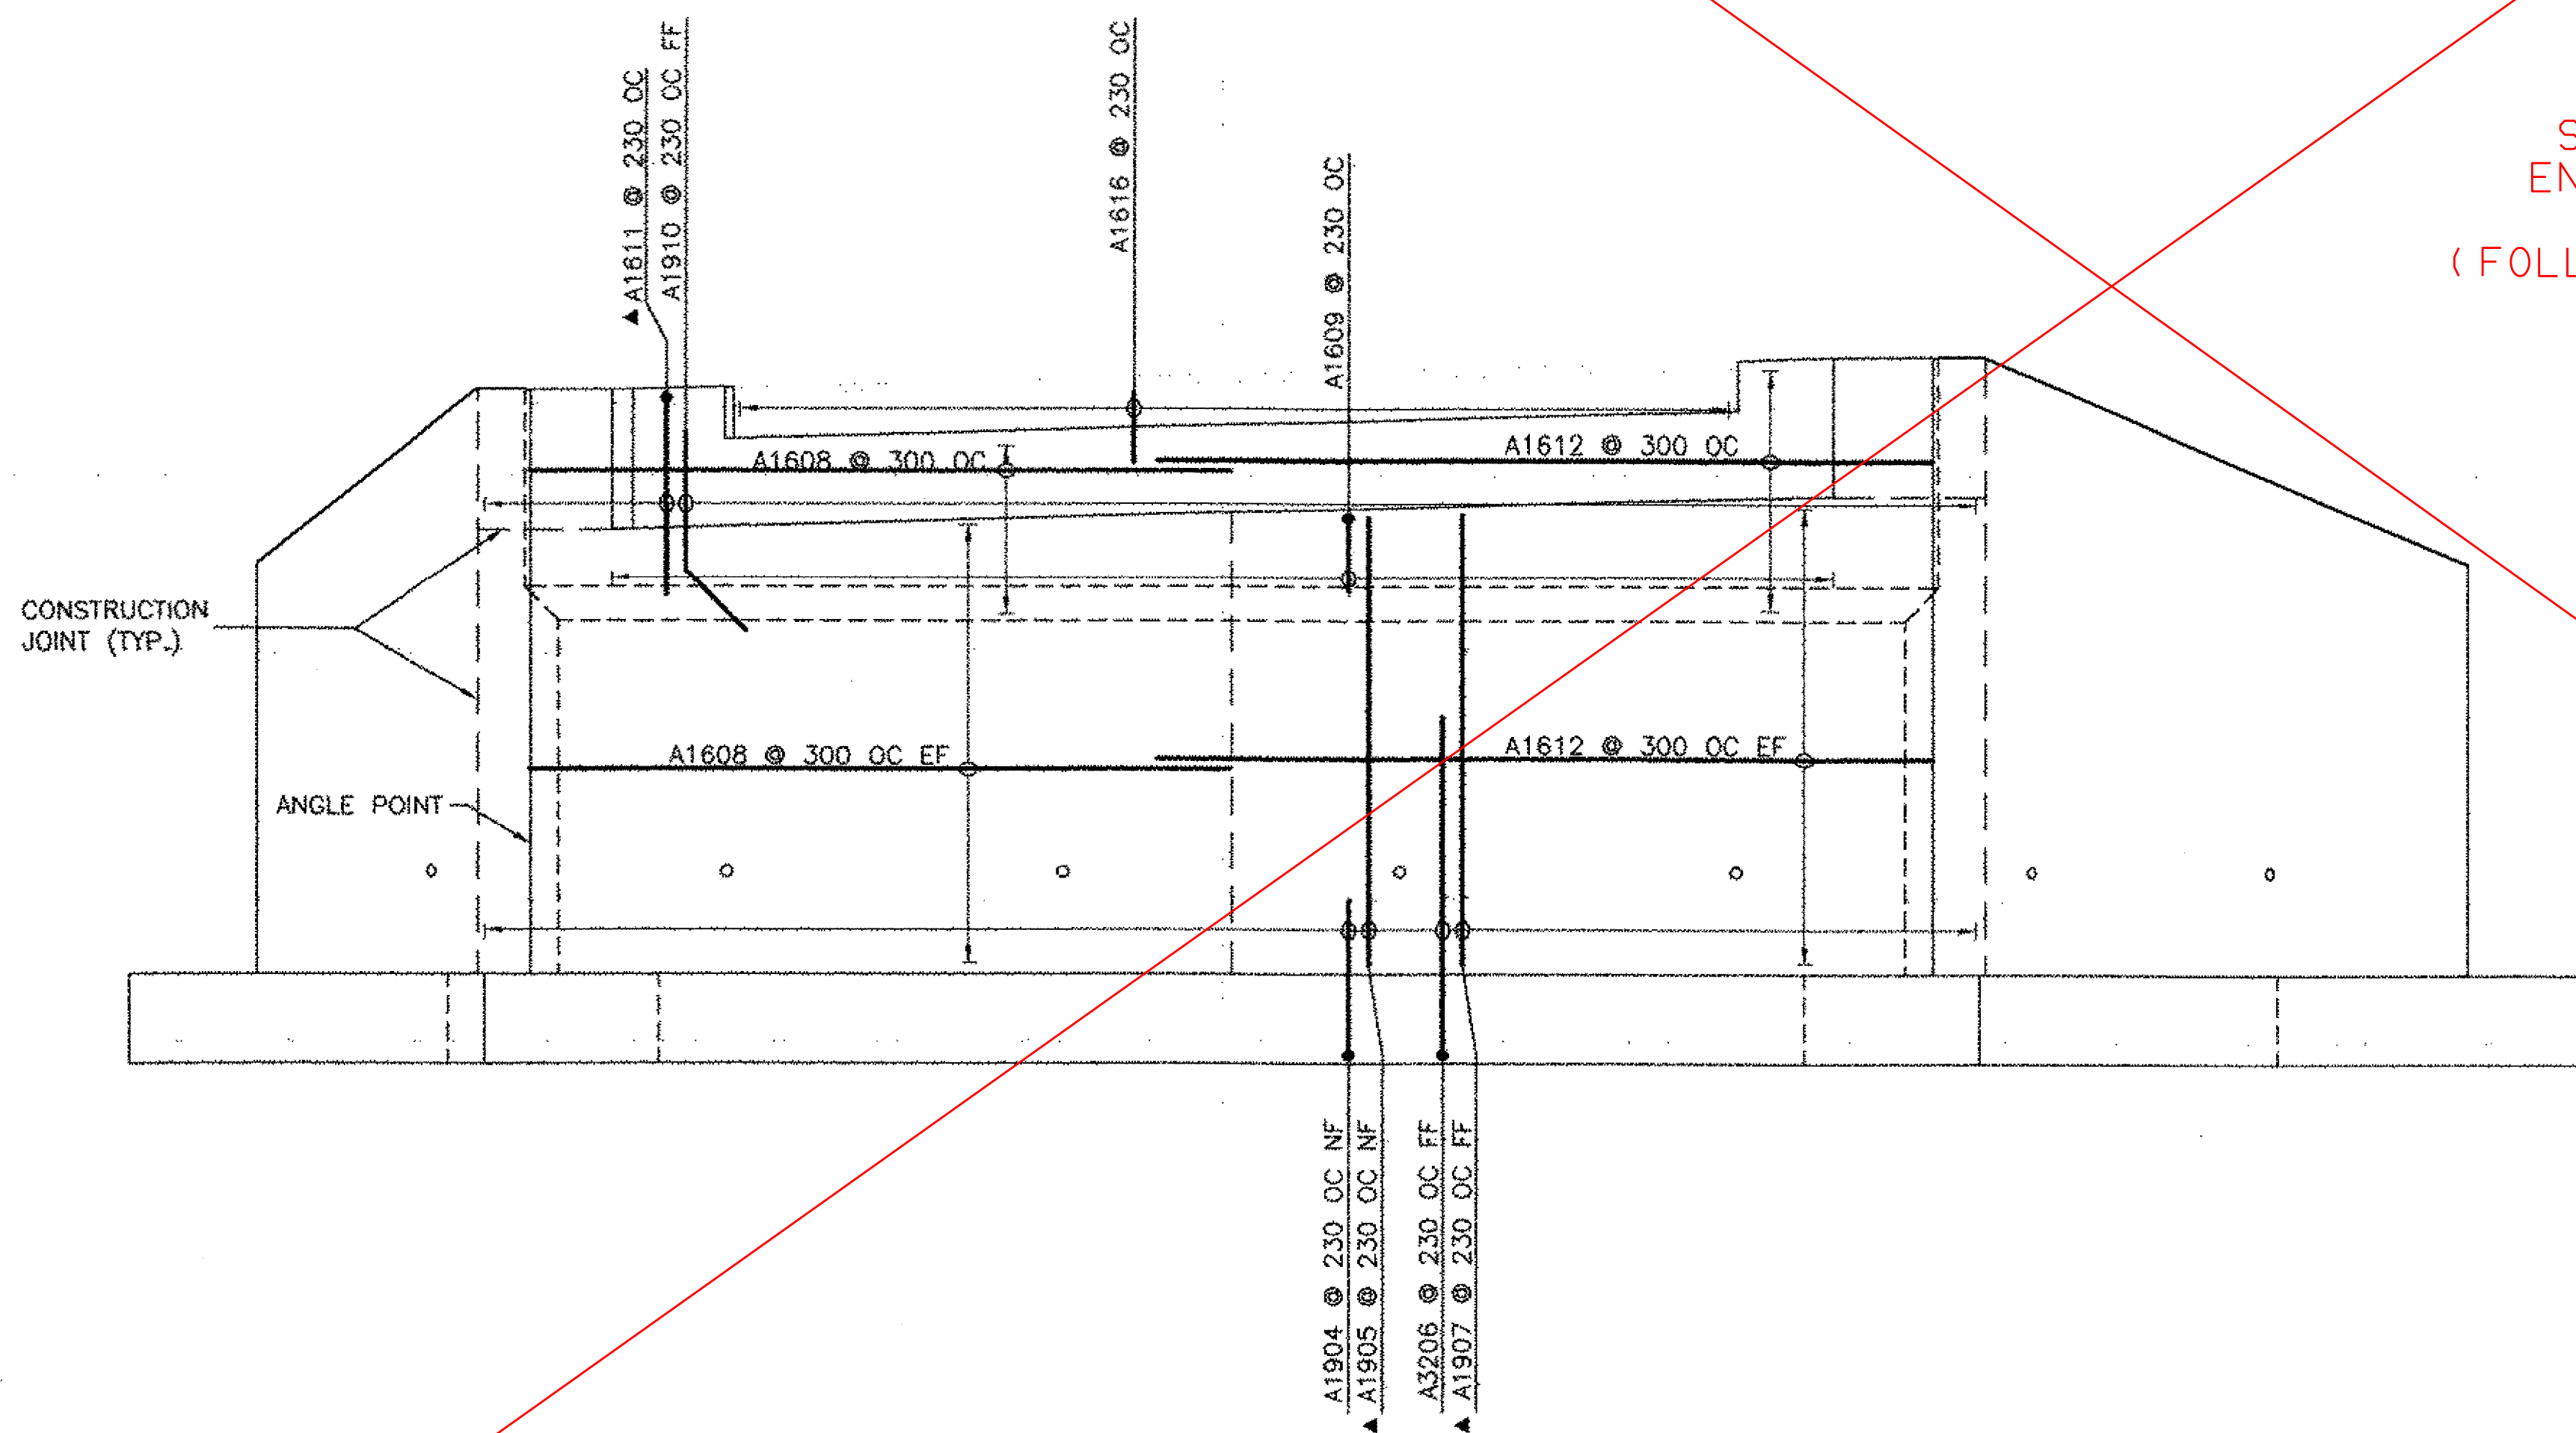

ELEVATION
SCALE 1:50

NOTES:
NF = NEAR FACE
FF = FAR FACE
EF = EACH FACE
▲ = CUT TO FIT IN FIELD
T+B = TOP AND BOTTOM
OC = ON CENTER
MINIMUM LAP LENGTH NOT DETAILED SHALL BE 660

REVISIONS			STATE OF VERMONT AGENCY OF TRANSPORTATION	
NO.	DESCRIPTION	BY & DATE	CLARENDON, VERMONT	Bridge No. 14
			TOWN HIGHWAY NO. 1	Log Sta.
				Surv. Sta.
			TOWN HIGHWAY NO. 1 OVER THE COLD RIVER	
			ABUTMENT NO. 1 REINFORCING	
			Designed by: B. C. AUSTIN	Drawn by: E. B. SMALL
			Checked by: K. S. MARSHIA date 05/02	Bridge Design Supervisor J.W. TUCKER date 05/02
			PROJECT CLARENDON	PROJECT NO. BRO 1443(29)
			Bridge Sheet No.	SHEET 24 OF 41

