



PLAN
SCALE 1:50

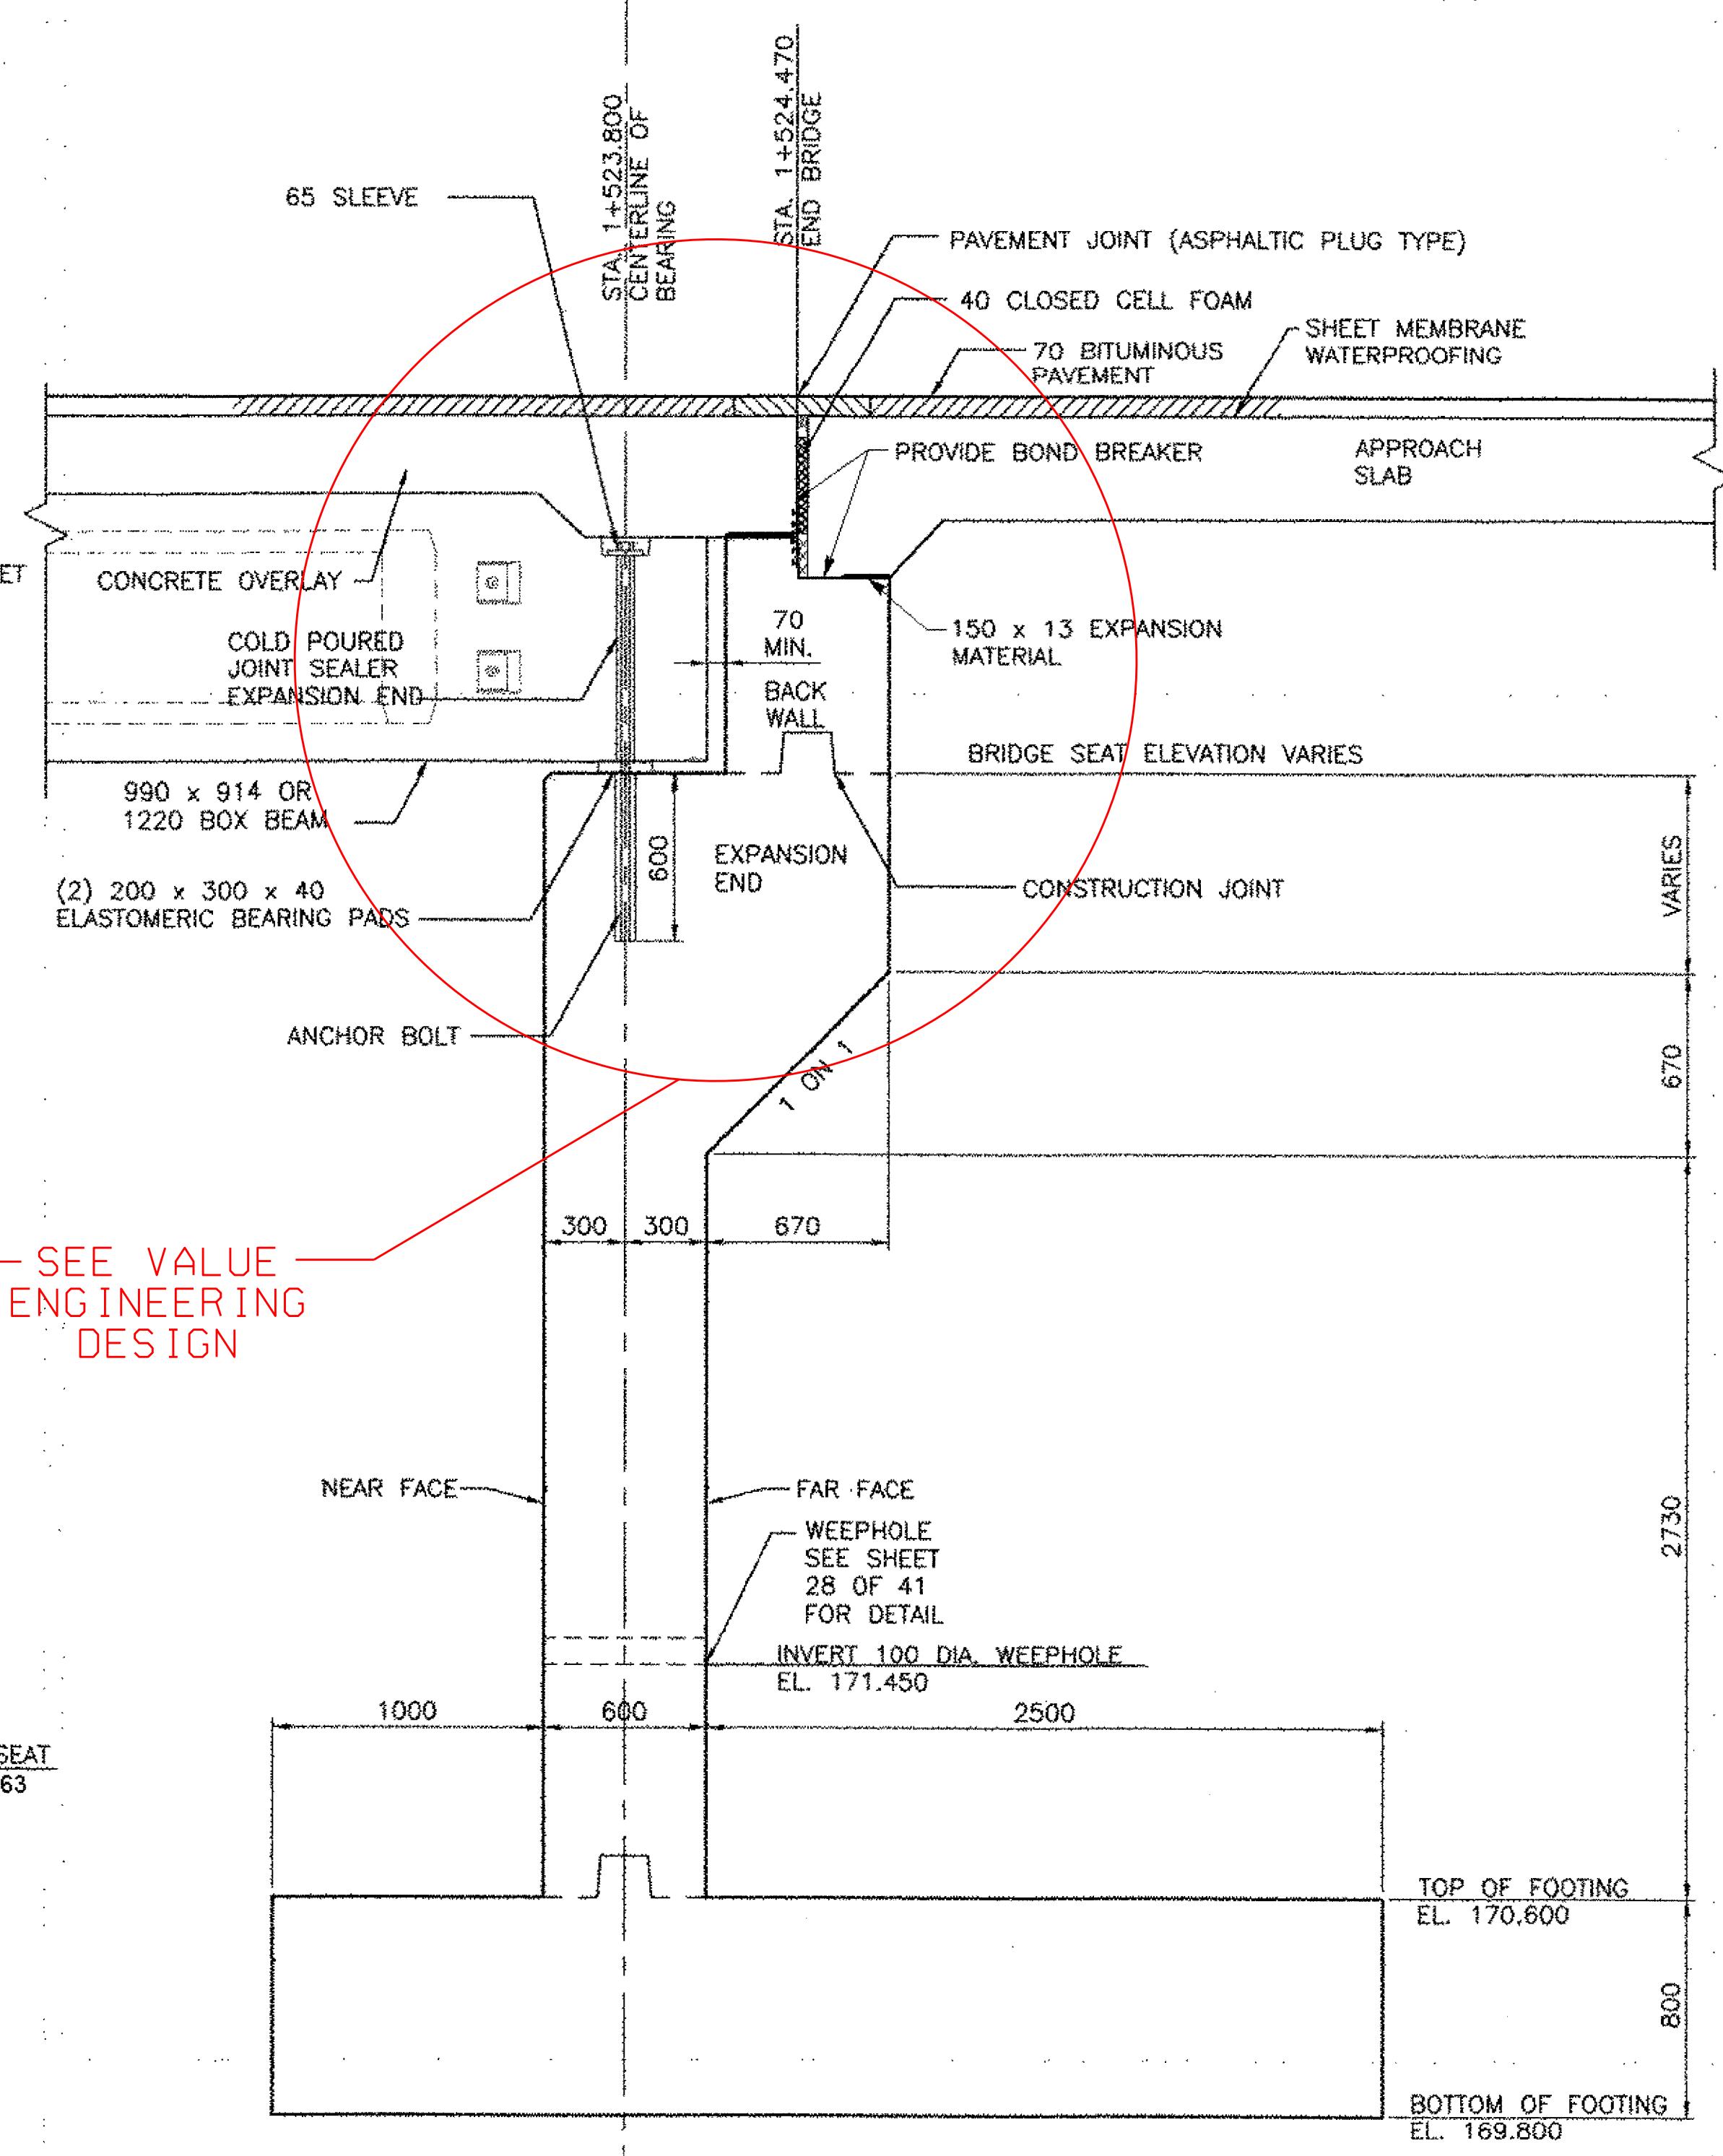

ABUTMENT NO. 2 SECTION
SCALE 1:20

SEE VALUE
ENGINEERING
DESIGN

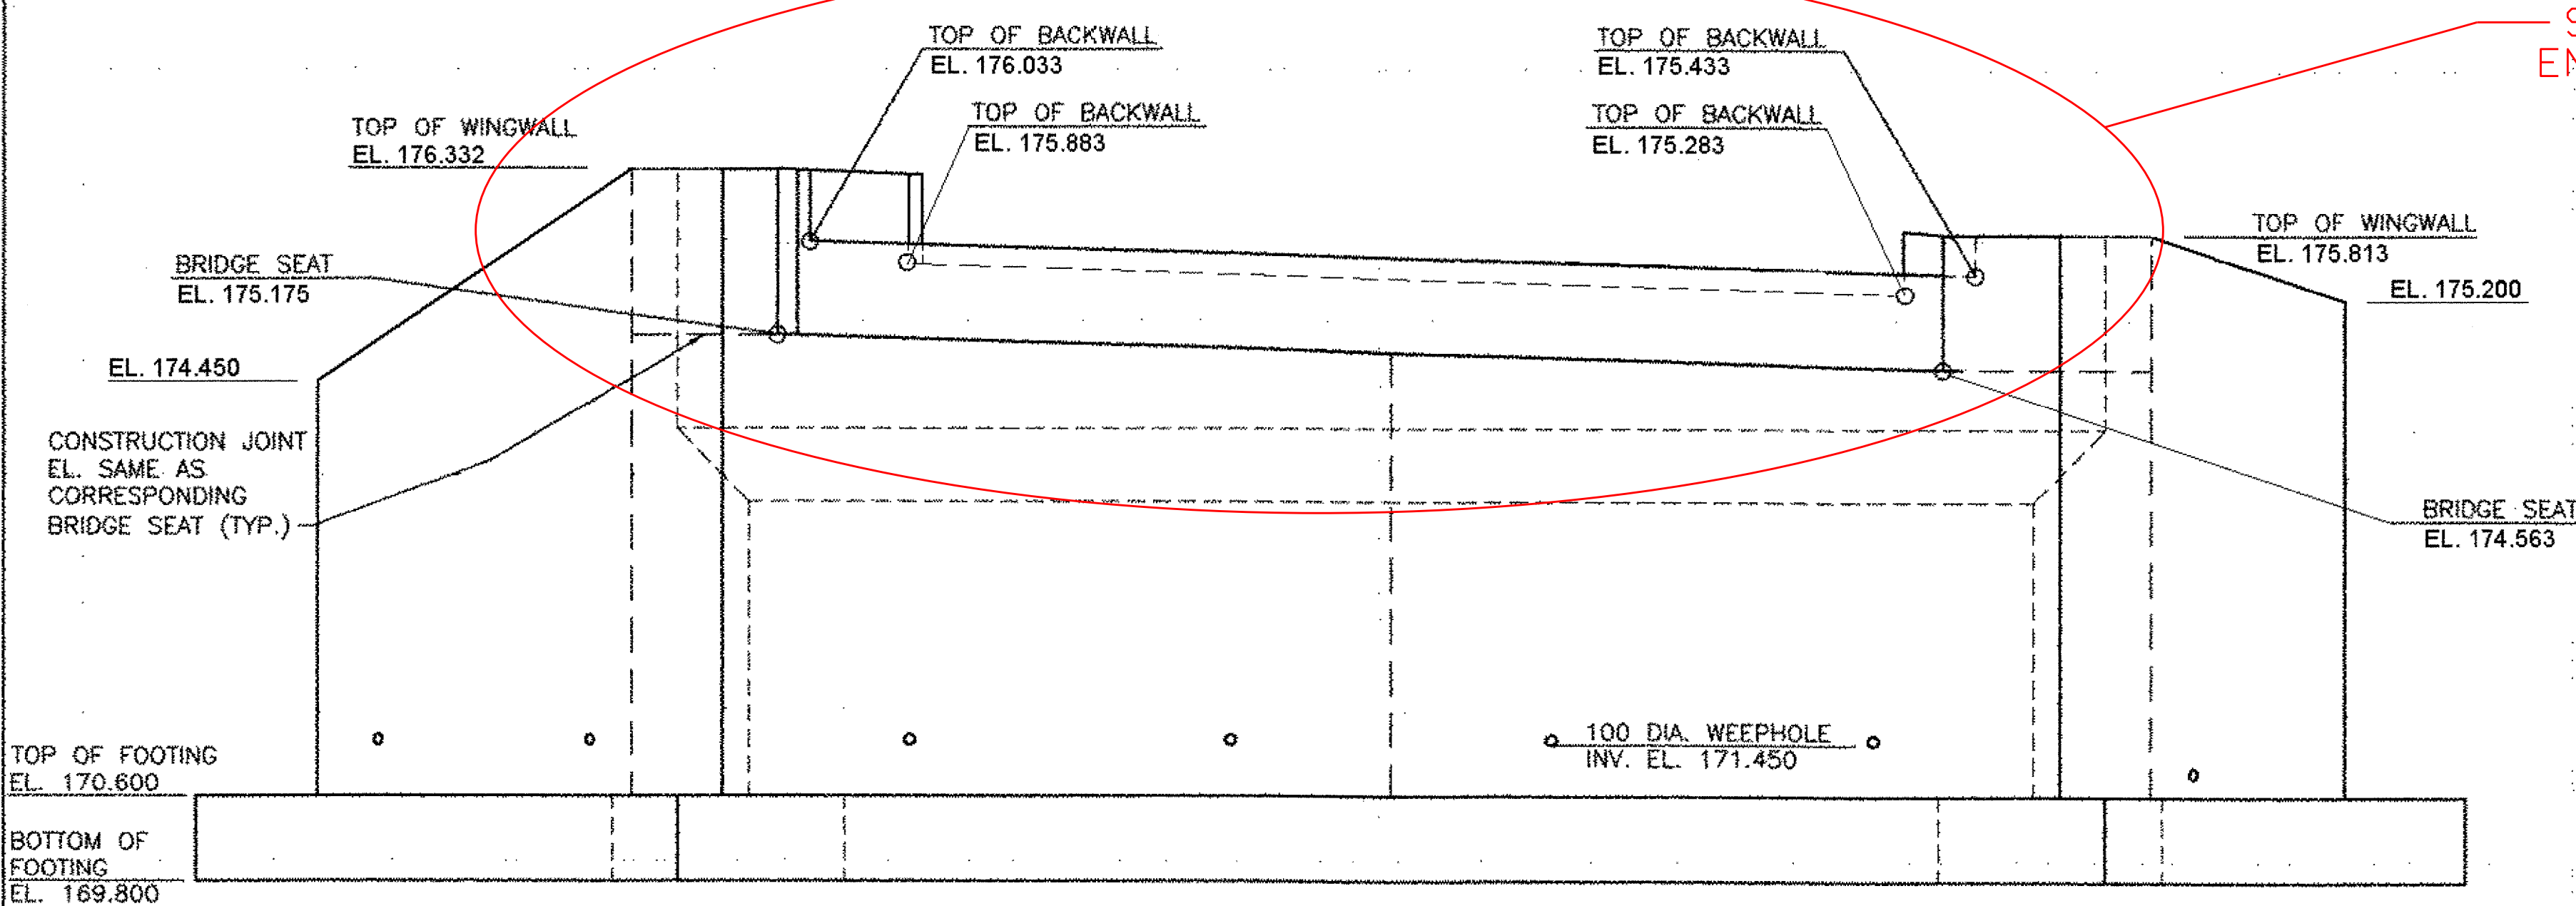

ELEVATION
SCALE 1:50

REVISIONS		STATE OF VERMONT AGENCY OF TRANSPORTATION
NO.	DESCRIPTION	
		CLARENDON, VERMONT
		TOWN HIGHWAY NO. 1
		CLARENDON, VERMONT
		CLARENDON
		Bridge No. 14
		Log Sta.
		Surv. Sta.
		TOWN HIGHWAY NO. 1 OVER THE COLD RIVER
		ABUTMENT NO. 2 MASONRY
		Designed by: B. C. AUSTIN
		Drawn by: E. B. SMALL
		Checked by: K. S. MARSHIA date 05/02
		Bridge Design Supervisor: J.W. TUCKER date 05/02
		PROJECT NO. BRO 1443(29)
		Bridge Sheet No. SHEET 25 OF 41