


SEE CALCULATIONS FILE IN ONBASE FOR FINAL CROSS SECTIONS

ROADWAY CROSS SECTIONS

SCALE: HORIZ. 1:100
VERT. 1:100

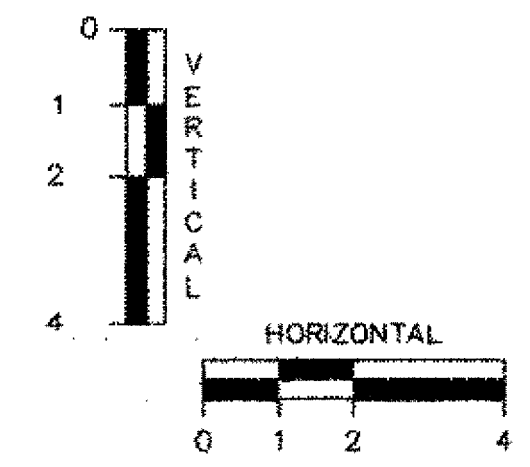

REVISIONS		STATE OF VERMONT AGENCY OF TRANSPORTATION
NO.	DESCRIPTION	
		CLARENDON, VERMONT
		TOWN HIGHWAY NO. 1
		TOWN HIGHWAY NO. 1 OVER THE COLD RIVER
		ROADWAY CROSS SECTIONS
		Designed by: W.S. CHESBROUGH
		Checked by: K. S. MARSHIA date 05/02
		PROJECT CLARENDON
		Bridge No. 14
		Log Sta.
		Surv. Sta.
		Drawn by: N.B. DIMICK
		Bridge Design Supervisor J.W. TUCKER date 05/02
		PROJECT NO. BRO 1443(29)
		Bridge Sheet No. SHEET 35 OF 41



engineering planning management development