


ROADWAY CROSS SECTIONS

SCALE: HORIZ. 1:100
VERT. 1:100

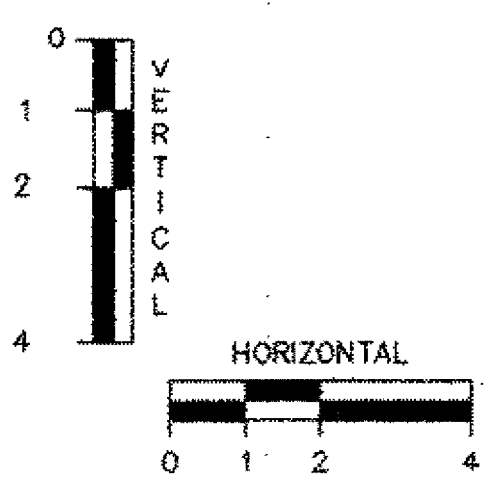

SEE CALCULATIONS FILE
IN ONBASE FOR FINAL
CROSS SECTIONS

REVISIONS		
NO.	DESCRIPTION	BY & DATE

STATE OF VERMONT	
AGENCY OF TRANSPORTATION	
CLARENDON, VERMONT	Bridge No. 14
TOWN HIGHWAY NO. 1	Log Sta.
TOWN HIGHWAY NO. 1 OVER THE COLD RIVER	
ROADWAY CROSS SECTIONS	
Designed by: W.S. CHESBROUGH	Drawn by: N.B. DIMICK
Checked by: K.S. MARSHIA date 05/02	Bridge Design Supervisor J.W. TUCKER date 05/02
PROJECT CLARENDON	PROJECT NO. BRO 1443(29)
Bridge Sheet No.	SHEET 36 OF 41

