


SEE CALCULATIONS FILE IN ONBASE FOR FINAL CROSS SECTIONS

ROADWAY CROSS SECTIONS
SCALE: HORIZ. 1:100
VERT. 1:100

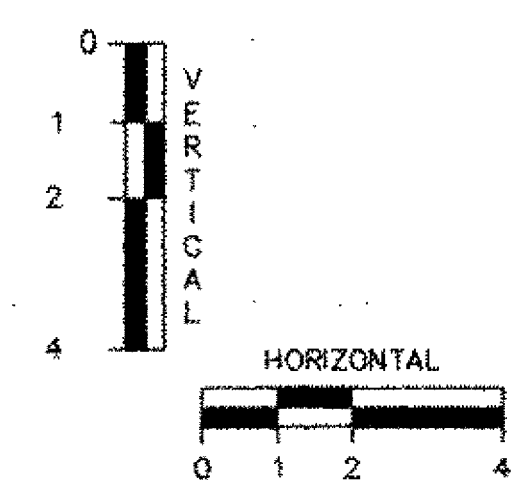

REVISIONS		STATE OF VERMONT AGENCY OF TRANSPORTATION	
NO.	DESCRIPTION	BY & DATE	
			CLARENDON, VERMONT TOWN HIGHWAY NO. 1
			Bridge No. 14 Log Sta. Surv. Sta.
TOWN HIGHWAY NO. 1 OVER THE COLD RIVER			
ROADWAY CROSS SECTIONS			
Designed by: W.S. CHESBROUGH		Drawn by: N.B. DIMICK	
Checked by: K.S. MARSHIA date 05/02		Bridge Design Supervisor J.W. TUCKER date 05/02	
PROJECT CLARENDON		PROJECT NO. BRO 1443(29)	
Bridge Sheet No.		SHEET 37 OF 41	

