

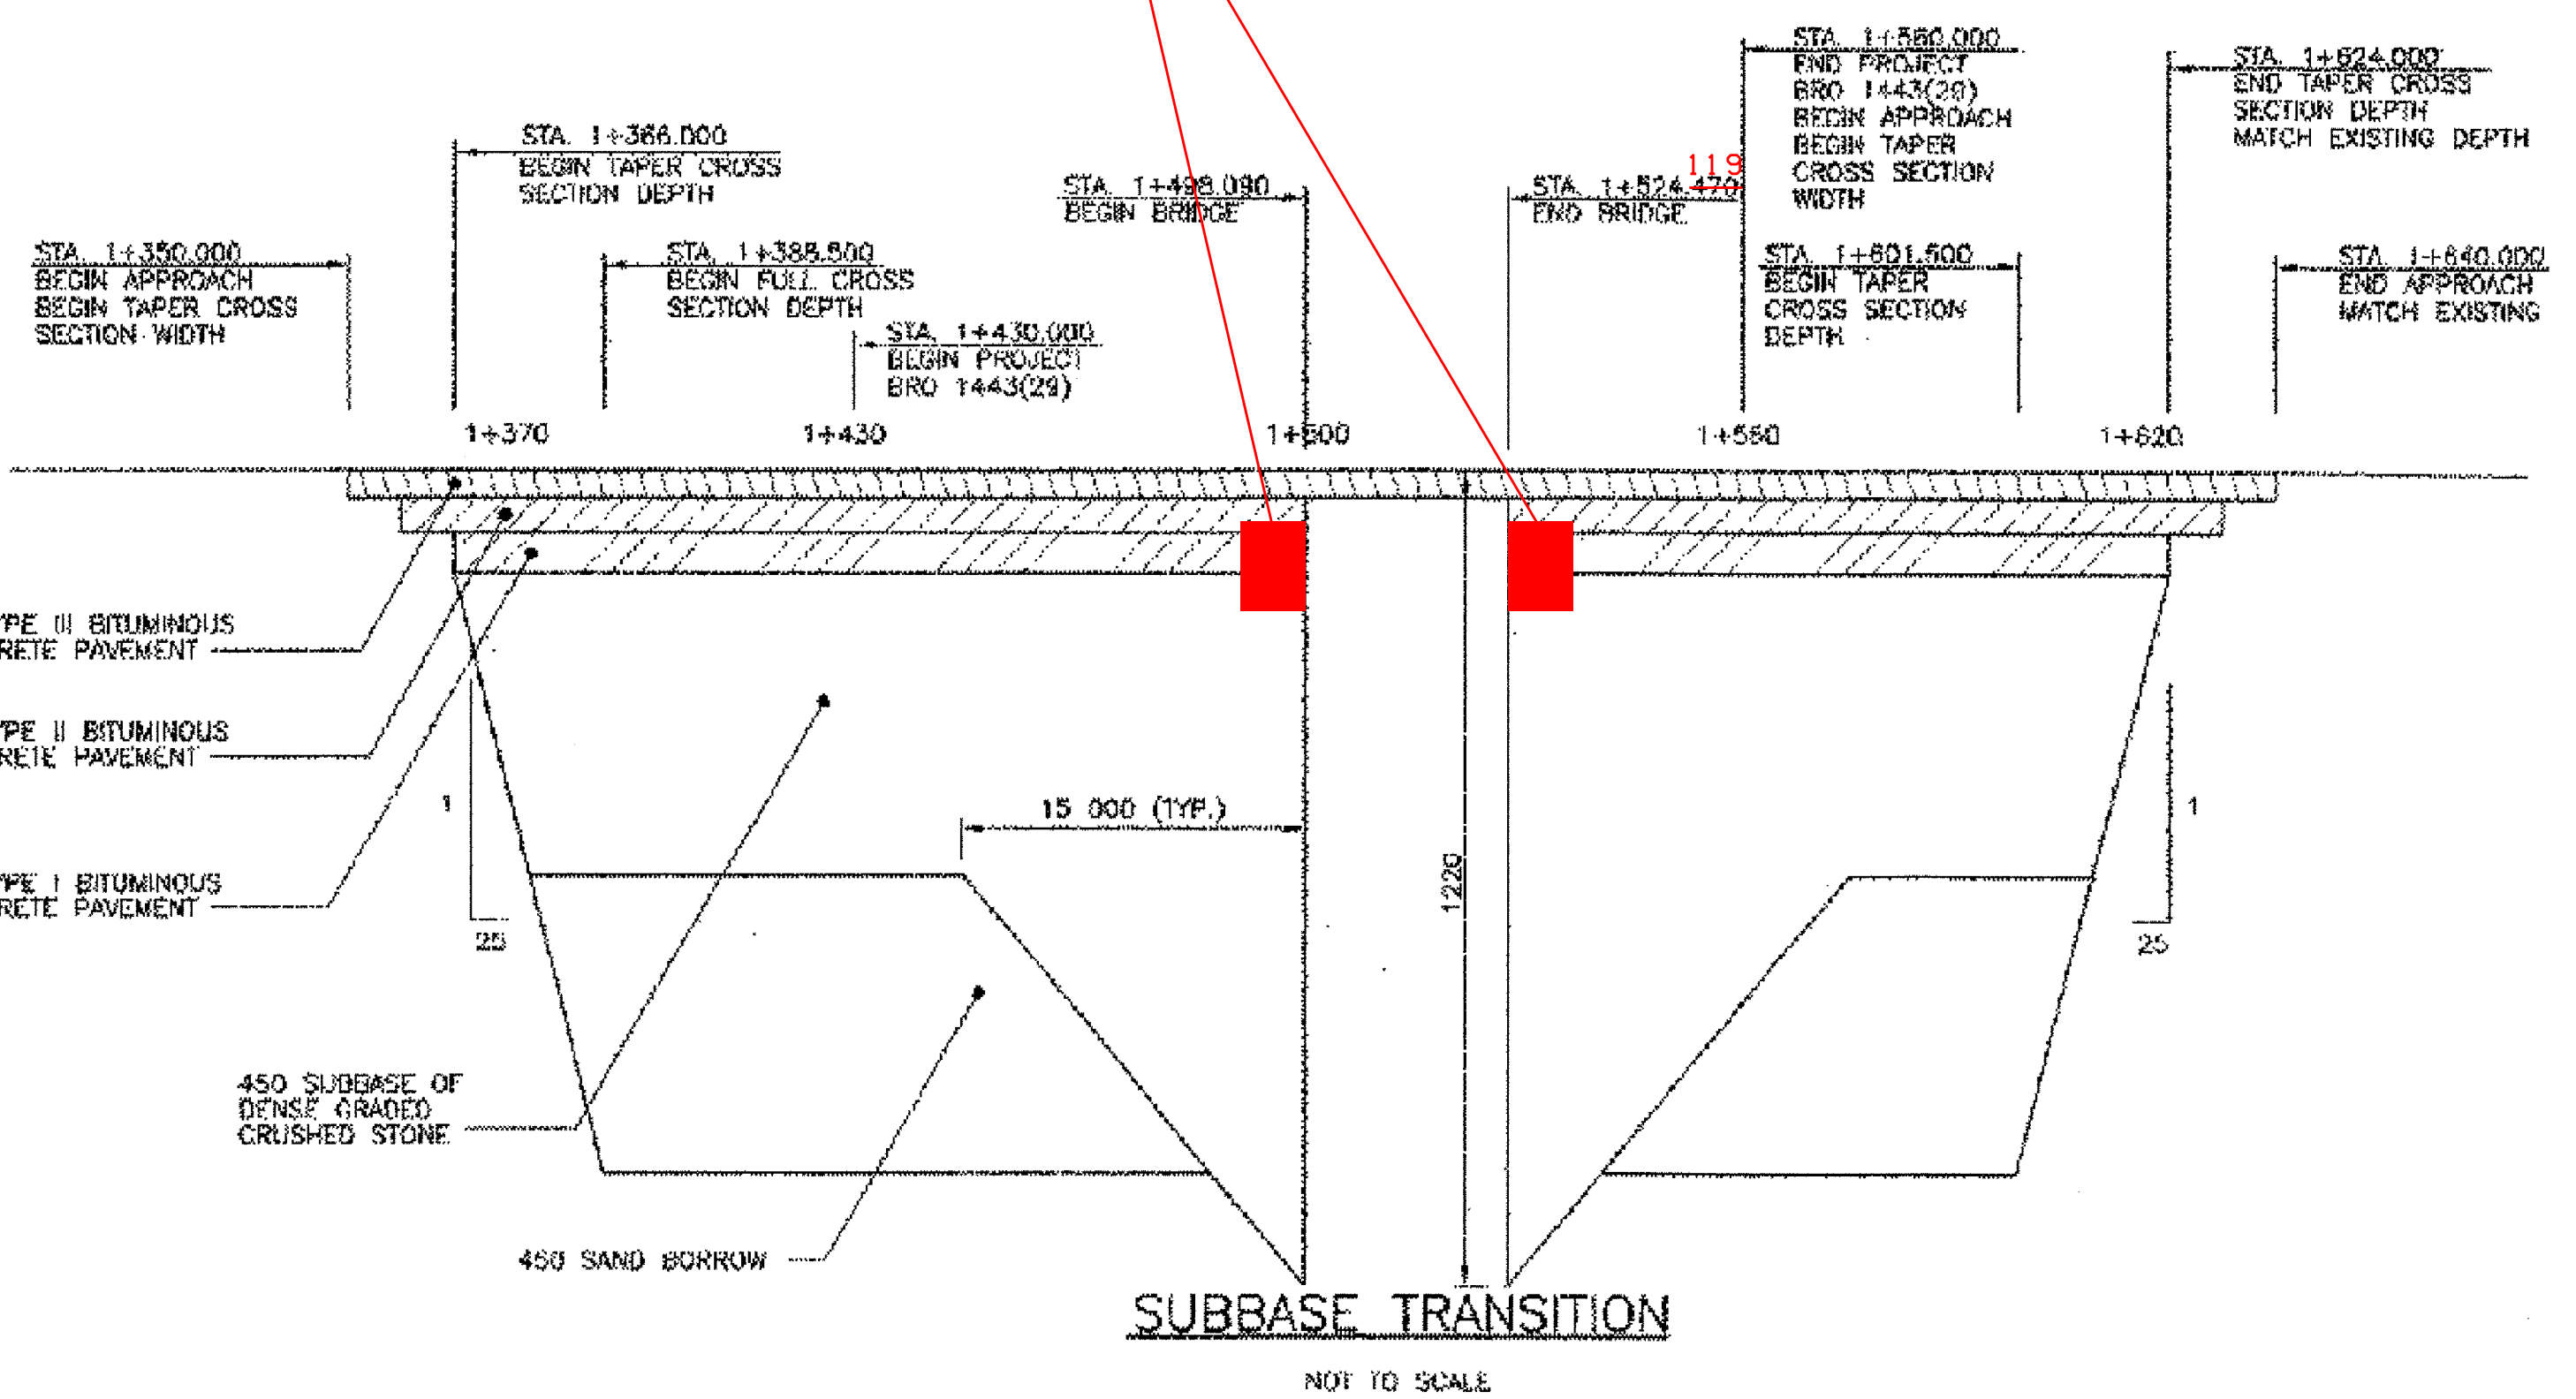


**BANKING DIAGRAM**  
SCALE: HORIZ. 1:100  
VERT. 0.01 M/M

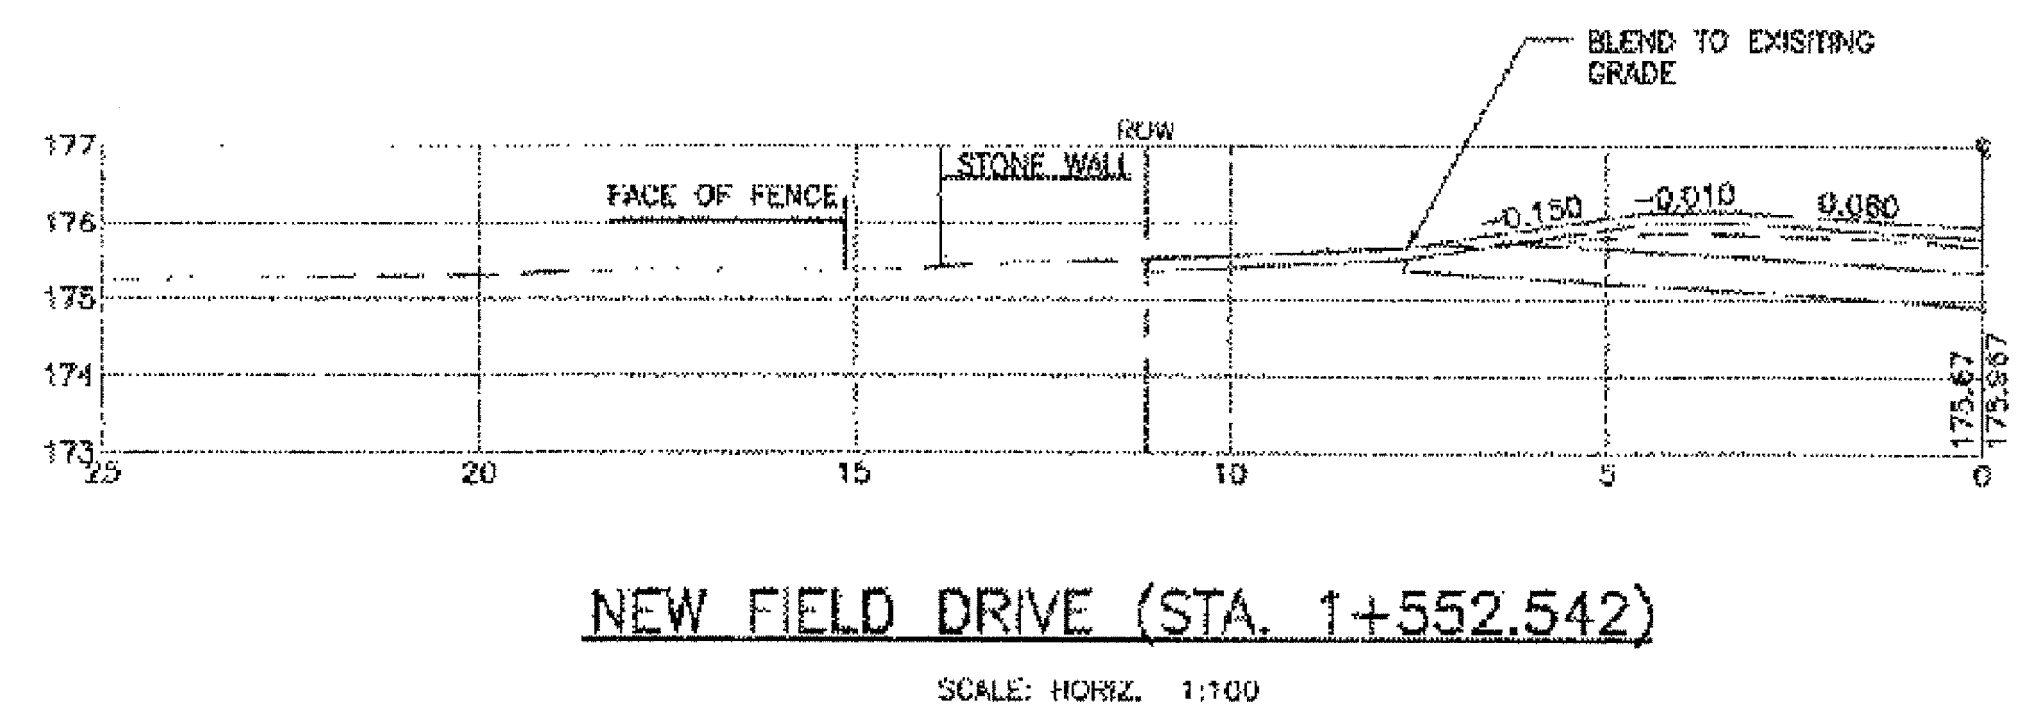

REVISIONS		STATE OF VERMONT AGENCY OF TRANSPORTATION	
NO.	DESCRIPTION	BY & DATE	
			CLARENDON, VERMONT
			Bridge No. 14
			Town Highway No. 1
			Log Sta.
			Surv. Sta.
			TOWN HIGHWAY NO. 1 OVER THE GOLD RIVER
			BANKING DIAGRAM AND PAVEMENT TRANSITION
		Designed by: W.S. CHESBROUGH	Drawn by: E.D. SMALL
		Checked by: K.S. MARSHIA date 05/02	Bridge Design Supervisor: J.W. TUCKER date 05/02
		PROJECT: CLARENDON	PROJECT NO.: BRO 1443(29)
		Bridge Sheet No.	SHEET 38 OF 41

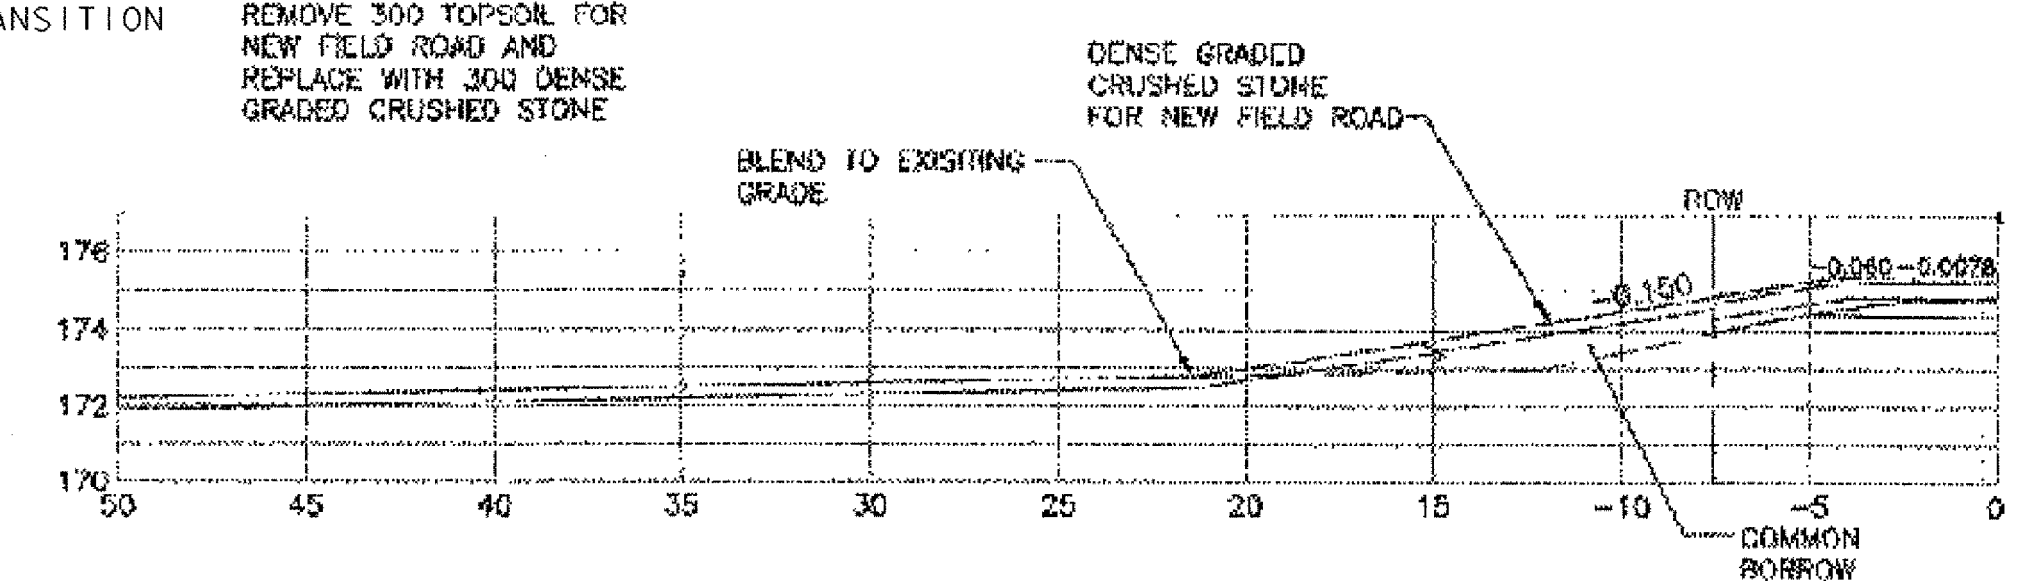