


STA. 0+014.9 LT
END GRUBBING MATERIAL
STA. 0+014.1 RT
END GRUBBING MATERIAL

STA. 0+007.9 LT AND RT
BEGIN UNCLASSIFIED CHANNEL EXCAVATION
BEGIN GEOTEXTILE UNDER STONE FILL
BEGIN STONE FILL TYPE III
BEGIN GRUBBING MATERIAL


SEE CALCULATIONS FILE
IN ONBASE FOR FINAL
CROSS SECTIONS

CHANNEL CROSS SECTIONS

SCALE: HORIZ. 1:100
VERT. 1:100

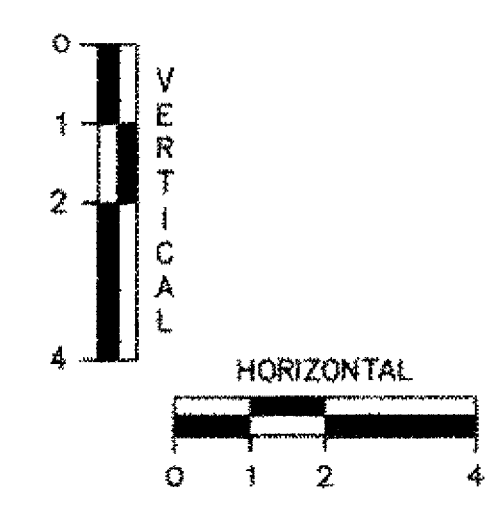

REVISIONS		
NO.	DESCRIPTION	BY & DATE

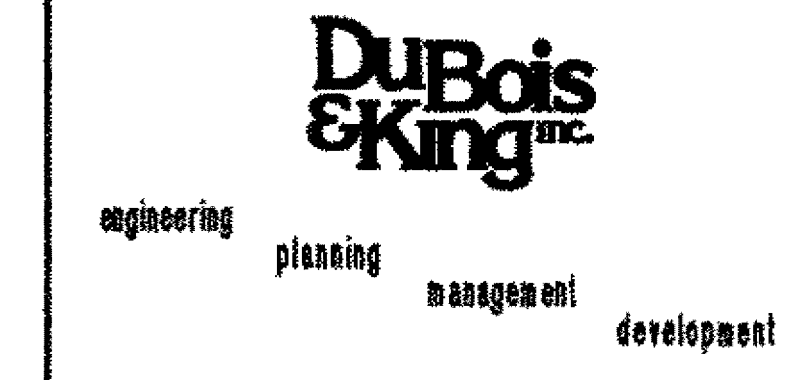

**STATE OF VERMONT
AGENCY OF TRANSPORTATION**

CLARENDON, VERMONT Bridge No. 14

TOWN HIGHWAY NO. 1 Log Sta.

TOWN HIGHWAY NO. 1 OVER THE COLD RIVER Surv. Sta.

CHANNEL CROSS SECTIONS

Designed by: W.S. CHESBROUGH Drawn by: N.B. DIMICK

Checked by: K. S. MARSHIA date 05/02 Bridge Design Supervisor J.W. TUCKER date 05/02

PROJECT: CLARENDON PROJECT NO. BRO 1443(29)

Bridge Sheet No. SHEET 40 of 41