

STA. 0+034.3 RT  
 END UNCLASSIFIED CHANNEL EXCAVATION  
 END GEOTEXTILE UNDER STONE FILL  
 END STONE FILL TYPE III  
 END GRUBBING MATERIAL

STA. 0+029.8 LT  
 END UNCLASSIFIED CHANNEL EXCAVATION  
 END GEOTEXTILE UNDER STONE FILL  
 END STONE FILL TYPE III  
 END GRUBBING MATERIAL


STA. 0+025.1 LT  
 BEGIN GRUBBING MATERIAL

STA. 0+024.2 RT  
 BEGIN GRUBBING MATERIAL

SEE CALCULATIONS FILE  
 IN ONBASE FOR FINAL  
 CROSS SECTIONS

**CHANNEL CROSS SECTIONS**

SCALE: HORIZ. 1:100  
 VERT. 1:100

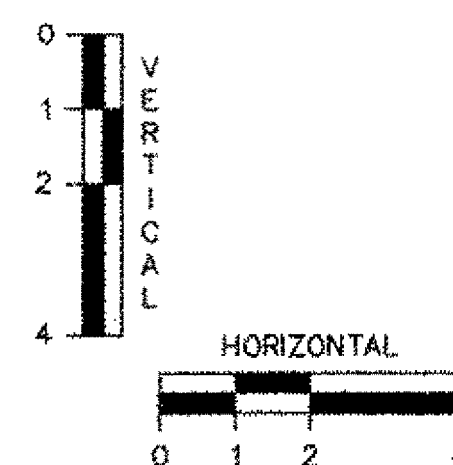

REVISIONS		
NO.	DESCRIPTION	BY & DATE

<b>STATE OF VERMONT</b> <b>AGENCY OF TRANSPORTATION</b>	
CLARENDON, VERMONT	Bridge No. 14
TOWN HIGHWAY NO. 1	Log Sta.
TOWN HIGHWAY NO. 1 OVER THE COLD RIVER	
<b>CHANNEL CROSS SECTIONS</b>	
Designed by: W.S. CHESBROUGH	Drawn by: N.R. DIMICK
Checked by: K. S. MARSHIA date 05/02	Bridge Design Supervisor: J.W. TUCKER date 05/02
PROJECT: CLARENDON	PROJECT NO.: BRO 1443(29)
Bridge Sheet No.	SHEET 41 of 41

