
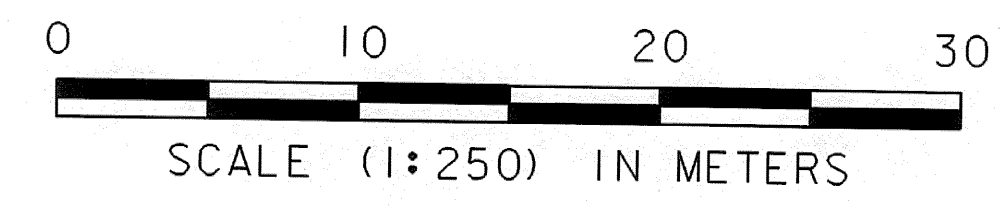


SIDELINE CURVE DATA	
$\Delta$	= 26°-34'-49.7" RT
R	= 100.000
T	= 23.621
L	= 46.392
E	= 2.752
BANK	= NONE

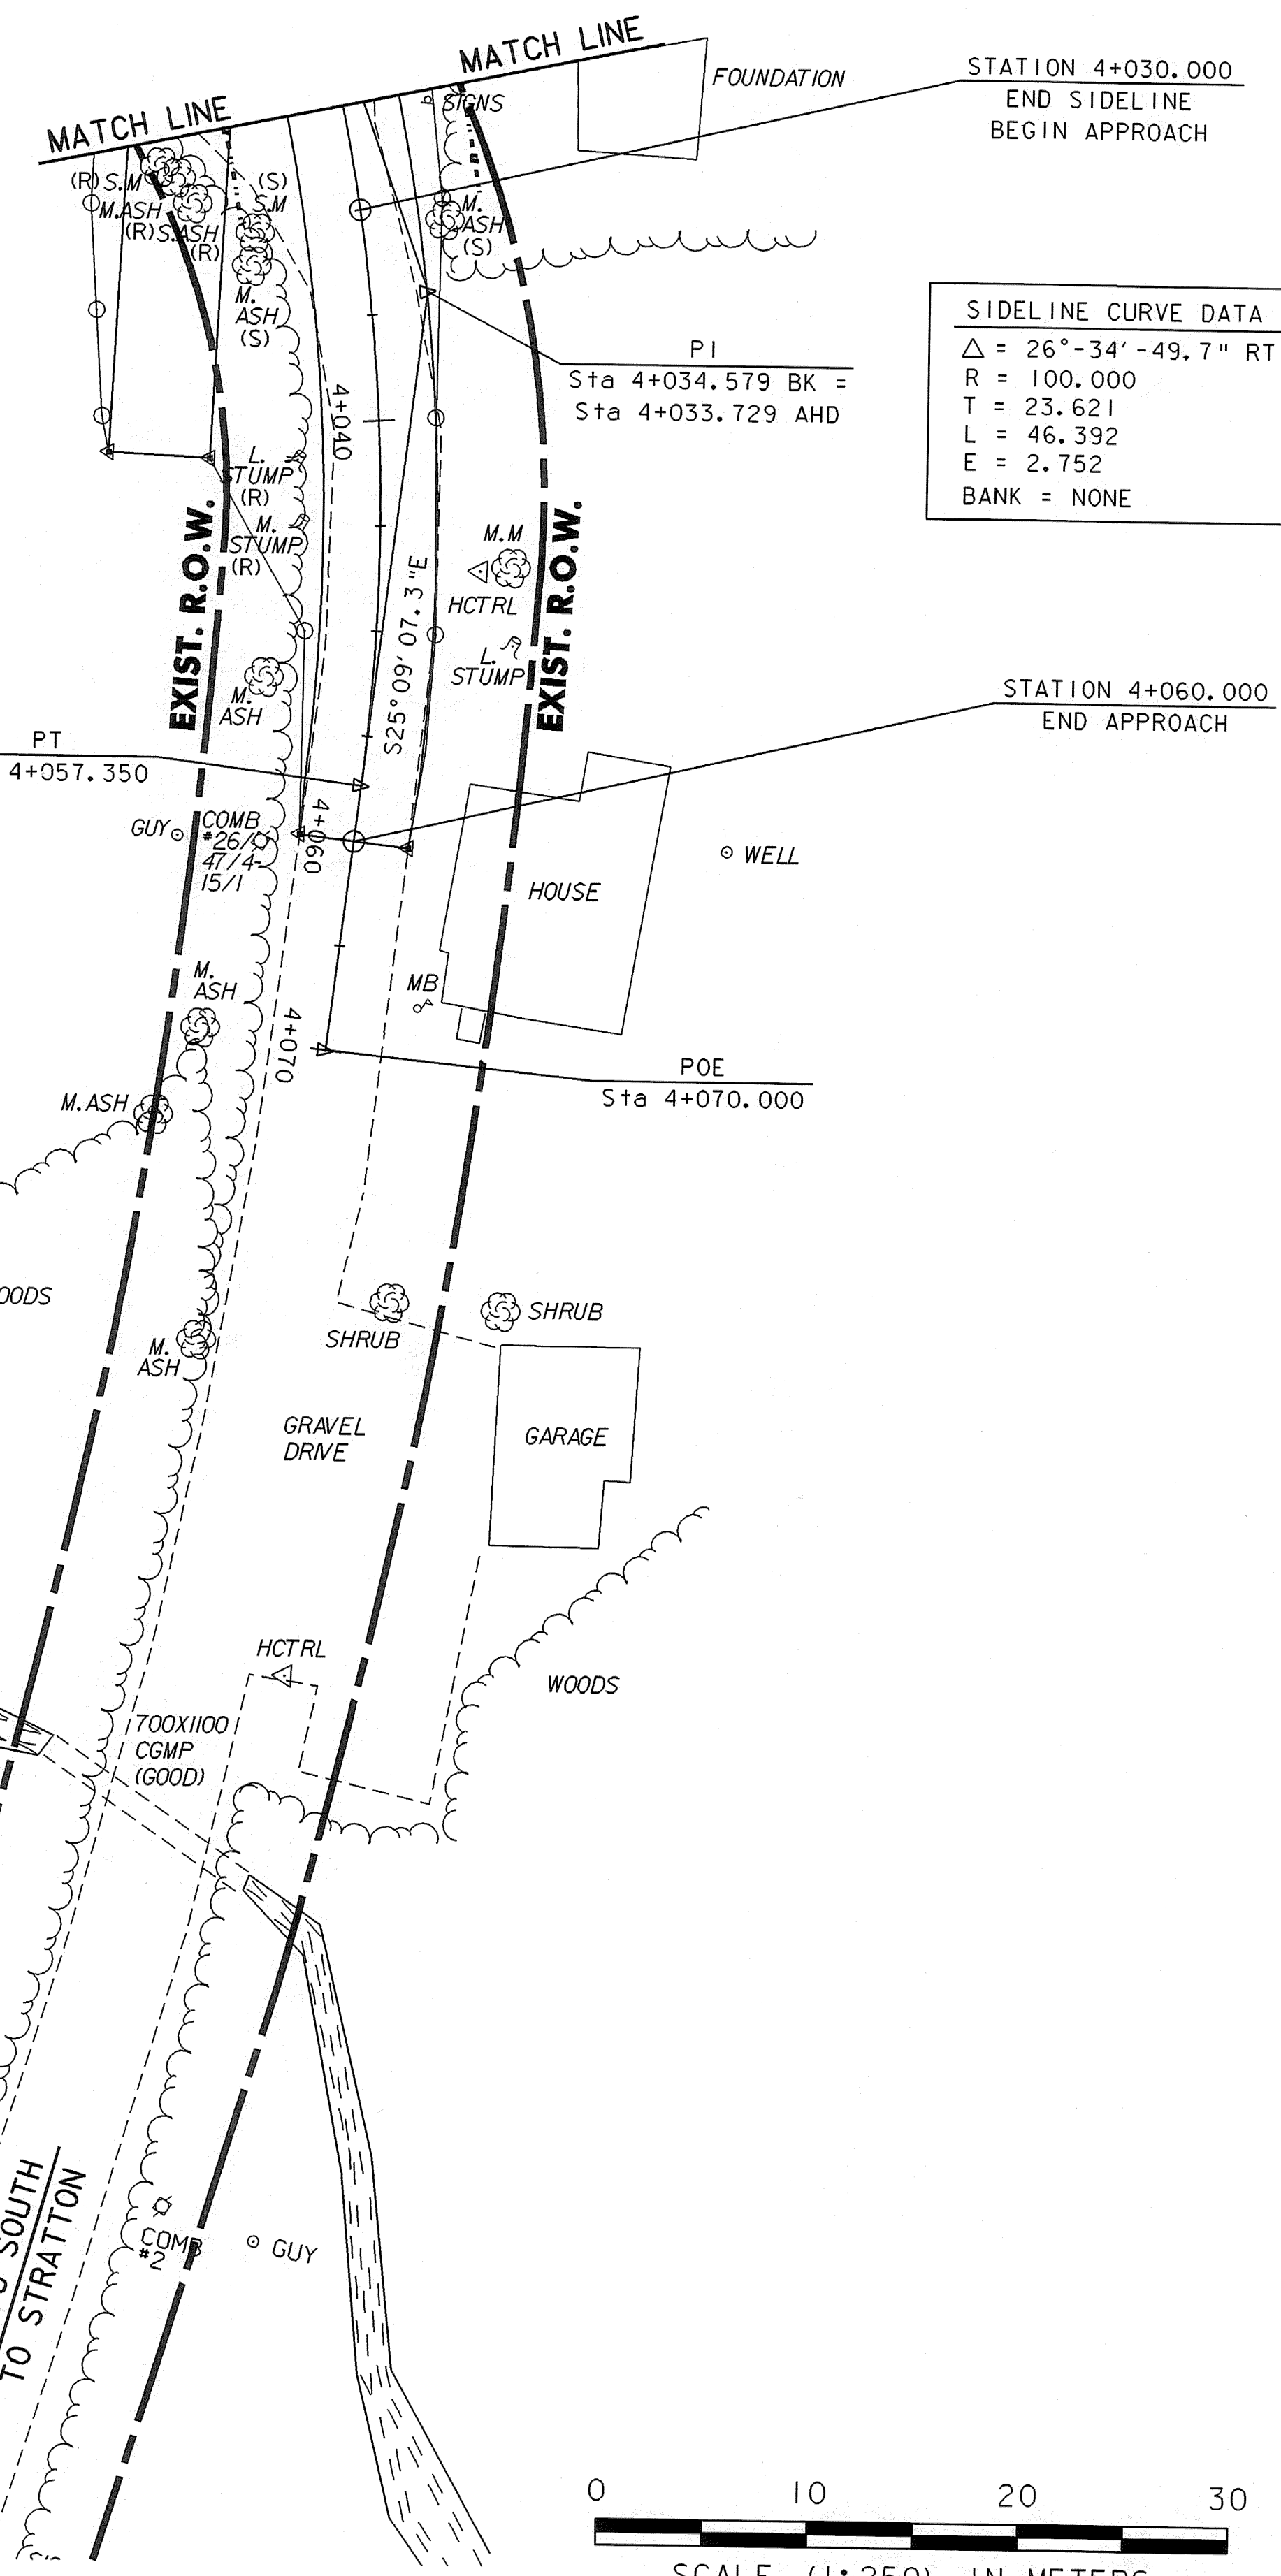

SHEET NAME:	<b>PLAN SHEET #2</b>	
PROJECT NAME:	SUNDERLAND	HIGHWAY NO.: TH 3
PROJECT NUMBER:	BRF 0114(2)	BRIDGE NO.: 14
		OVER: ROARING BRANCH
FILE NAME:	/PW/93j009/sj009bdr.dgn	PLOT DATE: 14-DEC-2005
PROJECT MANAGER:	R. R. WHITCOMB	DRAWN BY: K.UPMAL
DESIGNED BY:	K.UPMAL	IPARM NAME: sj009p12.1
		SHEET 11 OF 67