


SIDELINE PROFILE

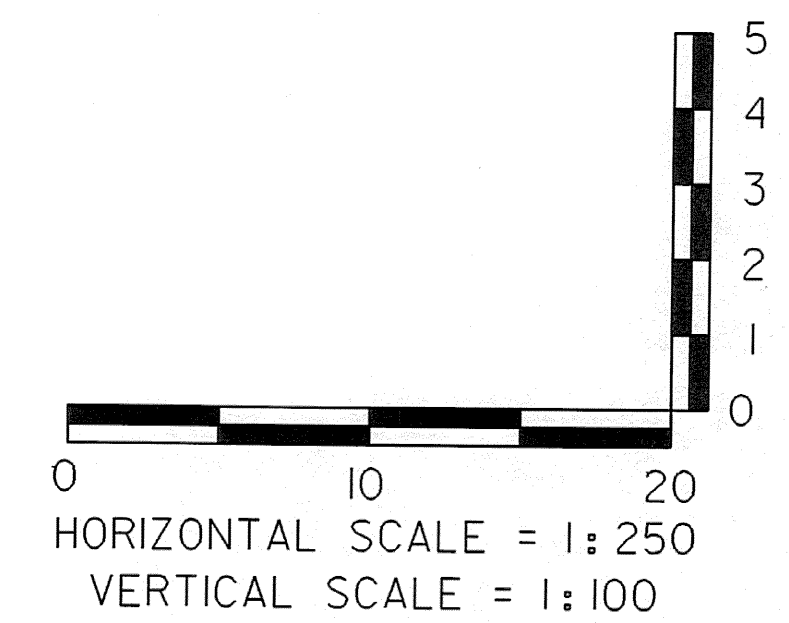

THE GRADES SHOWN TO THE NEAREST HUNDREDTH ARE THE OLD GROUND ALONG THE CENTERLINE. THE GRADES SHOWN TO THE NEAREST THOUSANDTH ARE THE PROPOSED FINISHED GRADE ALONG THE CENTERLINE.

SHEET NAME: <b>SIDELINE PROFILE</b>	
PROJECT NAME: <b>SUNDERLAND</b>	HIGHWAY NO.: TH 3
PROJECT NUMBER: <b>BRF 0114(2)</b>	BRIDGE NO.: 14
	OVER: ROARING BRANCH
FILE NAME: /PW/93J009/sj009xs.dgn	PLOT DATE: 14-DEC-2005
PROJECT MANAGER: R. R. WHITCOMB	DRAWN BY: K.UPMAL
DESIGNED BY: K.UPMAL	IPARM NAME: sj009sp.1
	SHEET 13 OF 67