






- LEGEND**
-  ARCHEOLOGICALLY SENSITIVE AREA
 -  PRE-CONSTRUCTION DRAINAGE
 -  POST-CONSTRUCTION DRAINAGE

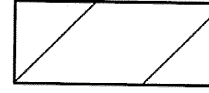

DATUM

VERTICAL	NAVD 88
HORIZONTAL	SPC 83/92

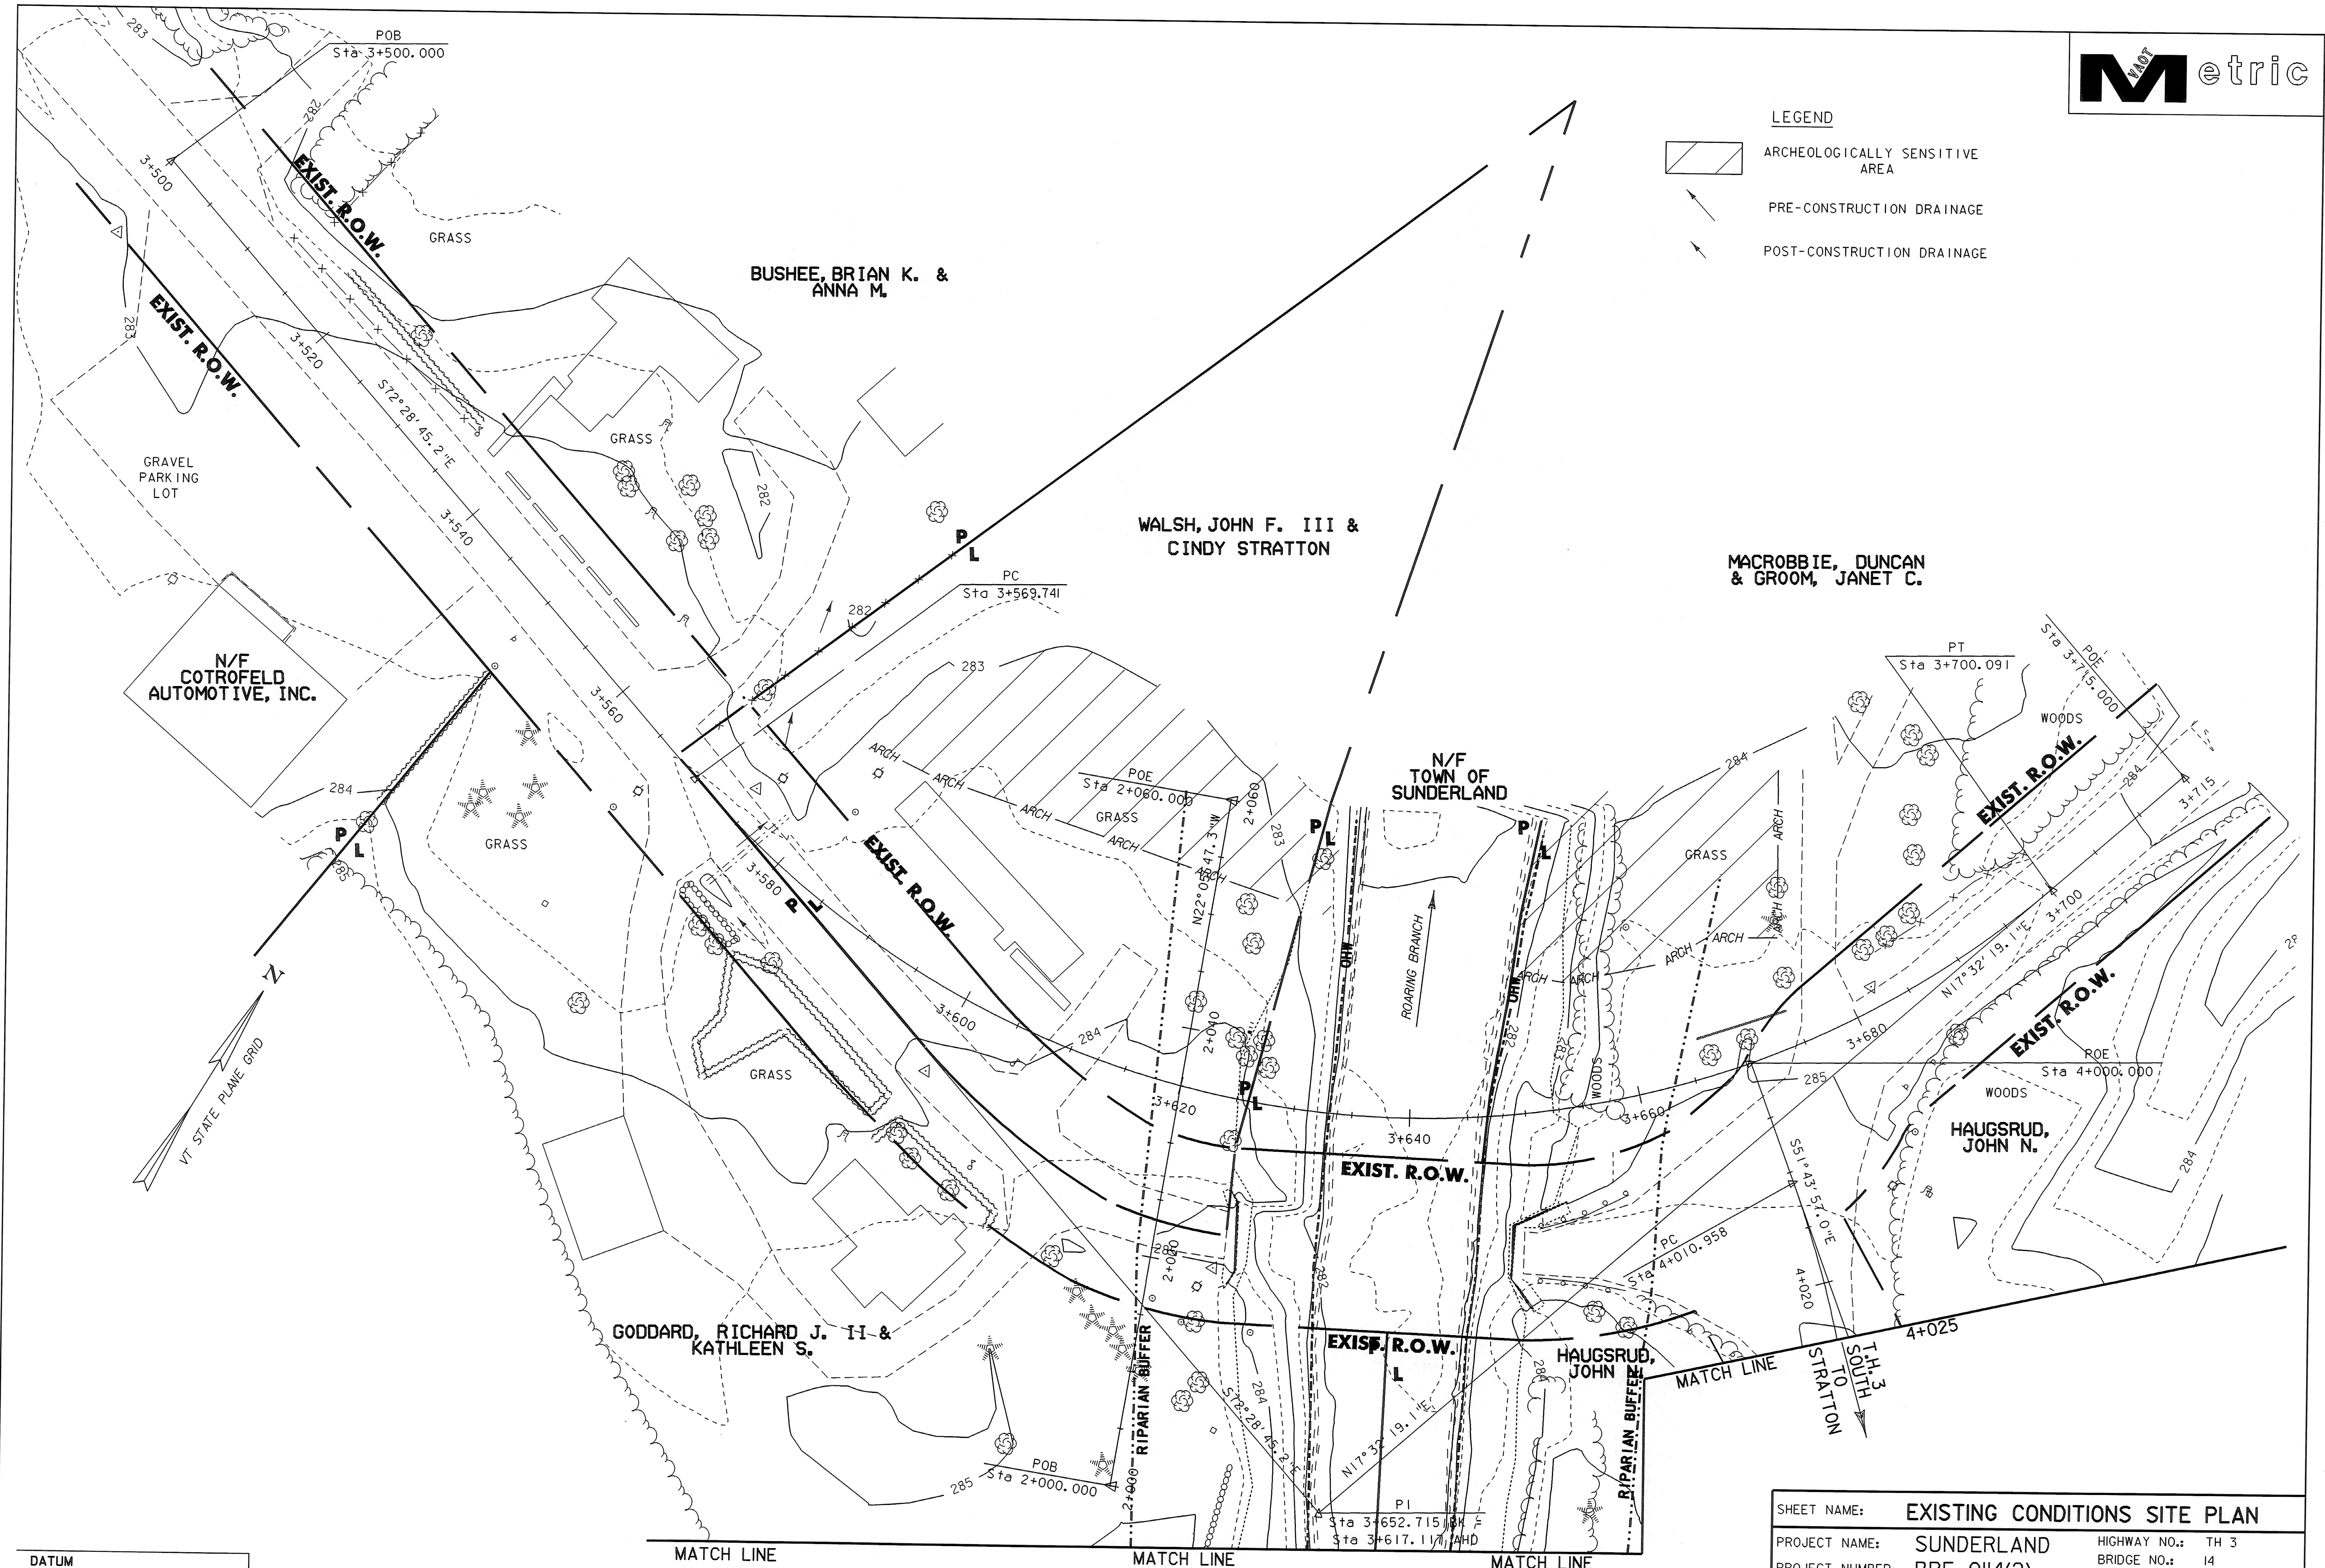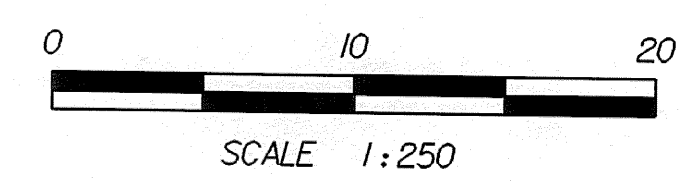

SHEET NAME: EXISTING CONDITIONS SITE PLAN	
PROJECT NAME: SUNDERLAND	HIGHWAY NO.: TH 3
PROJECT NUMBER: BRF 0114(2)	BRIDGE NO.: 14
	OVER: ROARING BRANCH
FILE NAME: /PW/93J009/sj009ec.dgn	PLOT DATE: 19-DEC-2005
PROJECT MANAGER: R. R. WHITCOMB	DRAWN BY: J.GILMORE
DESIGNED BY: C. CARLSON	IPARM NAME: sj009ec2.i
	SHEET 24 OF 67