



ABUTMENT #2 PLAN
SCALE 1:50

BARS ORDERED PER PLAN BUT NOT INSTALLED DUE TO INCORRECT SIZING. PAY FOR BARS.

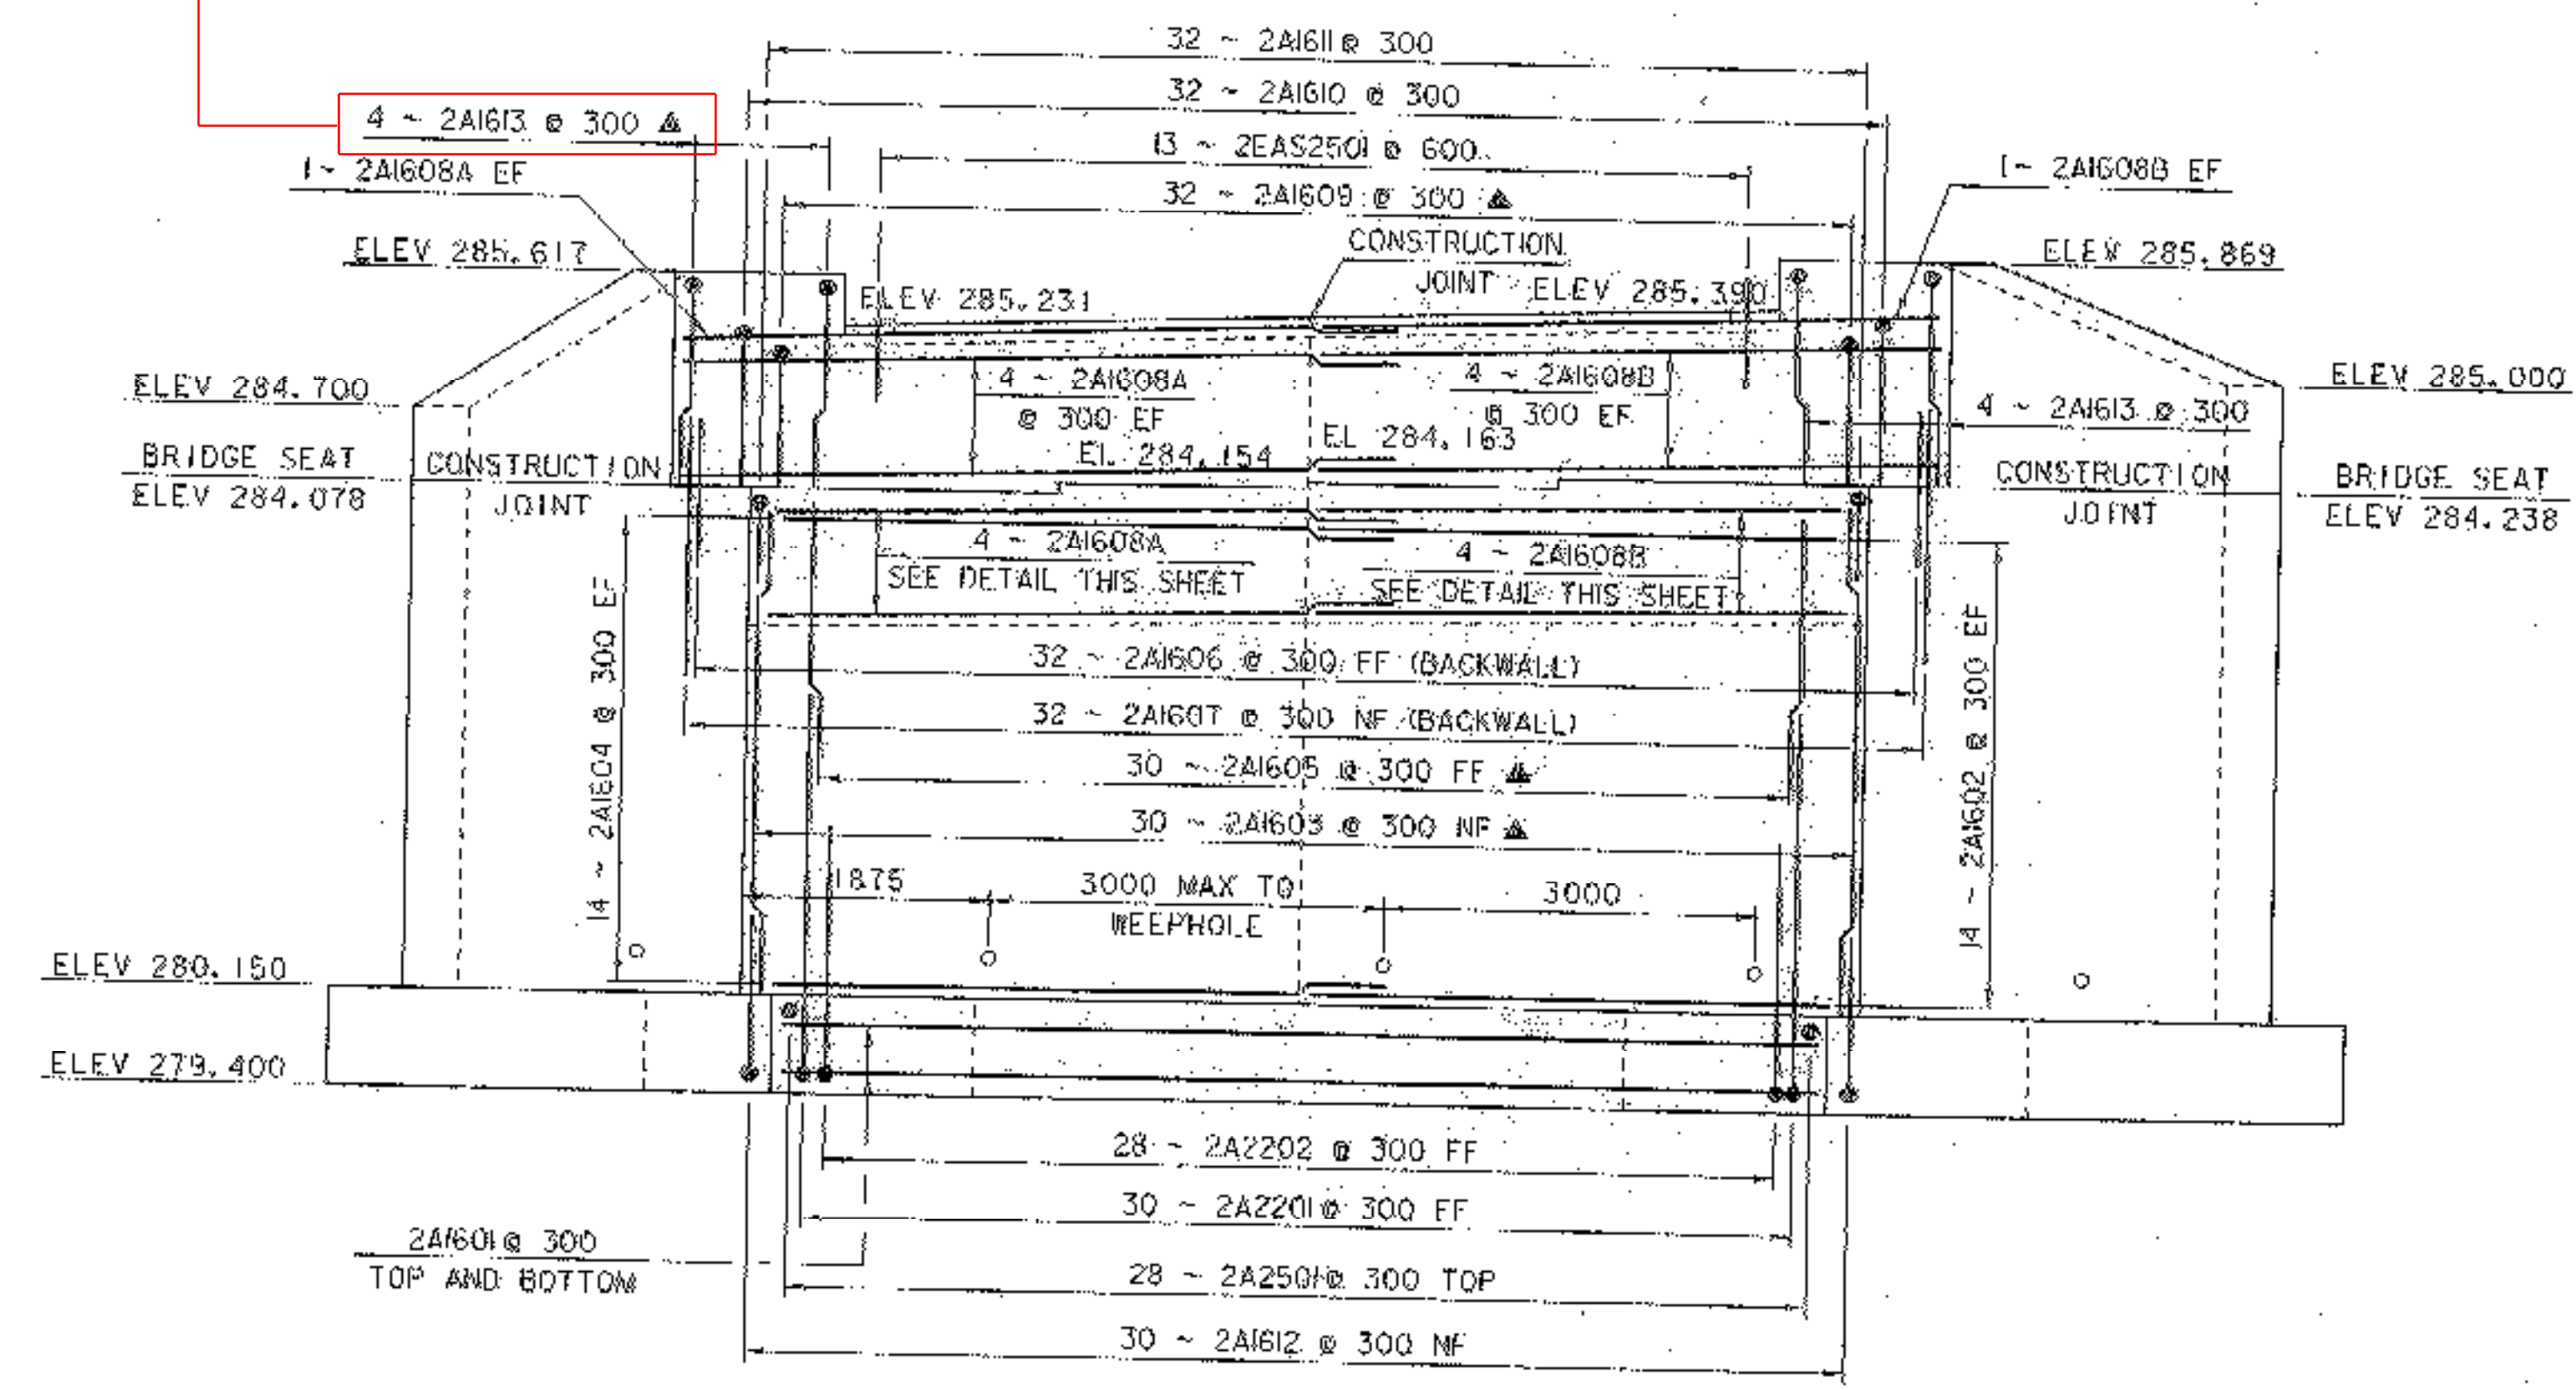

ABUTMENT #2 ELEVATION
SCALE 1:50

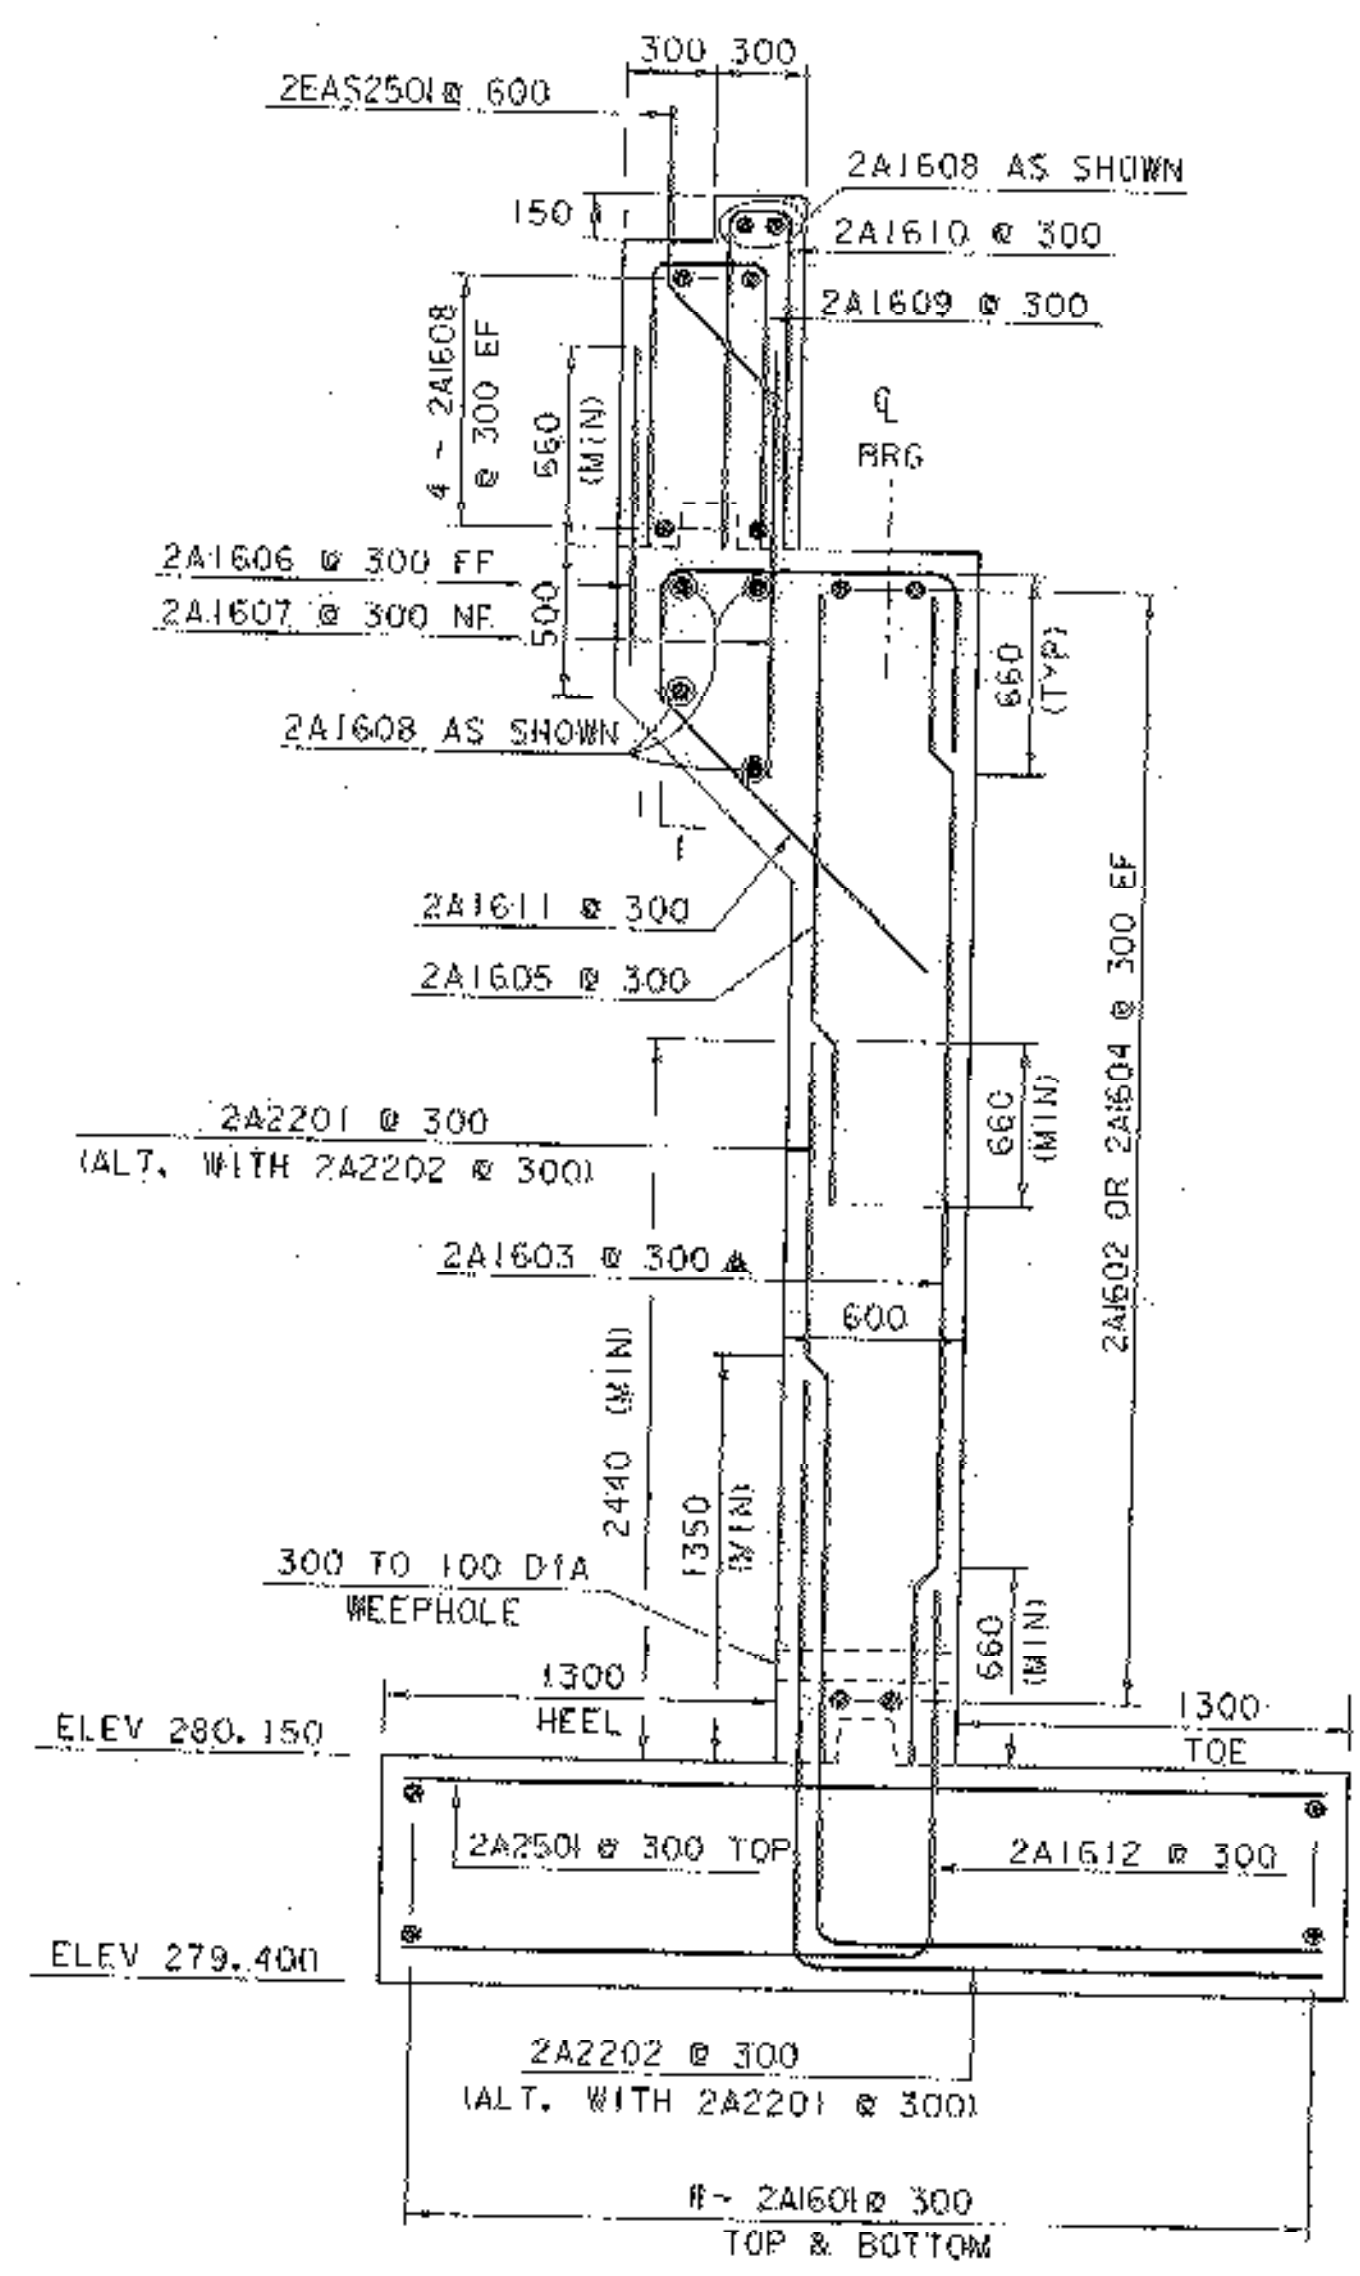

ABUTMENT #2 SECTION
SCALE 1:25

NOTE:
ALTERNATE BEARING DESIGN MAY CHANGE BRIDGE SEAT ELEVATIONS

- NOTES:
1. NF = NEAR FACE
 2. FF = FAR FACE
 3. EF = EACH FACE
 4. ▲ = CUT TO FIT IN FIELD
 5. 80 CLEAR UNLESS OTHERWISE SPECIFIED ON THE PLANS.

SHEET NAME: ABUTMENT #2 DETAILS		
PROJECT NAME: SUNDERLAND	HIGHWAY NO.: TH 3	
PROJECT NUMBER: BRF 014(2)	BRIDGE NO.: 14	OVER: ROARING BRANCH
FILE NAME: /PW/93/009/sj009e06.dgn	PLOT DATE: 14-DEC-2005	
PROJECT MANAGER: R. R. WHITCOMB	DRAWN BY: J. GILMORE	
DESIGNED BY: D. BONNEAU	IPARM NAME: sj009ab2.1	SHEET 45 OF 67