



WINGWALL #1 ELEVATION
SCALE 1:50

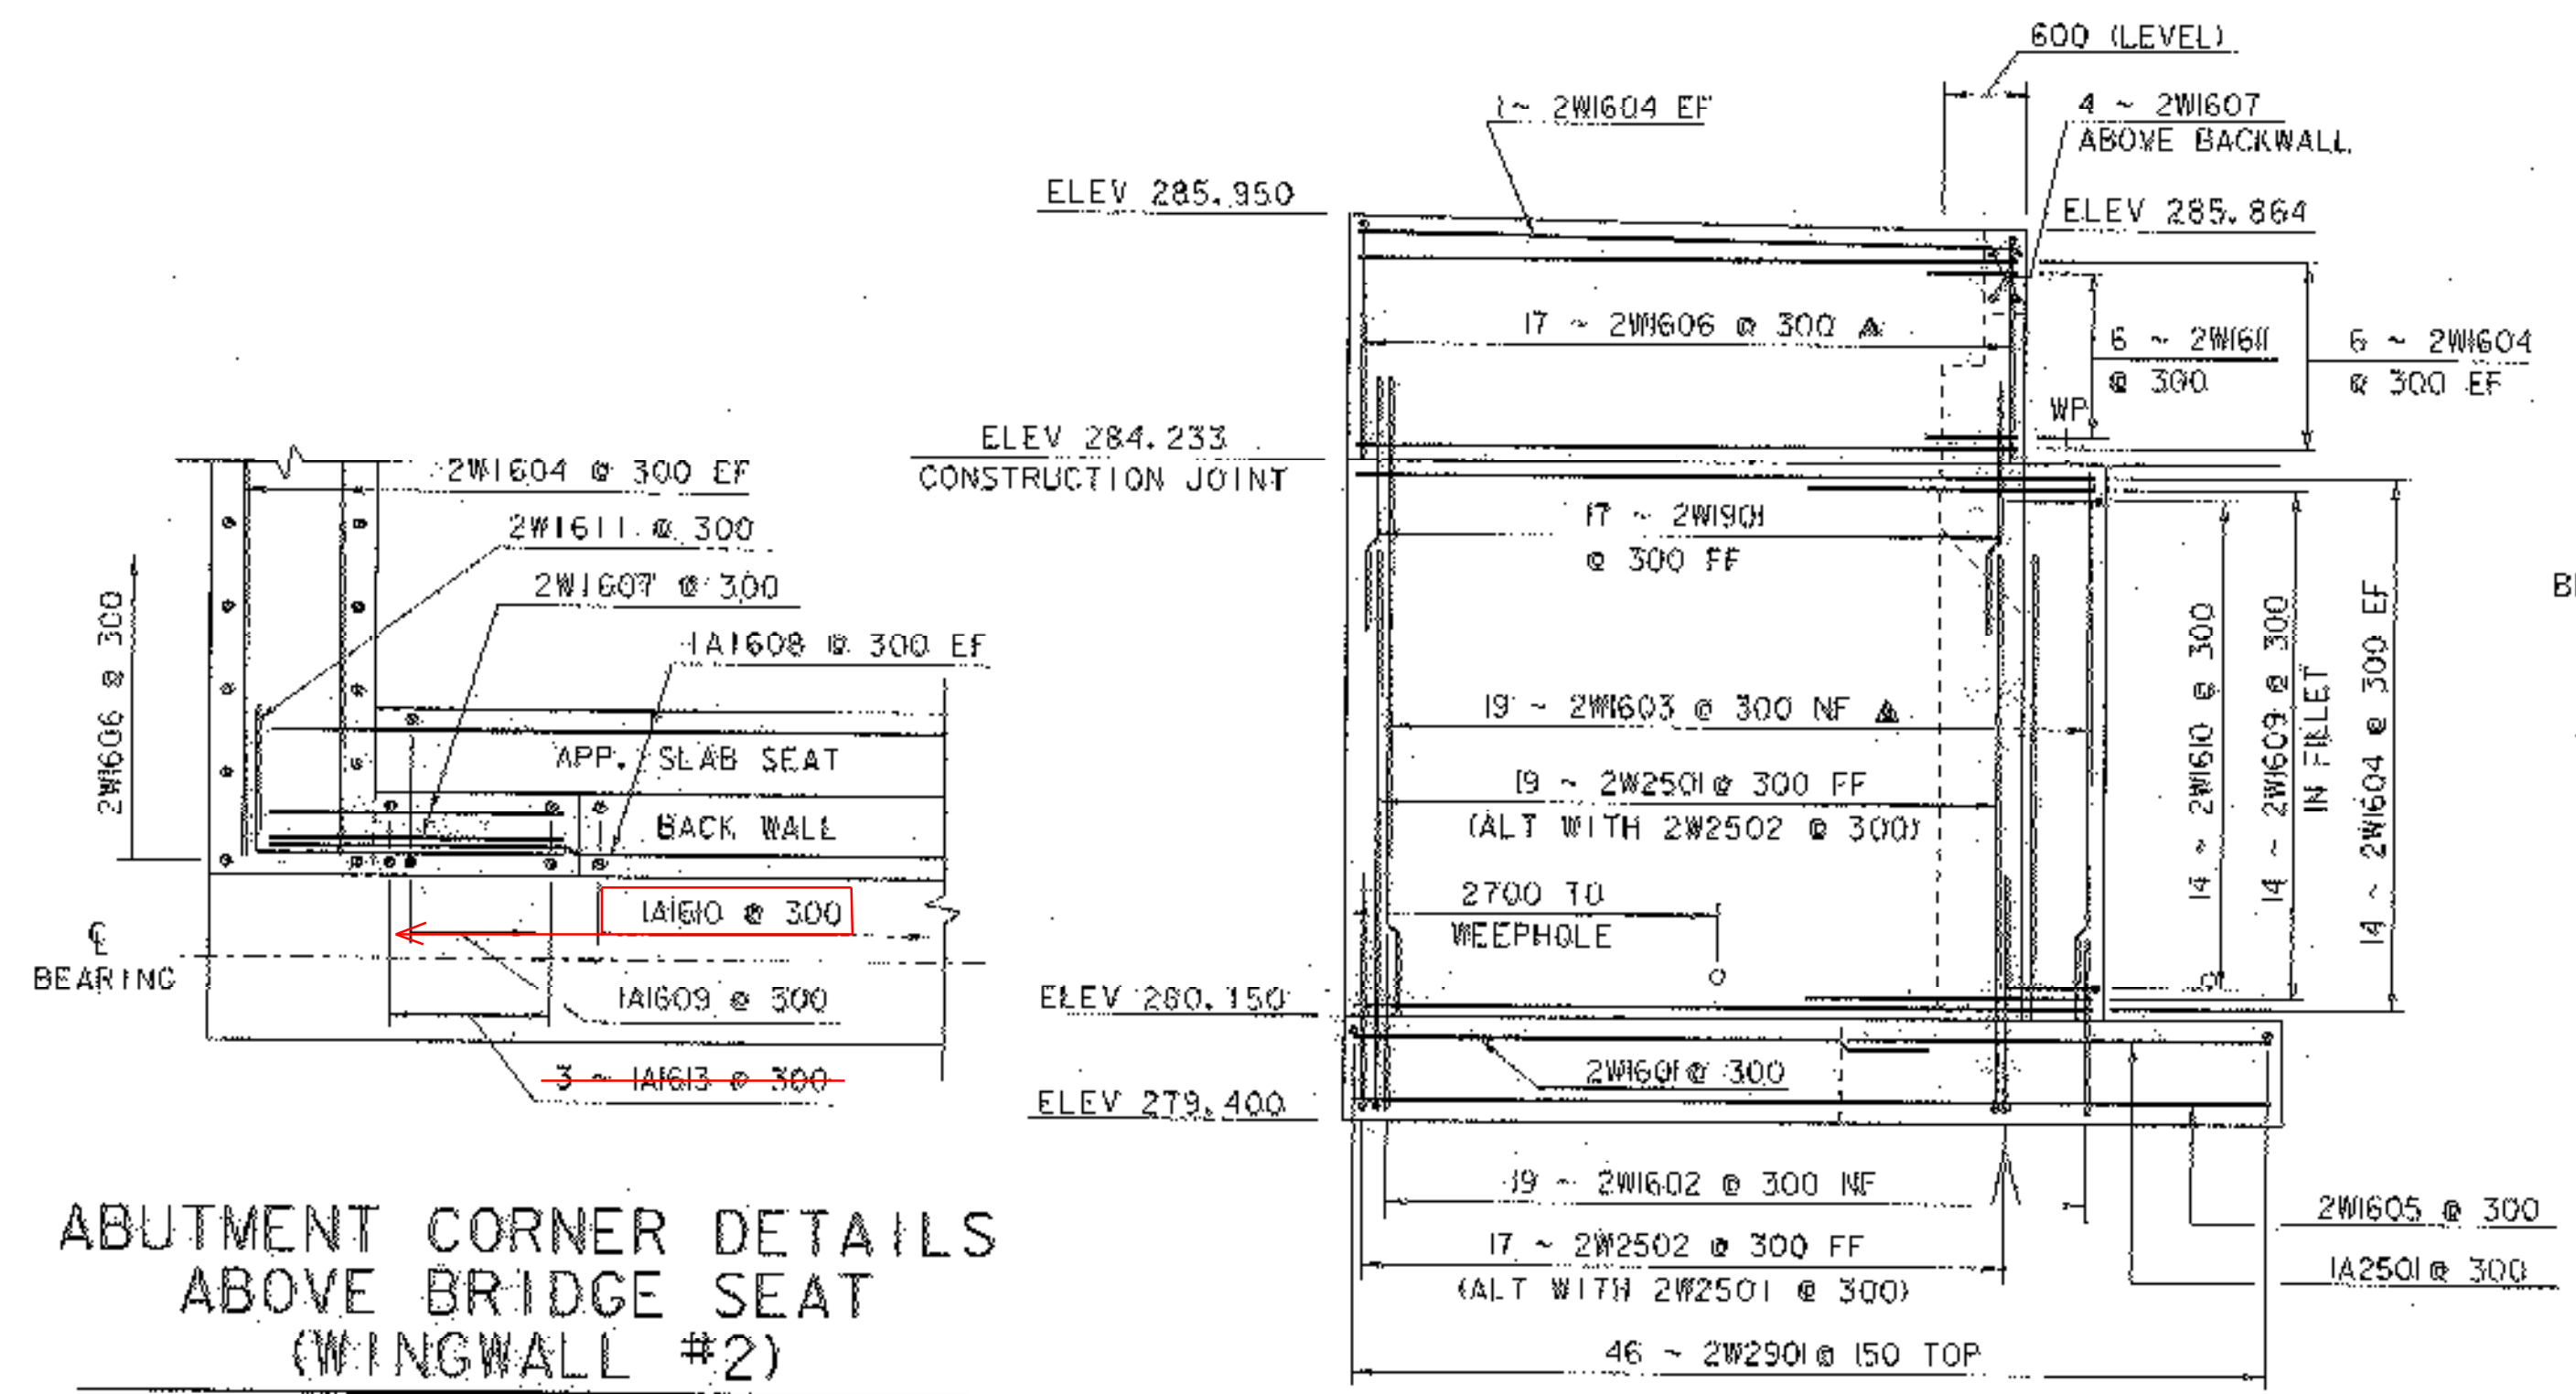


ABUTMENT CORNER DETAILS ABOVE BRIDGE SEAT (WINGWALL #2)
SCALE 1:25
TOP OF STIRRUP BARS OMITTED FOR CLARITY


WINGWALL #2 ELEVATION
SCALE 1:50

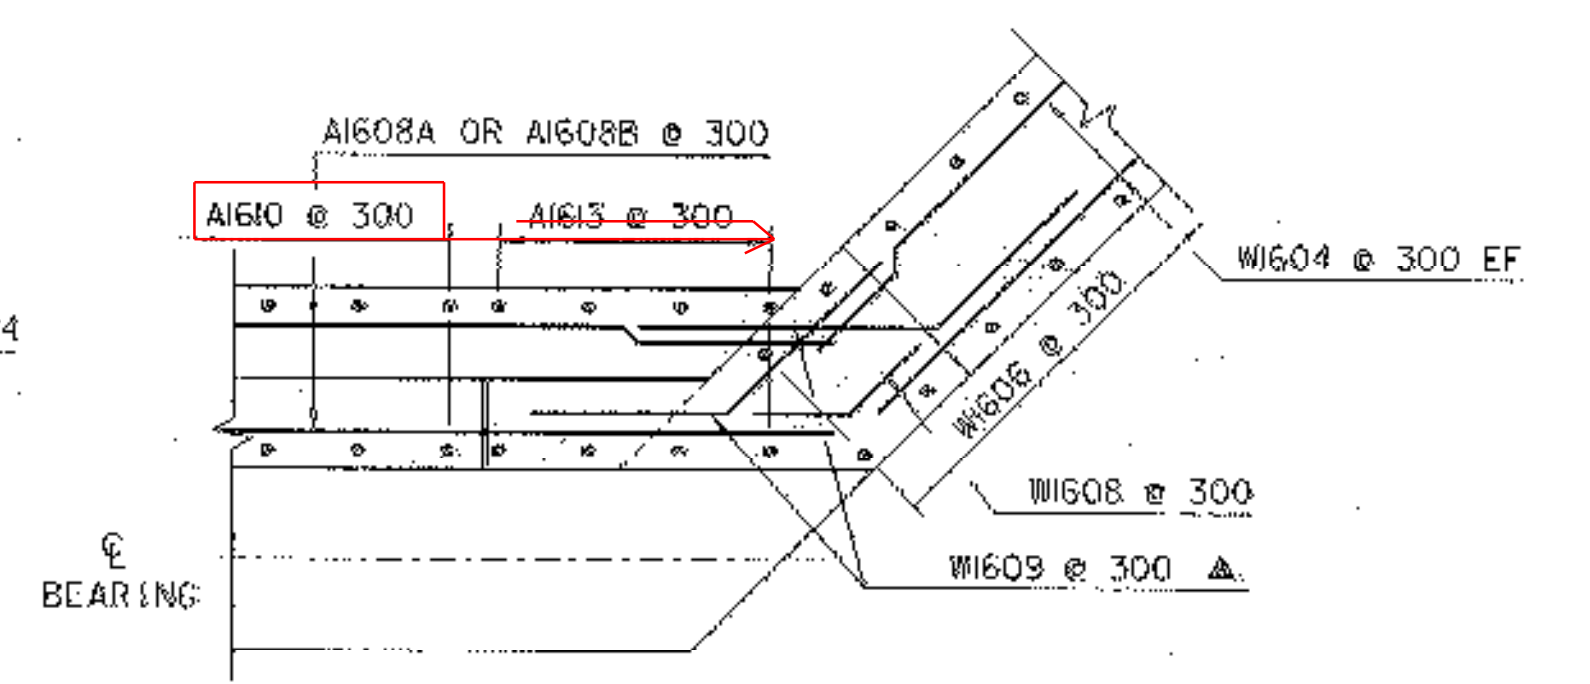


ABUTMENT CORNER DETAILS ABOVE BRIDGE SEAT (WINGWALLS 1,3&4)

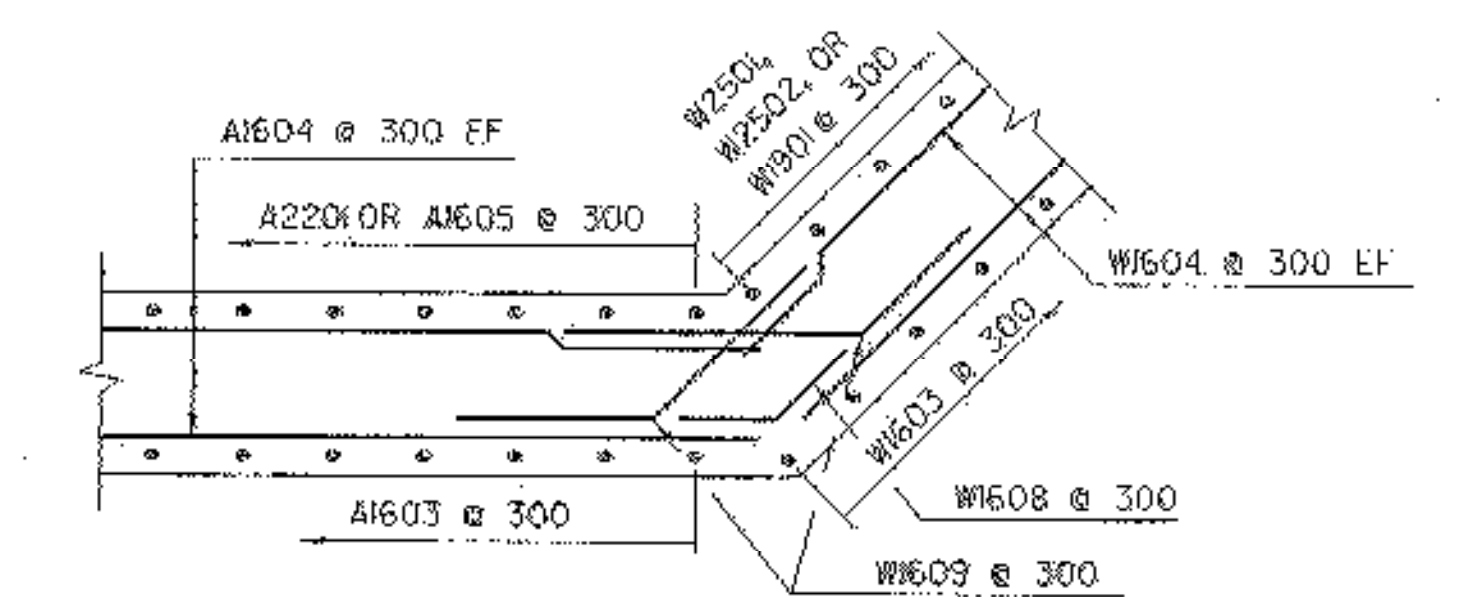


ABUTMENT CORNER DETAILS BELOW BRIDGE SEAT (WINGWALLS 1,3&4)
SCALE 1:25

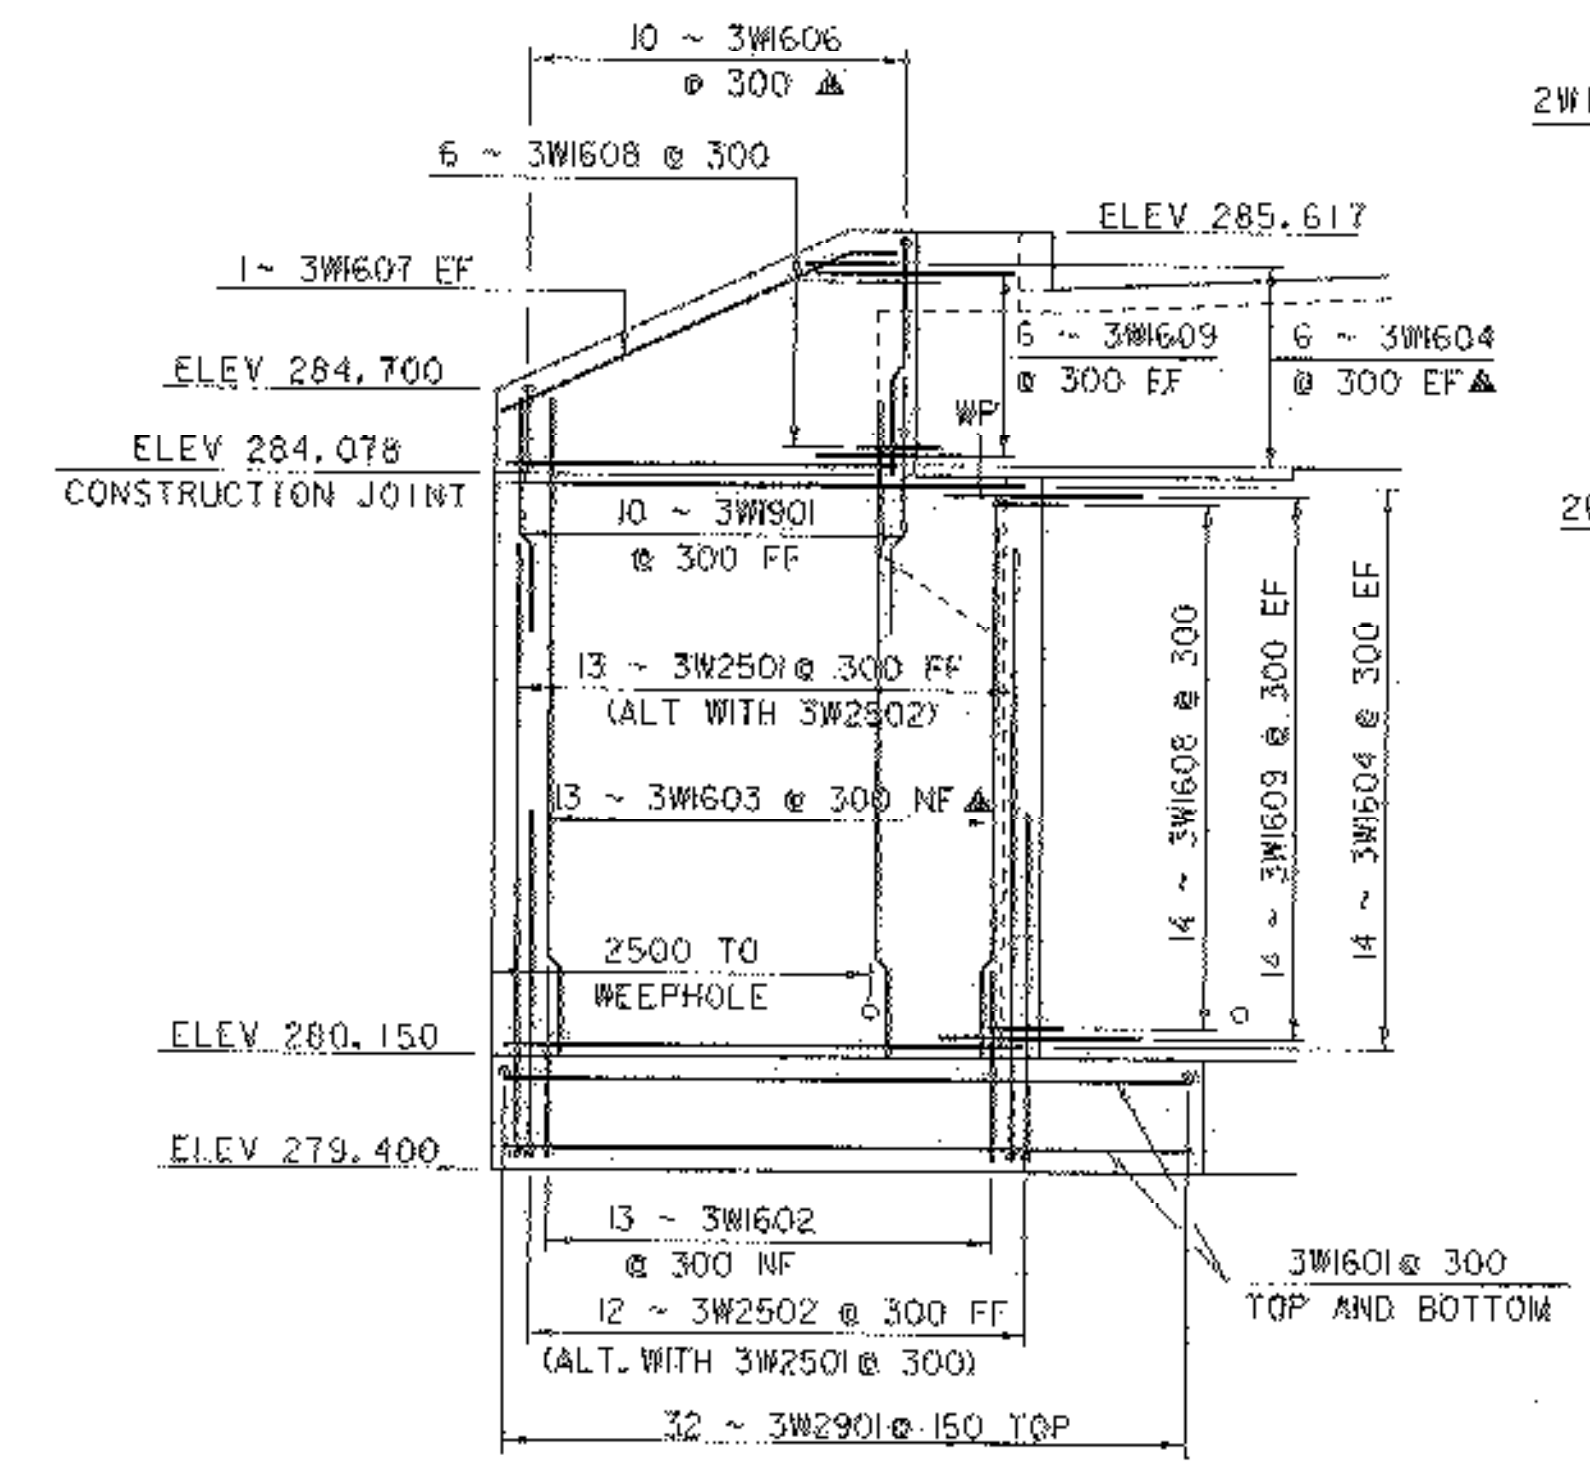


WINGWALL #3 ELEVATION
SCALE 1:50

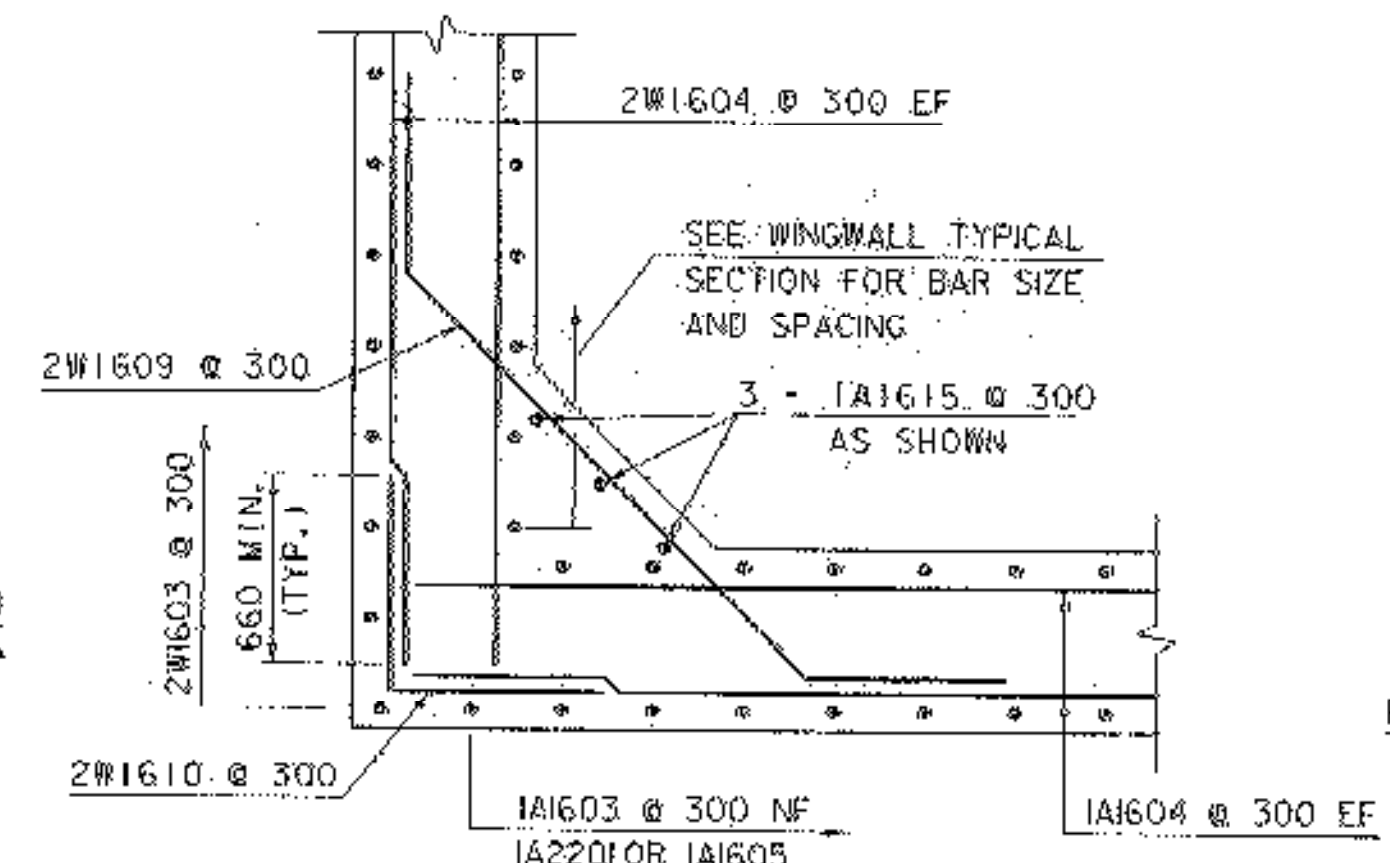

ABUTMENT CORNER DETAILS BELOW BRIDGE SEAT (WINGWALL #2)
SCALE 1:25

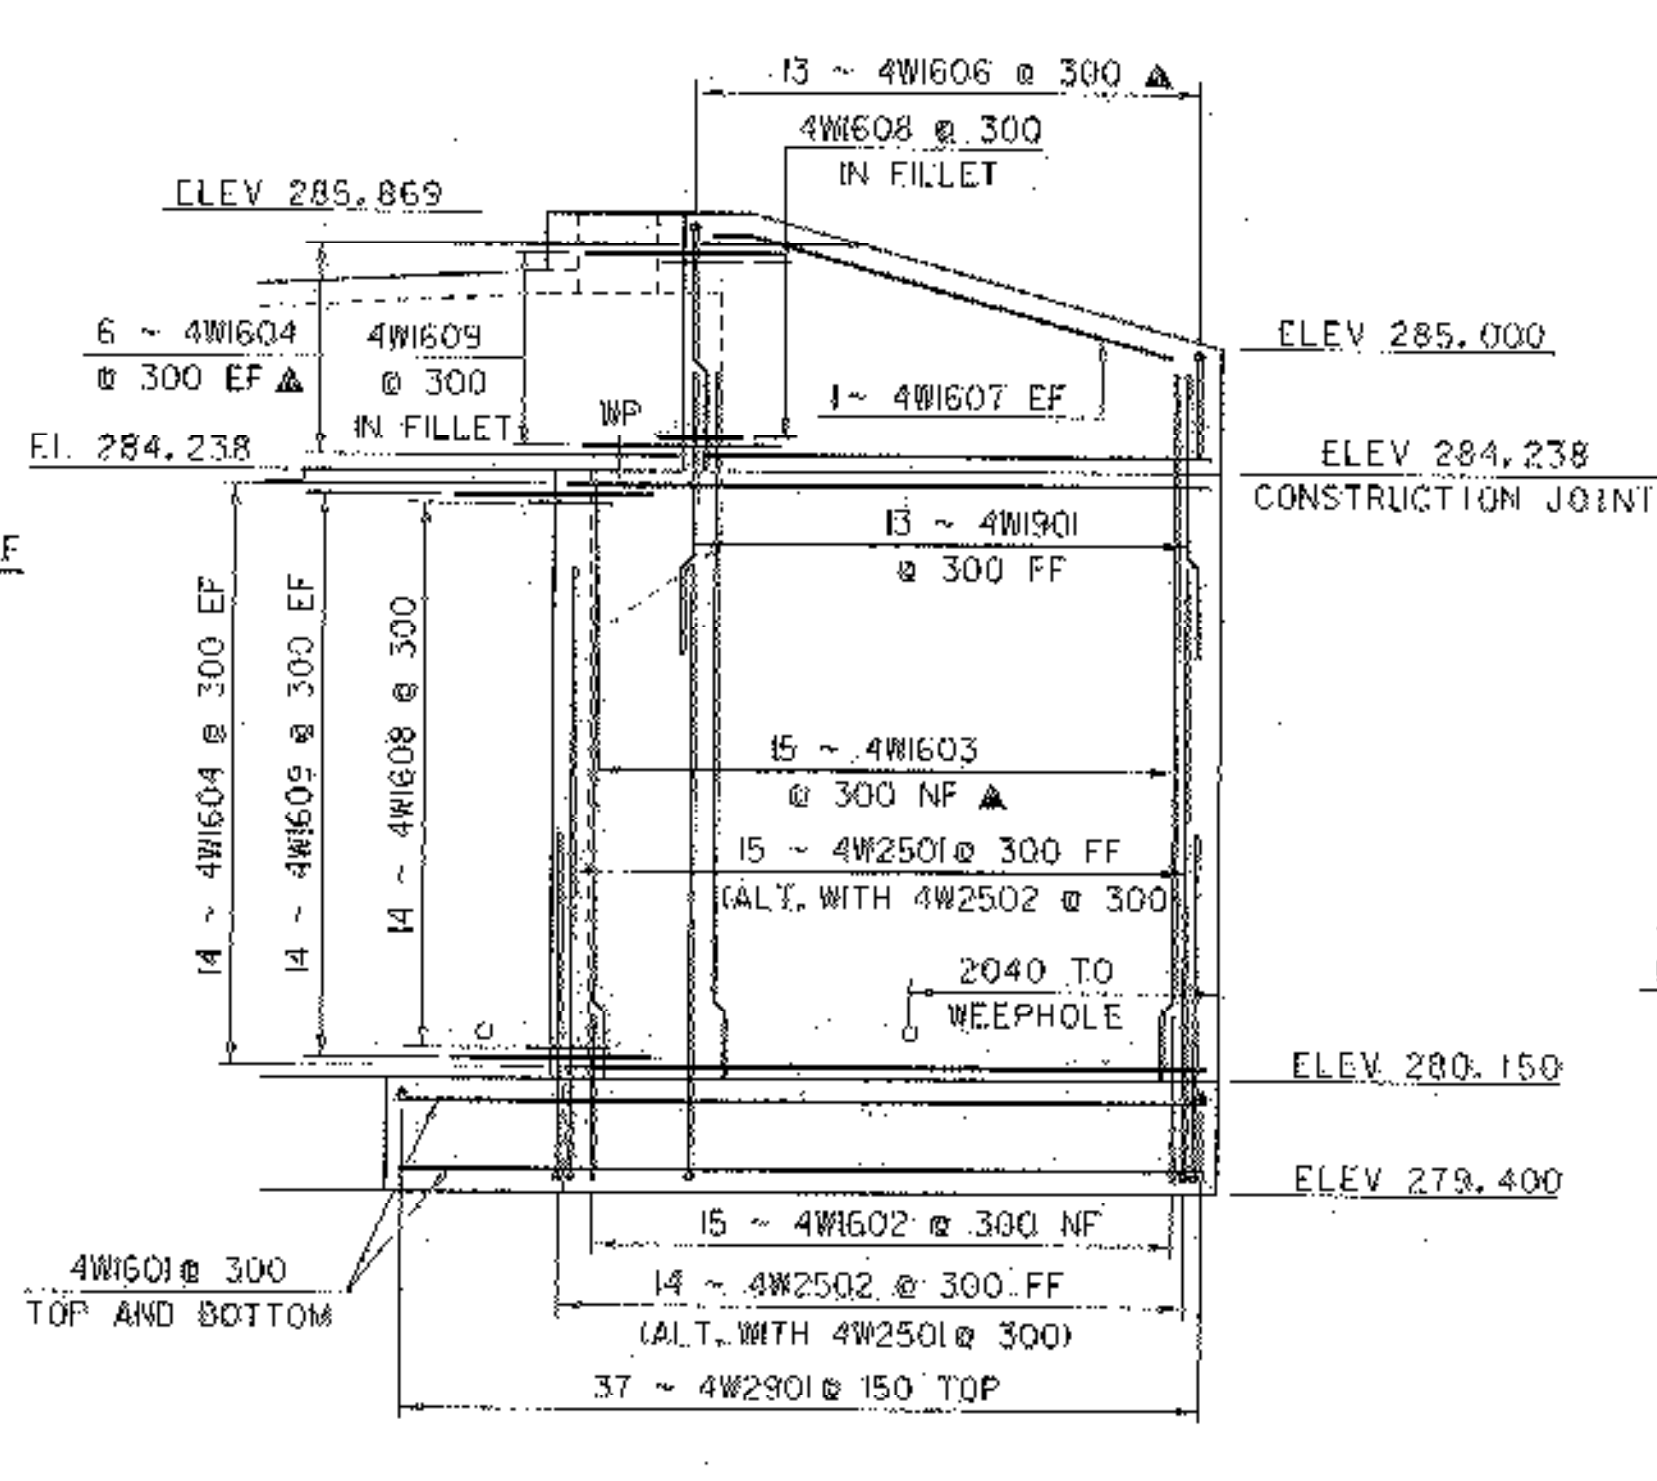

WINGWALL #4 ELEVATION
SCALE 1:50

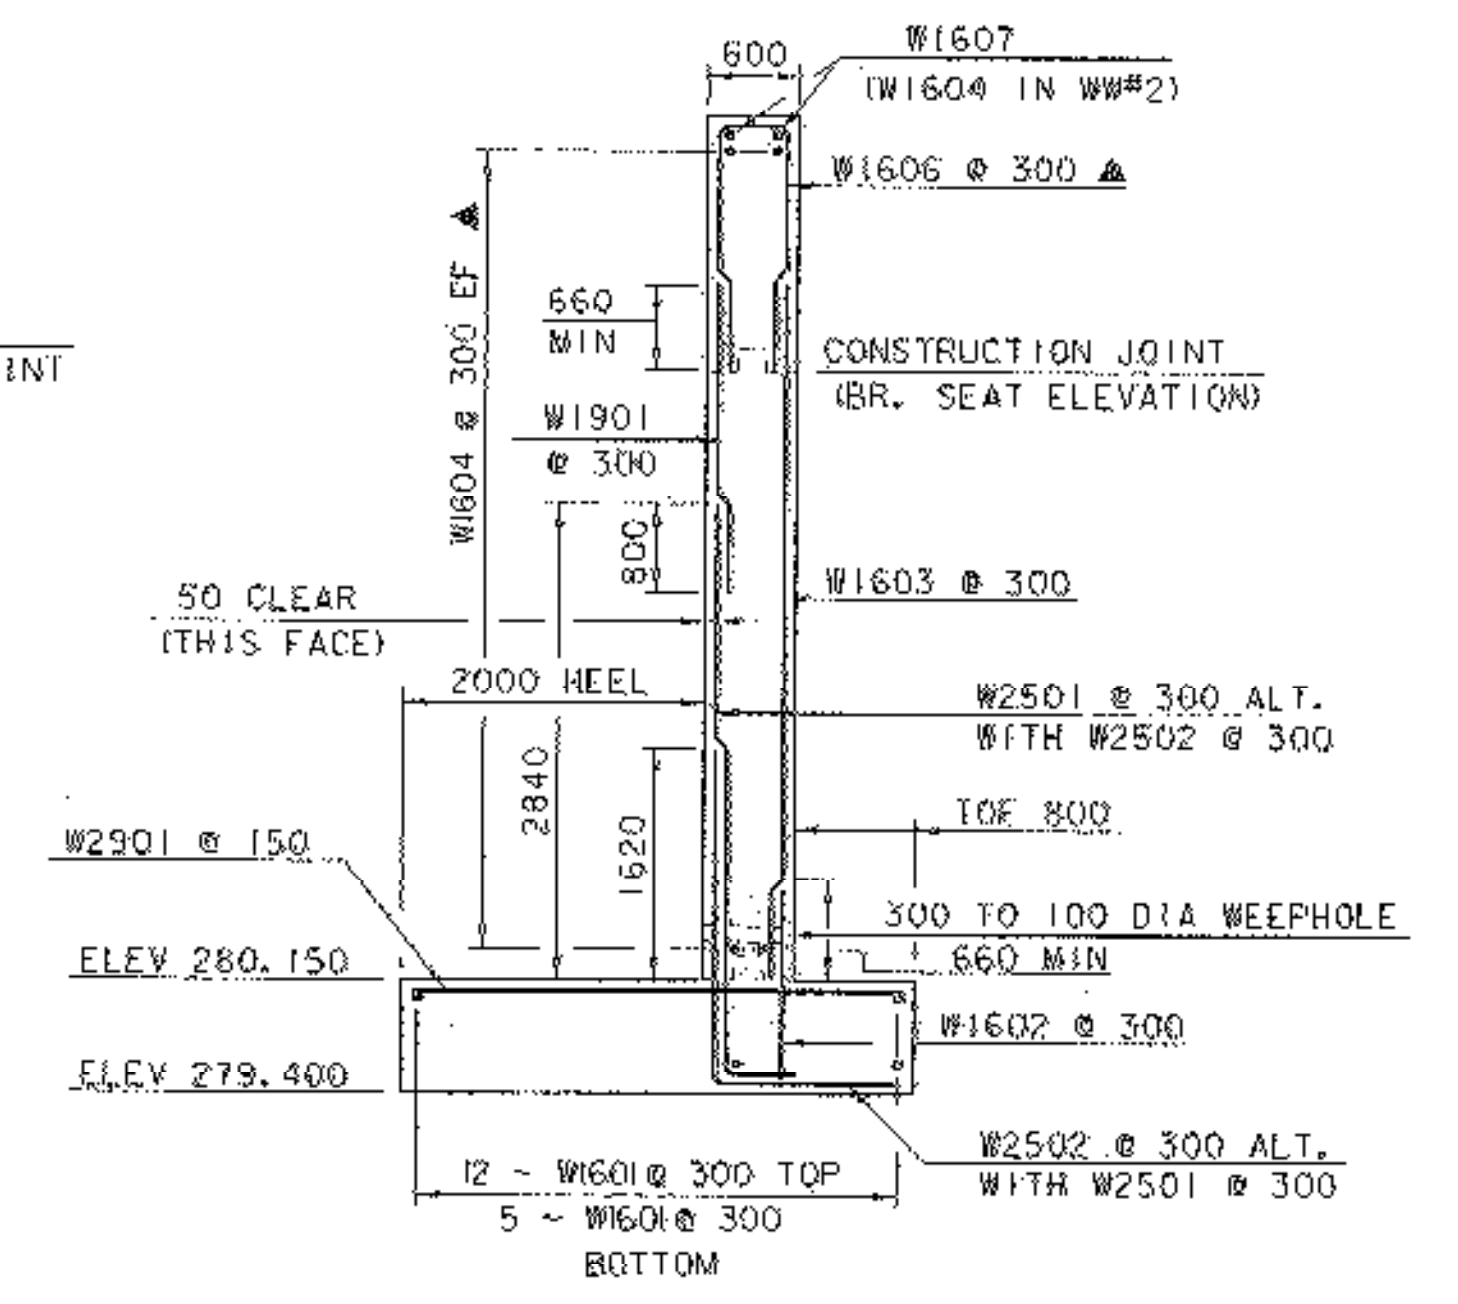

WINGWALL SECTION TYPICAL
SCALE 1:50

- NOTES:
- NF = NEAR FACE
 - FF = FAR FACE
 - EF = EACH FACE
 - ▲ = CUT TO FIT IN FIELD
 - 80 CLEAR UNLESS OTHERWISE SPECIFIED ON THE PLANS.

SHEET NAME: WINGWALL ELEVATIONS	
PROJECT NAME: SUNDERLAND	HIGHWAY NO.: TH 3
PROJECT NUMBER: BRF 0114(2)	BRIDGE NO.: 14
FILE NAME: /PW/93/009/sj009sub.dgn	OVER: ROARING BRANCH
PROJECT MANAGER: R. R. WHITCOMB	PLOT DATE: 14-DEC-2005
DESIGNED BY: D. BONNEAU	DRAWN BY: J. GILMORE
	IPARM NAME: sj009ww.1
	SHEET 47 OF 67