


MAINLINE BANKING DIAGRAM

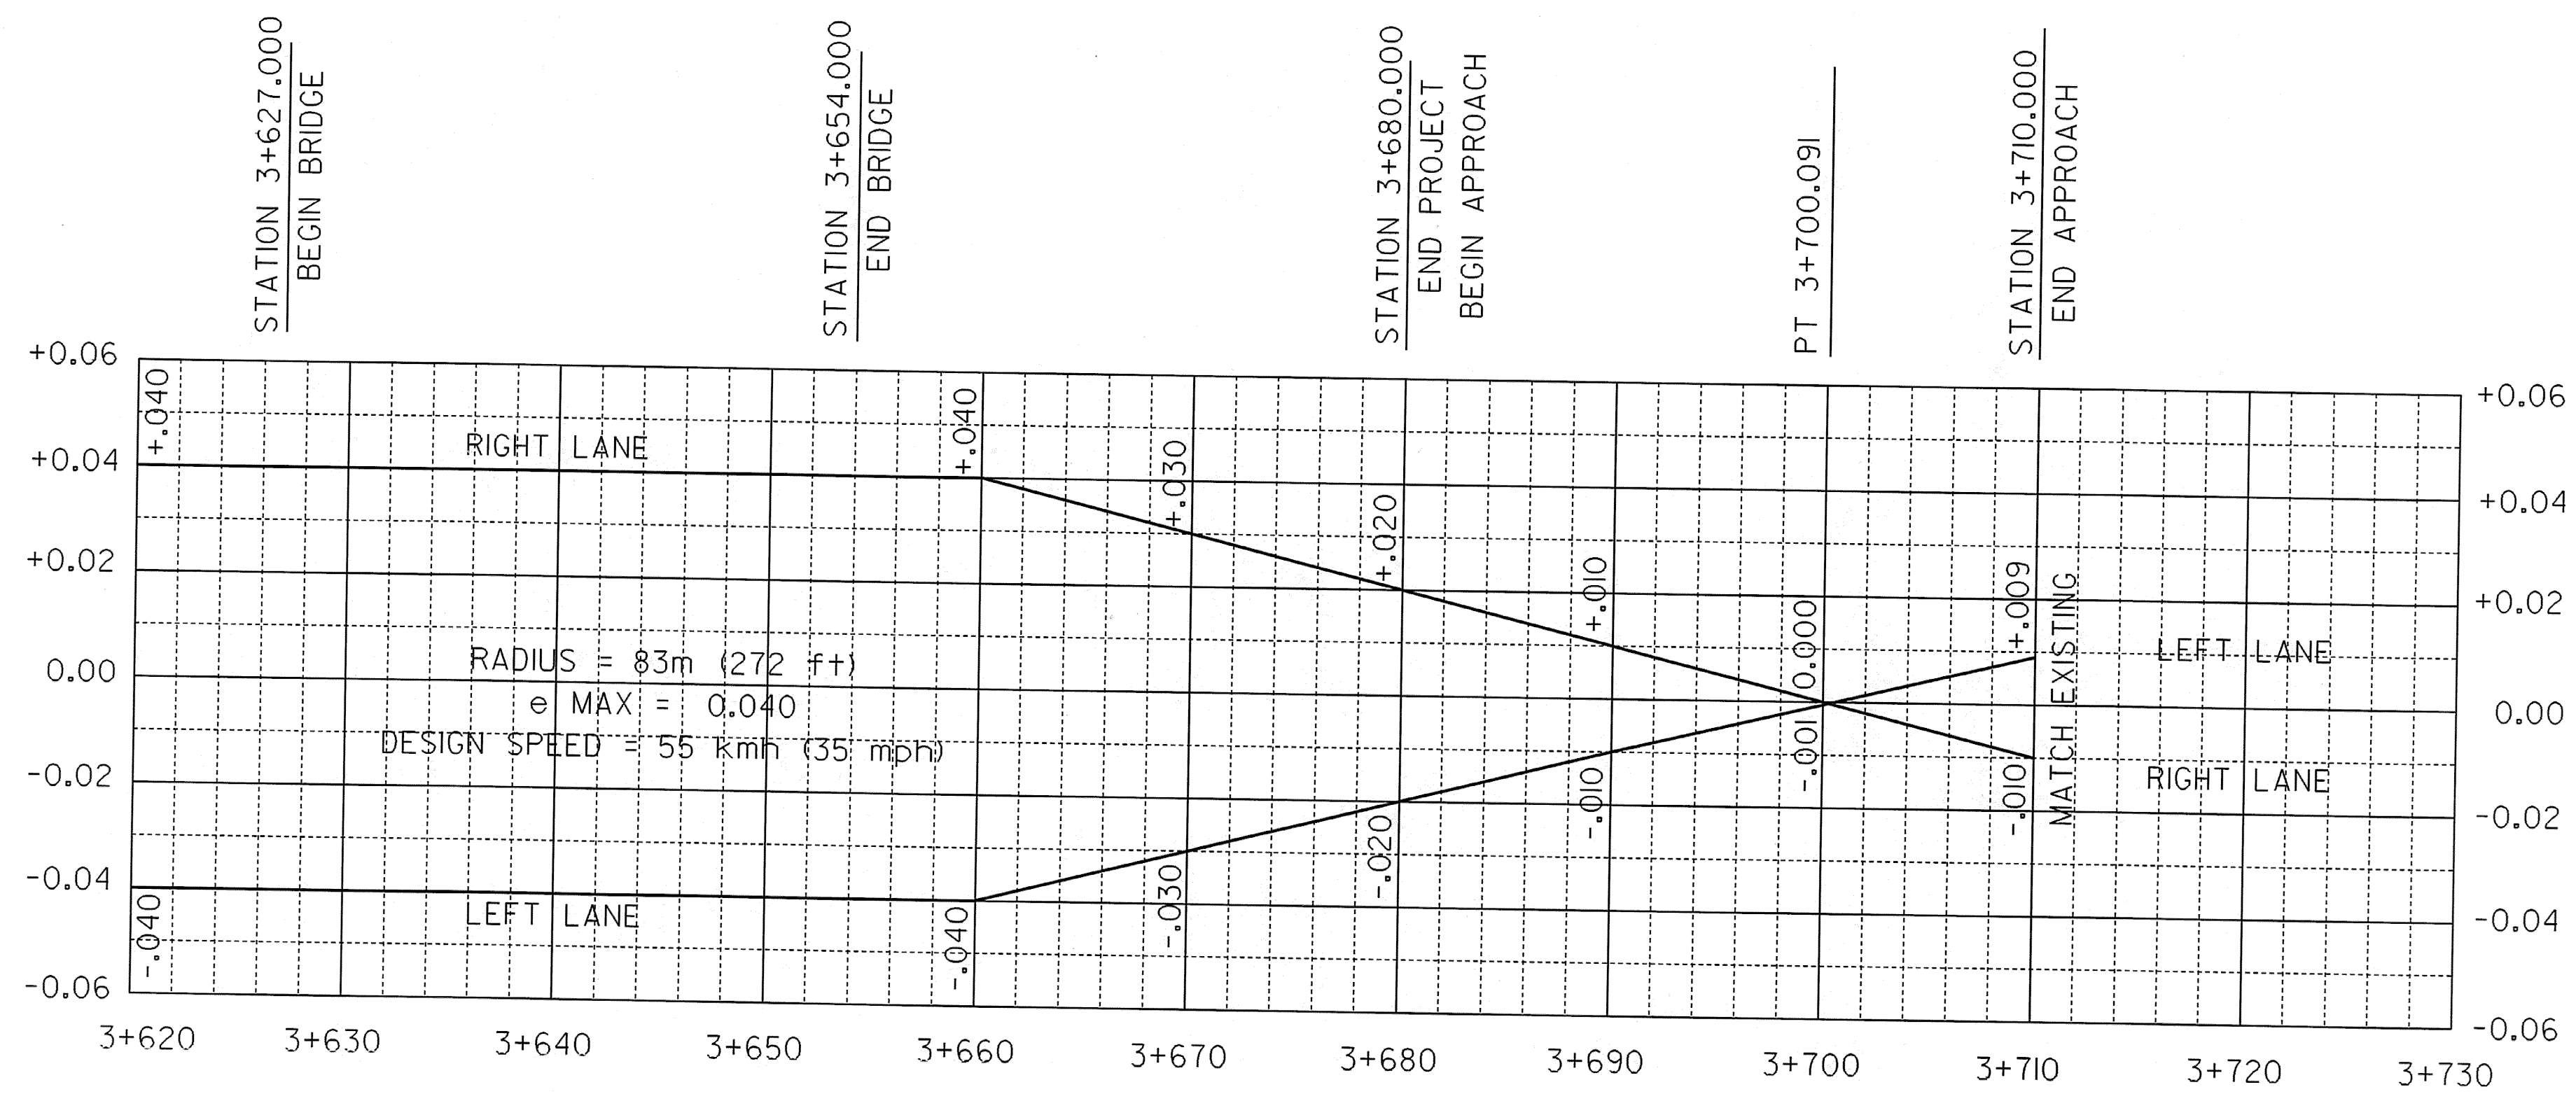

MAINLINE BANKING DIAGRAM CONTINUED

SHEET NAME: MAINLINE BANKING DIAGRAM	
PROJECT NAME: SUNDERLAND	HIGHWAY NO.: TH 3
PROJECT NUMBER: BRF 0114(2)	BRIDGE NO.: 14
	OVER: ROARING BRANCH
FILE NAME: /PW/93j009/sj009xs.dgn	PLOT DATE: 14-DEC-2005
PROJECT MANAGER: R. R. WHITCOMB	DRAWN BY: J. GILMORE
DESIGNED BY: C. CARLSON	IPARM NAME: sj009mbd.1
	SHEET 51 OF 67