




| REVISIONS |     | DATE    | APPROVED |
|-----------|-----|---------|----------|
| ZONE      | REV |         |          |
| ...       | A   | 8/20/06 | C.A.M.   |
| ...       | B   | 1/17/08 | C.A.M.   |
| ...       | C   | 3/29/07 | C.A.M.   |

RECEIVED  
 FEB 23 2007  
 CTD BY: *CLM*  
 RESUBMITTED BY: *CLM*  
 APPROVED BY: *ANDRUCIO*  
 DATE:

NOTES  
 1. REFERENCE SHEET 7 OF 7 FOR BEARING NOTES

SUNDERLAND  
 PROJECT NO. BR# 011412  
 HIGHWAY NO. TH 3 BRIDGE NO. 13  
 OVER FORKING BRANCH

STRUCTURAL PRODUCTS CORP.  
**AMSCOT**  
 DOVER, NJ  
 JOB# 2291  
 APPROV'D: [SIGNATURE] C.A.M.  
 DATE: 8/2/06 BY: [SIGNATURE] C  
 FOR: PETRICA CONSTRUCTION COMPANY  
 DWG. NO. P08A4ARC SHEET NO. 3 OF 7

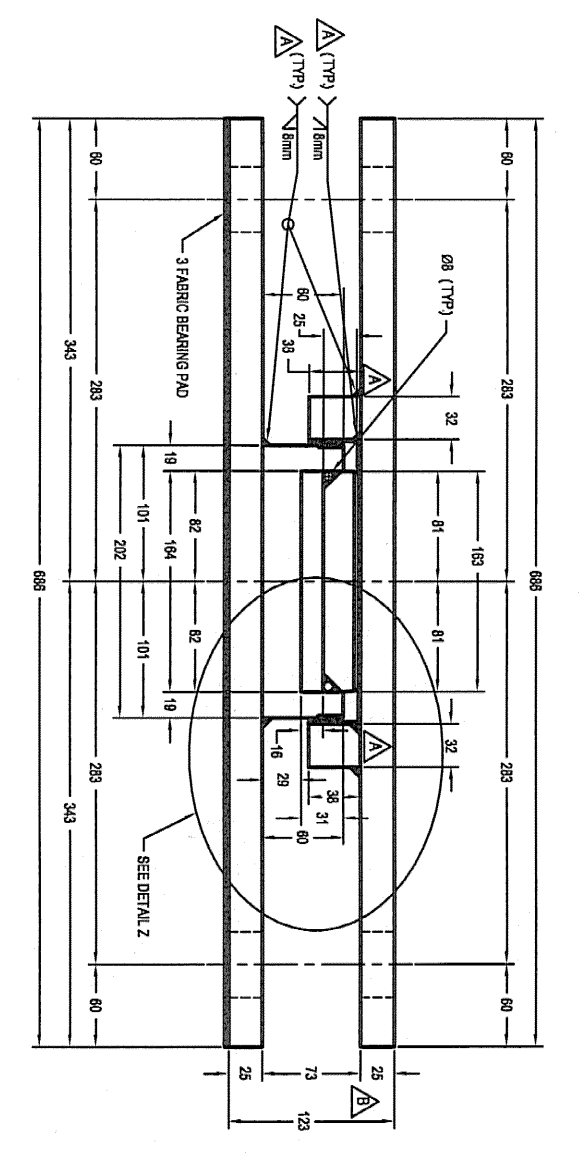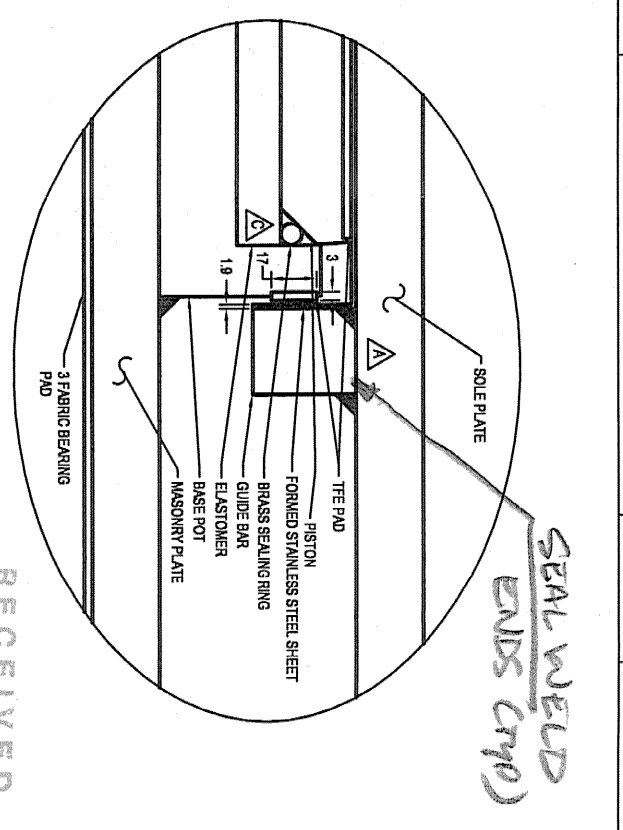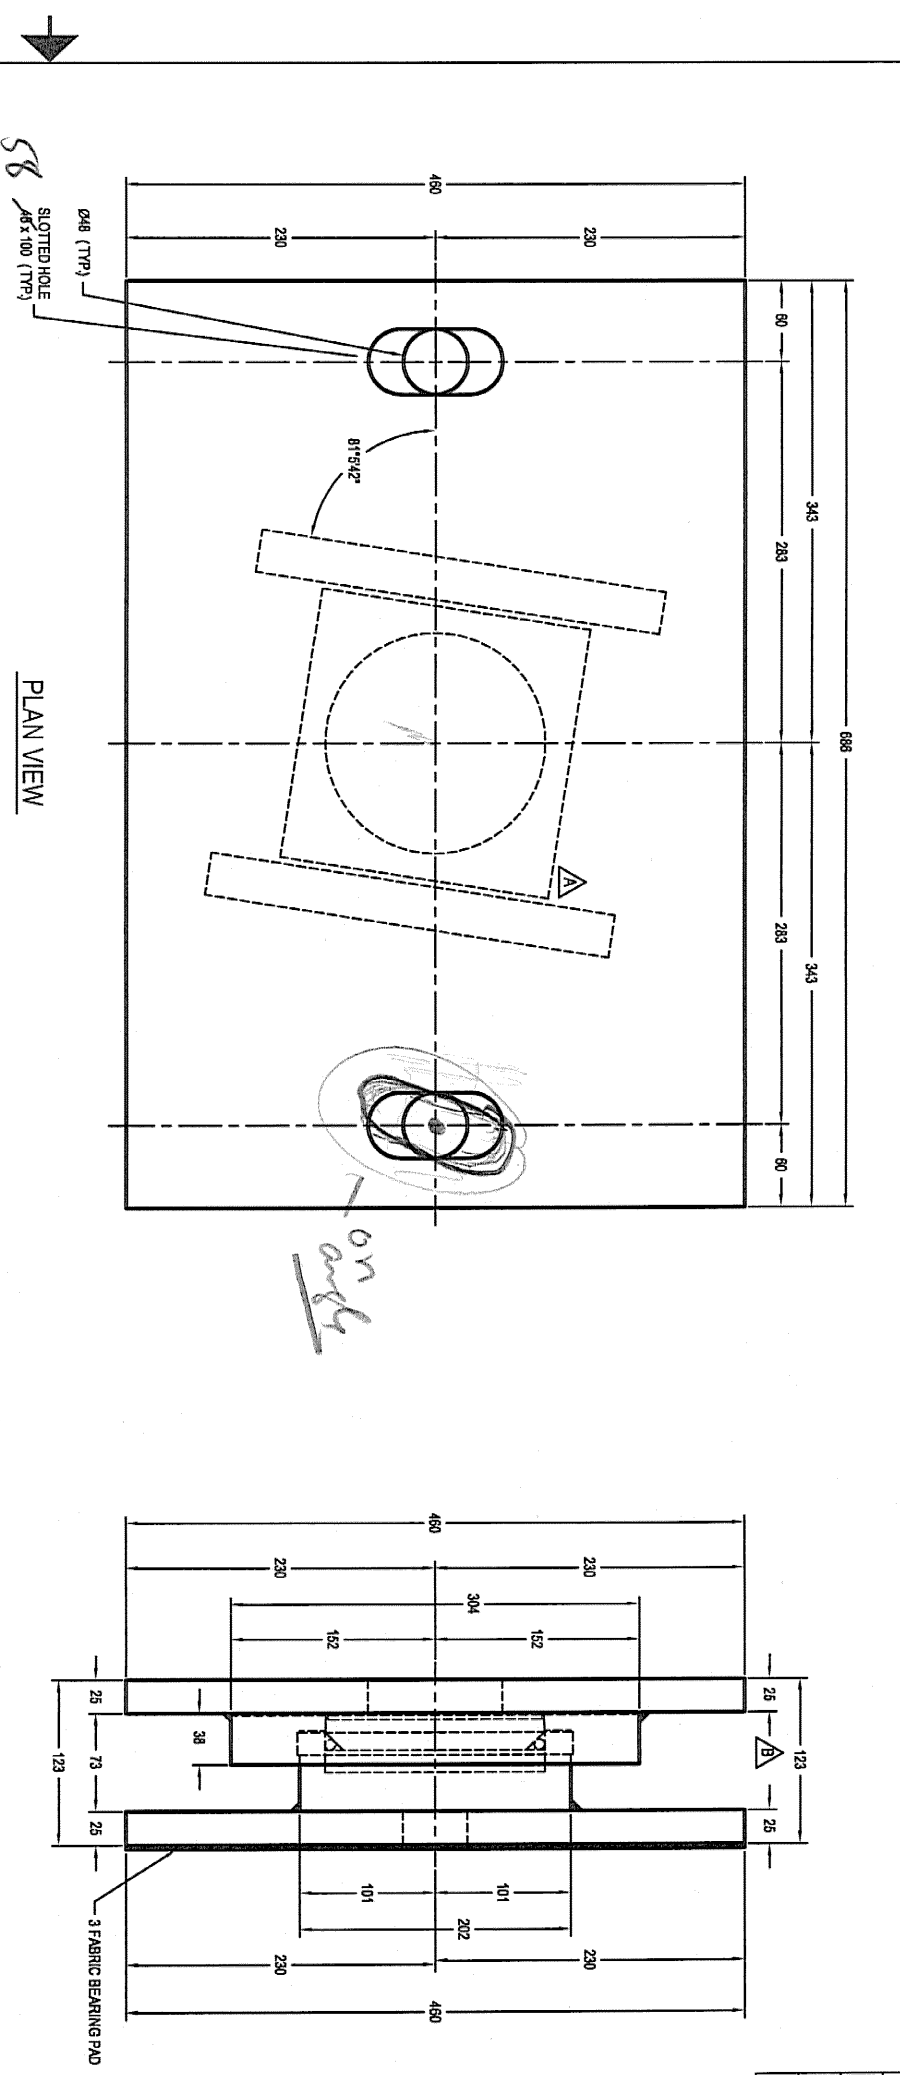

ELEVATION VIEW  
 1/8\"/>