



SECTION A
SCALE: 1:10

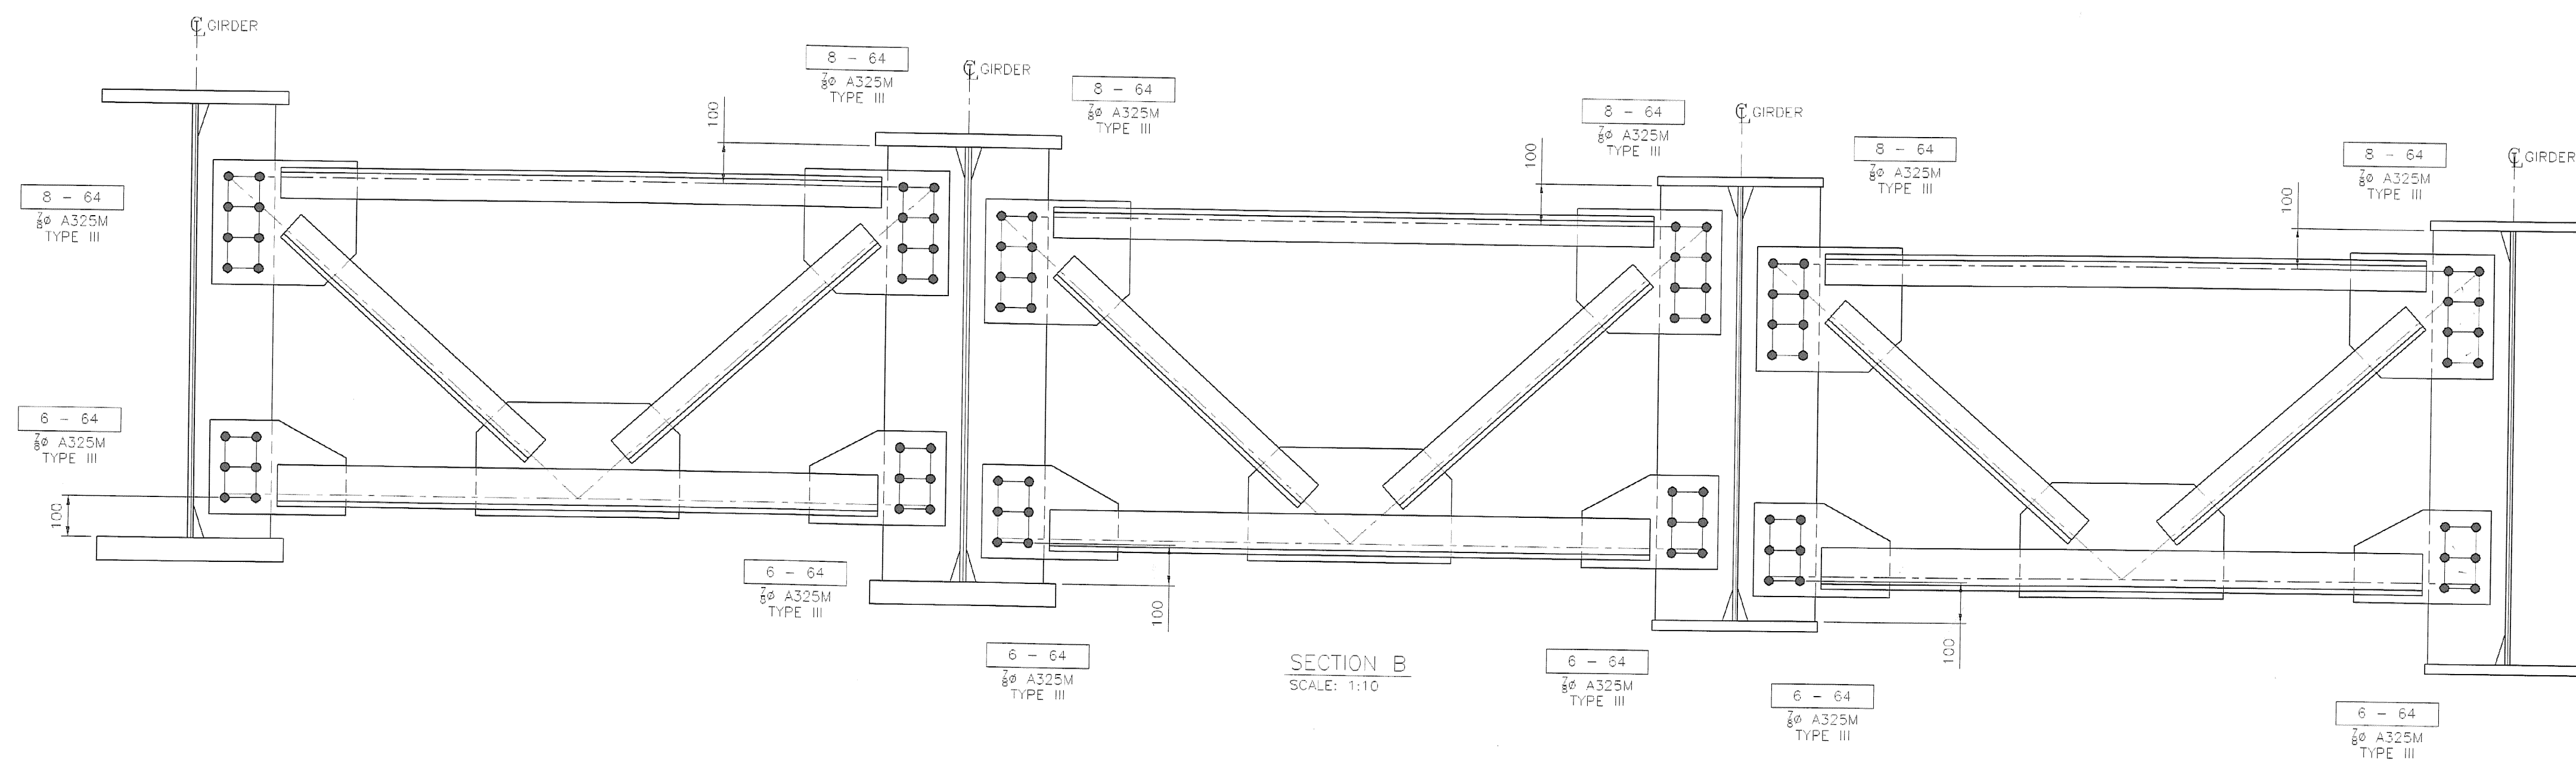

SECTION B
SCALE: 1:10

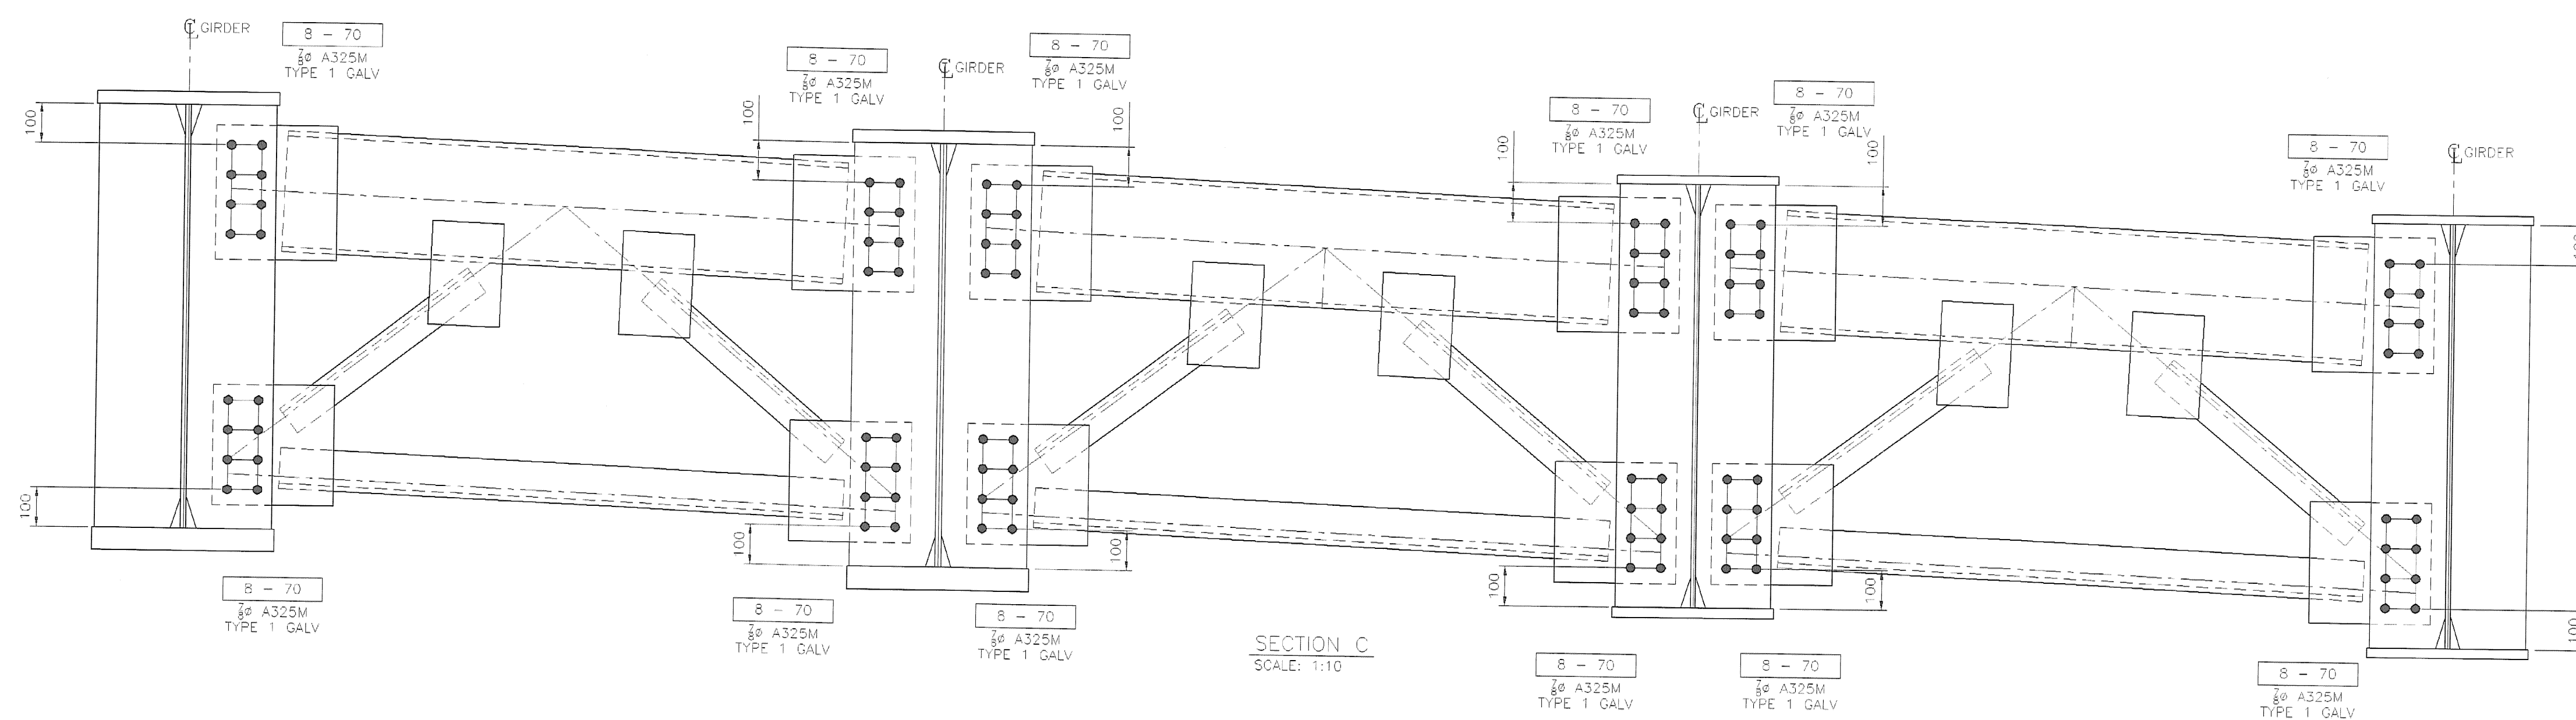

SECTION C
SCALE: 1:10

RECEIVED
 CK'D BY *CWC* CK'D BY *DRP*
 MAR 07 2007
 RESUBMIT APPROVED
 BY *CWC* DATE *3/30/07*

ALL MATERIAL (EXCEPT BOLTS) TO BE ASTM:	A709M-50W
ALL WELDS TO BE MADE WITH ELECTRODES SERIES E7XX	
OPEN HOLES ARE FOR H.S. BOLTS AND ARE TO BE FREE OF BURRS AND SCALE	
BOLTS: 7/8" M 164M TYPE III	OPEN HOLES: 24 UN PAINT: SEE GN-1
International Bridge & Iron Co. 90 Day Street Newington, CT. 06111	
VERMONT DOT SUNDERLAND BRIDGE FED. AID PROJ. NO.: BRF-014 (2) CONTRACTOR: PETRICCA CONSTRUCTION CORP. ENGINEER: ROGER WHITCOMB	
For Approval/Revised/Issue to Shop	SECTIONS
Drawn by: <i>K.B.</i> Date: <i>02/27/07</i> (Date) - <i>MM/JJ/AA</i>	
Contract	Suffix Dwg. Number
606	E2