


WEB CUTTING WC1
 wc1a = PL 13
 wc1b = PL 13

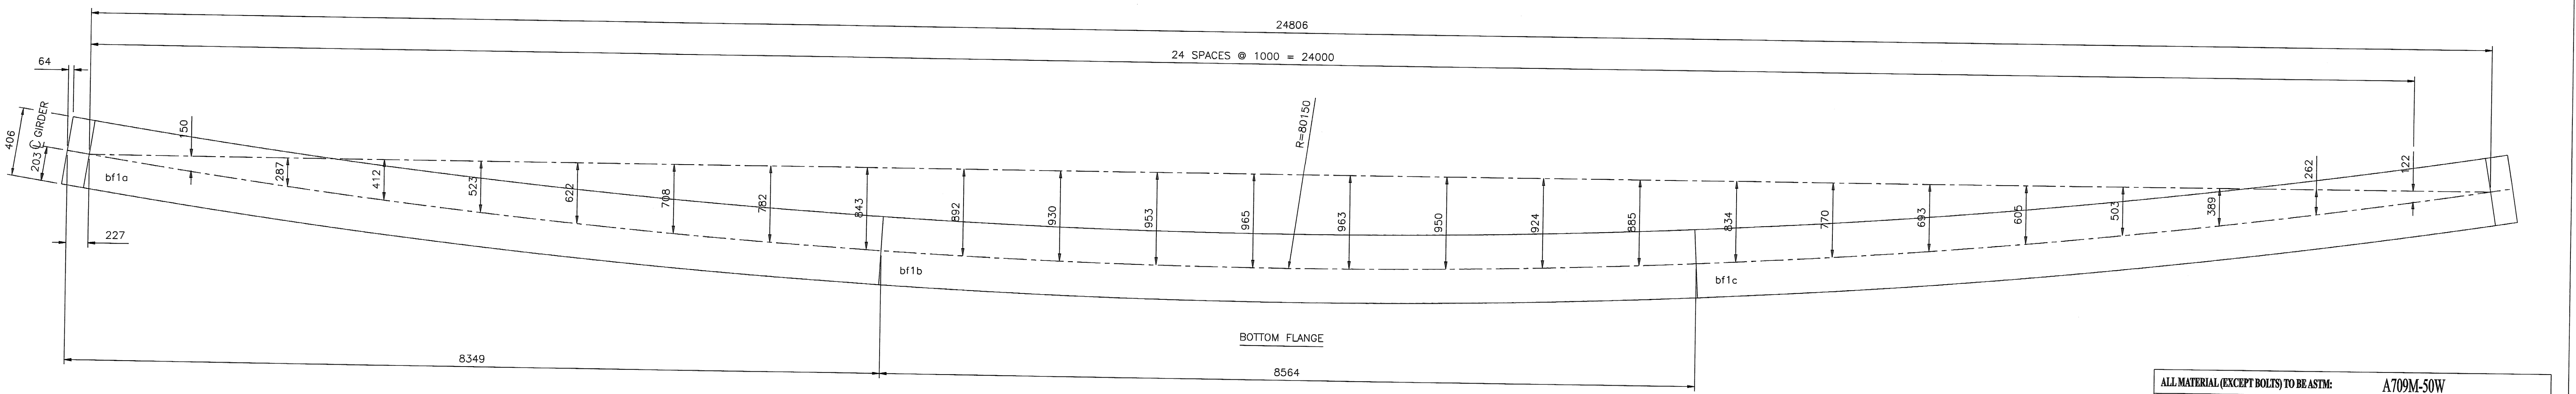

RECEIVED
 OK'D BY: *[Signature]* OK'D BY: *[Signature]*
 MAR 29 2007
 RESUBMIT: _____ APPROVED: *[Signature]*
 BY: *[Signature]* DATE: 3/30/07

ALL MATERIAL (EXCEPT BOLTS) TO BE ASTM: A709M-50W	
ALL WELDS TO BE MADE WITH ELECTRODES SERIES E70XX	
OPEN HOLES ARE FOR H.S. BOLTS AND ARE TO BE FREE OF BURRS AND SCALE	
BOLTS: 7/8 A325M TYPE III	OPEN HOLES: 24 UN PAINT: SEE GN-1
International Bridge & Iron Co. 90 Day Street Newington, CT. 06111	
VERMONT DOT SUNDERLAND BRIDGE FED. AID PROJ. NO.: BRP-0114 (2) CONTRACTOR: PETRICCA CONSTRUCTION CORP. ENGINEER: ROGER WHITCOMB	
For Approval	Revised / Issue to Shop
1	WEB CUTTING G1
Drawn by: D.E.	Checked by: G.D.
Date: 02/05/07	Date: 02/27/07
Contract	Suffix
606	WC1