


WEB CUTTING WC2
 wc2a = PL 13
 wc2b = PL 13

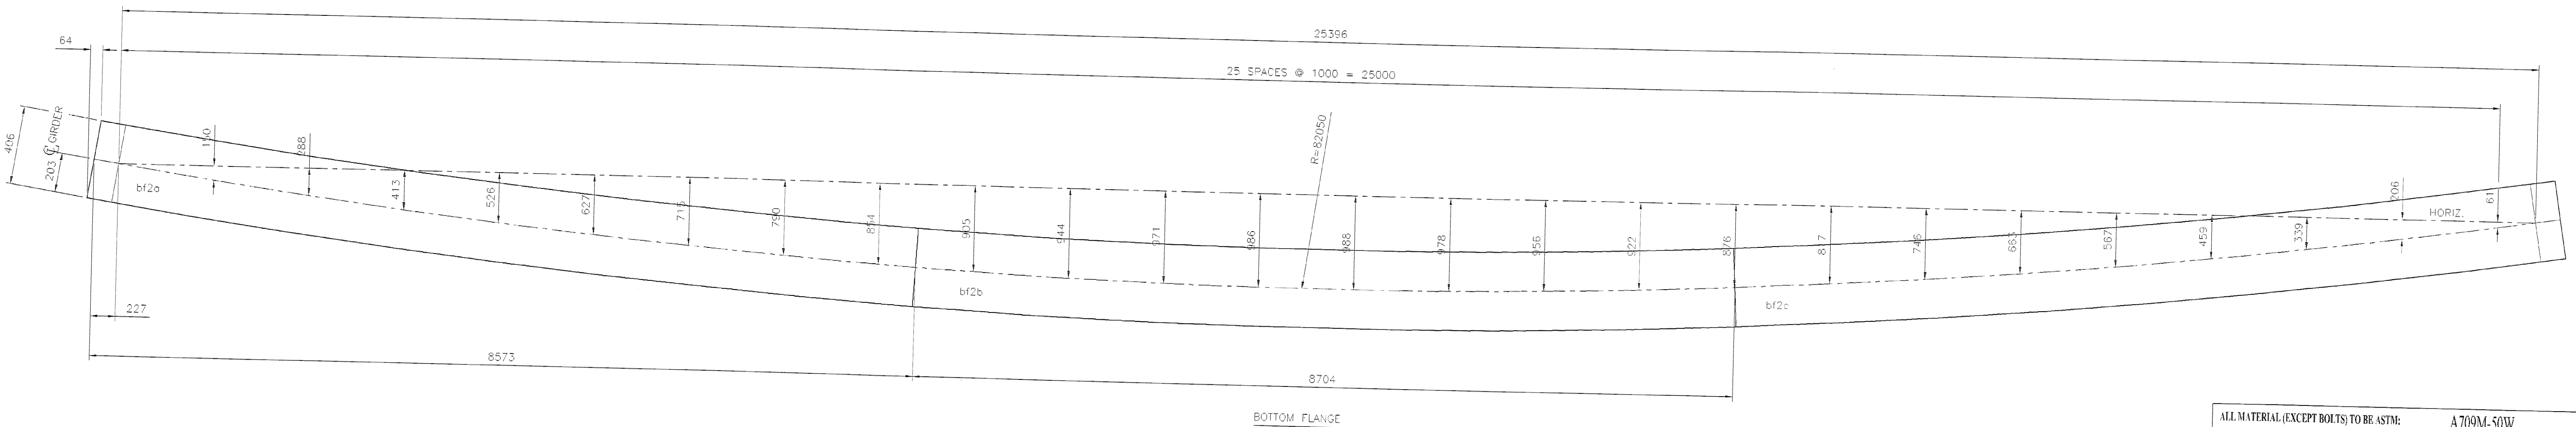

RECEIVED
 OK'D BY: *[Signature]* OK'D BY: DRD
 MAR 07 2007
 RESUBMIT APPROVED
 BY: *cwe* DATE: 3/31/07

ALL MATERIAL (EXCEPT BOLTS) TO BE ASTM: A709M-50W	
ALL WELDS TO BE MADE WITH ELECTRODES SERIES E7XX	
OPEN HOLES ARE FOR H.S. BOLTS AND ARE TO BE FREE OF BURRS AND SCALE	
BOLTS: 7/8" M 16HM TYPE III	OPEN HOLES: 3/4" UN PAINT: SEE GN-1
International Bridge & Iron Co. 90 Day Street Newington, CT. 06111	
VERMONT DOT SUNDERLAND BRIDGE FED. AID PROJ. NO.: BRP-0114 (2) CONTRACTOR: PETRICA CONSTRUCTION CORP. ENGINEER: ROGER WHITCOMB	
For Approval/Revised/Issue to Shop	WEB CUTTING G2
Drawn by: D.E. Date: 02/05/07	Checked by: G.L. Date: 02/27/07
Contract	Suffix
Dwg. Number	
606	WC2