


WEB CUTTING WC3
 wc3a = PL 14
 wc3b = PL 14

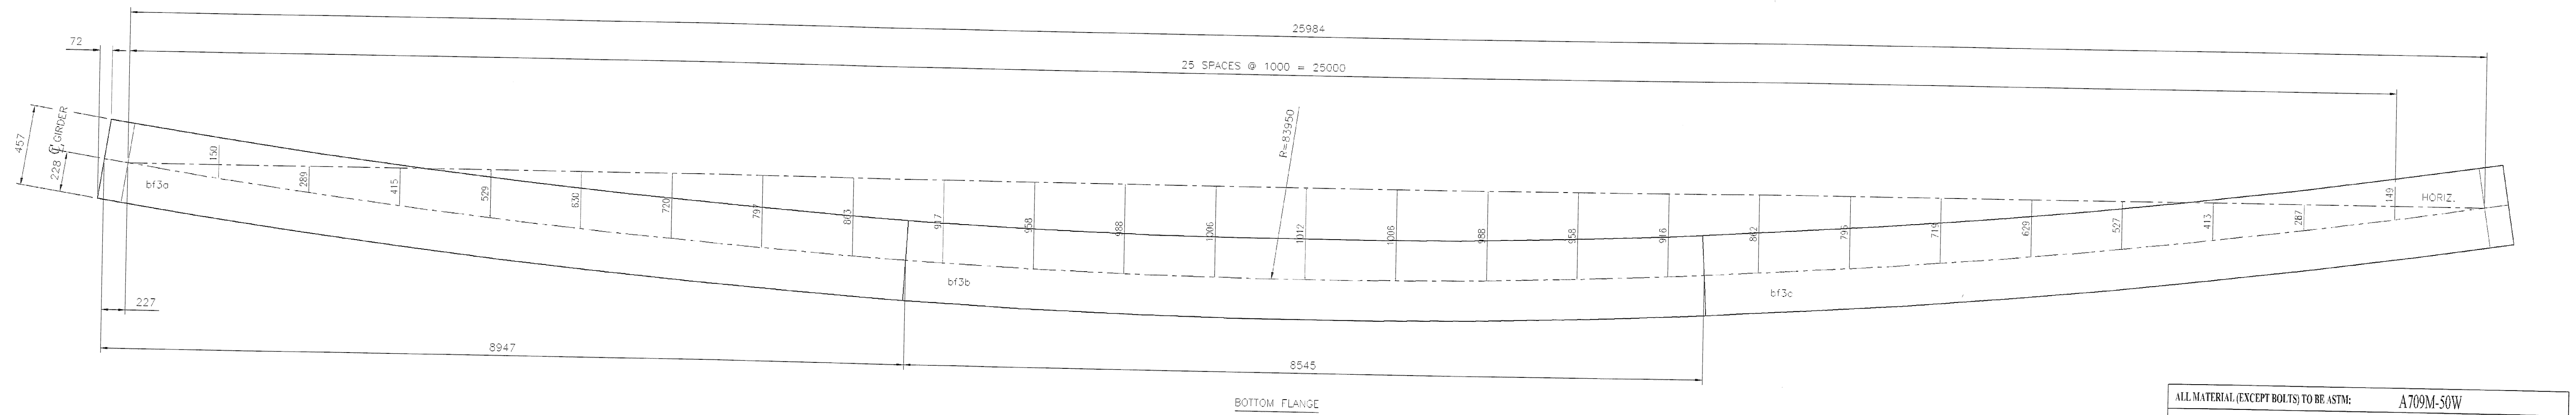

RECEIVED
 OK'D BY: *CWC* / *DRP*
 MAR 07 2007
 RESUBMIT APPROVED
 BY: *CWC* DATE: 3/30/07

| | |
|---|-----------------------------------|
| ALL MATERIAL (EXCEPT BOLTS) TO BE ASTM: A709M-50W | |
| ALL WELDS TO BE MADE WITH ELECTRODES SERIES E6XX | |
| OPEN HOLES ARE FOR H.S. BOLTS AND ARE TO BE FREE OF BURRS AND SCALE | |
| BOLTS: 3/8" M16M TYPE III | OPEN HOLES: 24 UN PAINT: SEE GX-1 |
| International Bridge & Iron Co. 90 Day Street Newington, CT, 06111 | |
| VERMONT DOT SUNDERLAND BRIDGE FED. AID PROJ. NO.: BRF-0114 (2) CONTRACTOR: PETRICCA CONSTRUCTION CORP. ENGINEER: ROGER WHITCOMB | |
| For Approval | Revised Issue to Shop |
| WEB CUTTING G3 | |
| Drawn by D.E. | 02/19/07 |
| Checked by G.L. | 02/26/07 |
| Contract | Suffix Dwg. Number |
| 606 | WC3 |