



CF5A (1 REQ'D)
SCALE: 1:10
NO PAINT

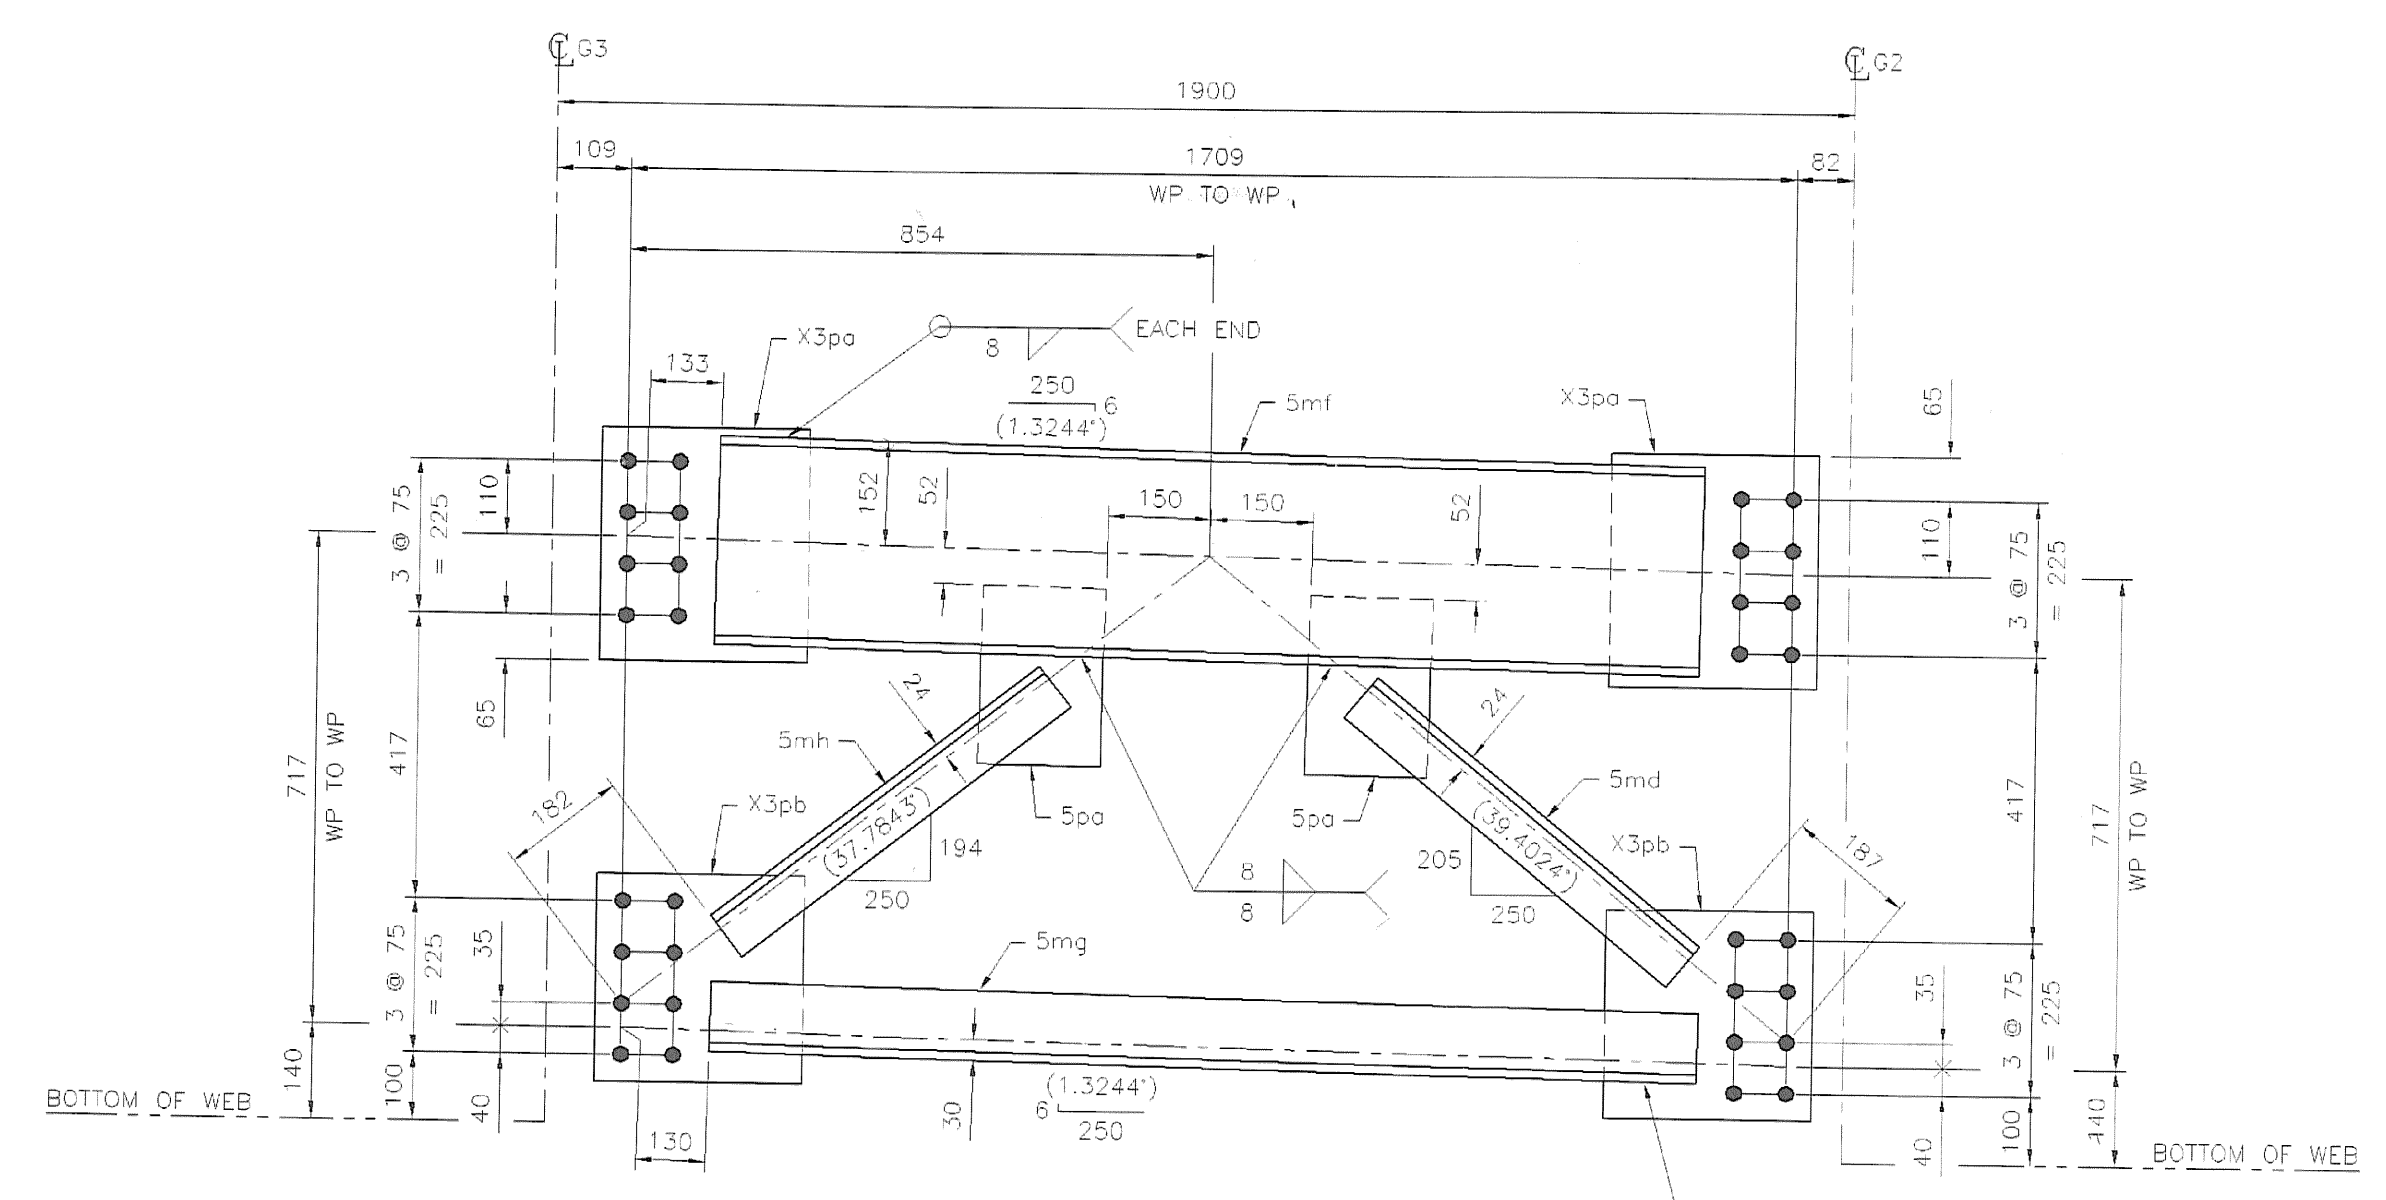

CF5B (1 REQ'D)
SCALE: 1:10
NO PAINT

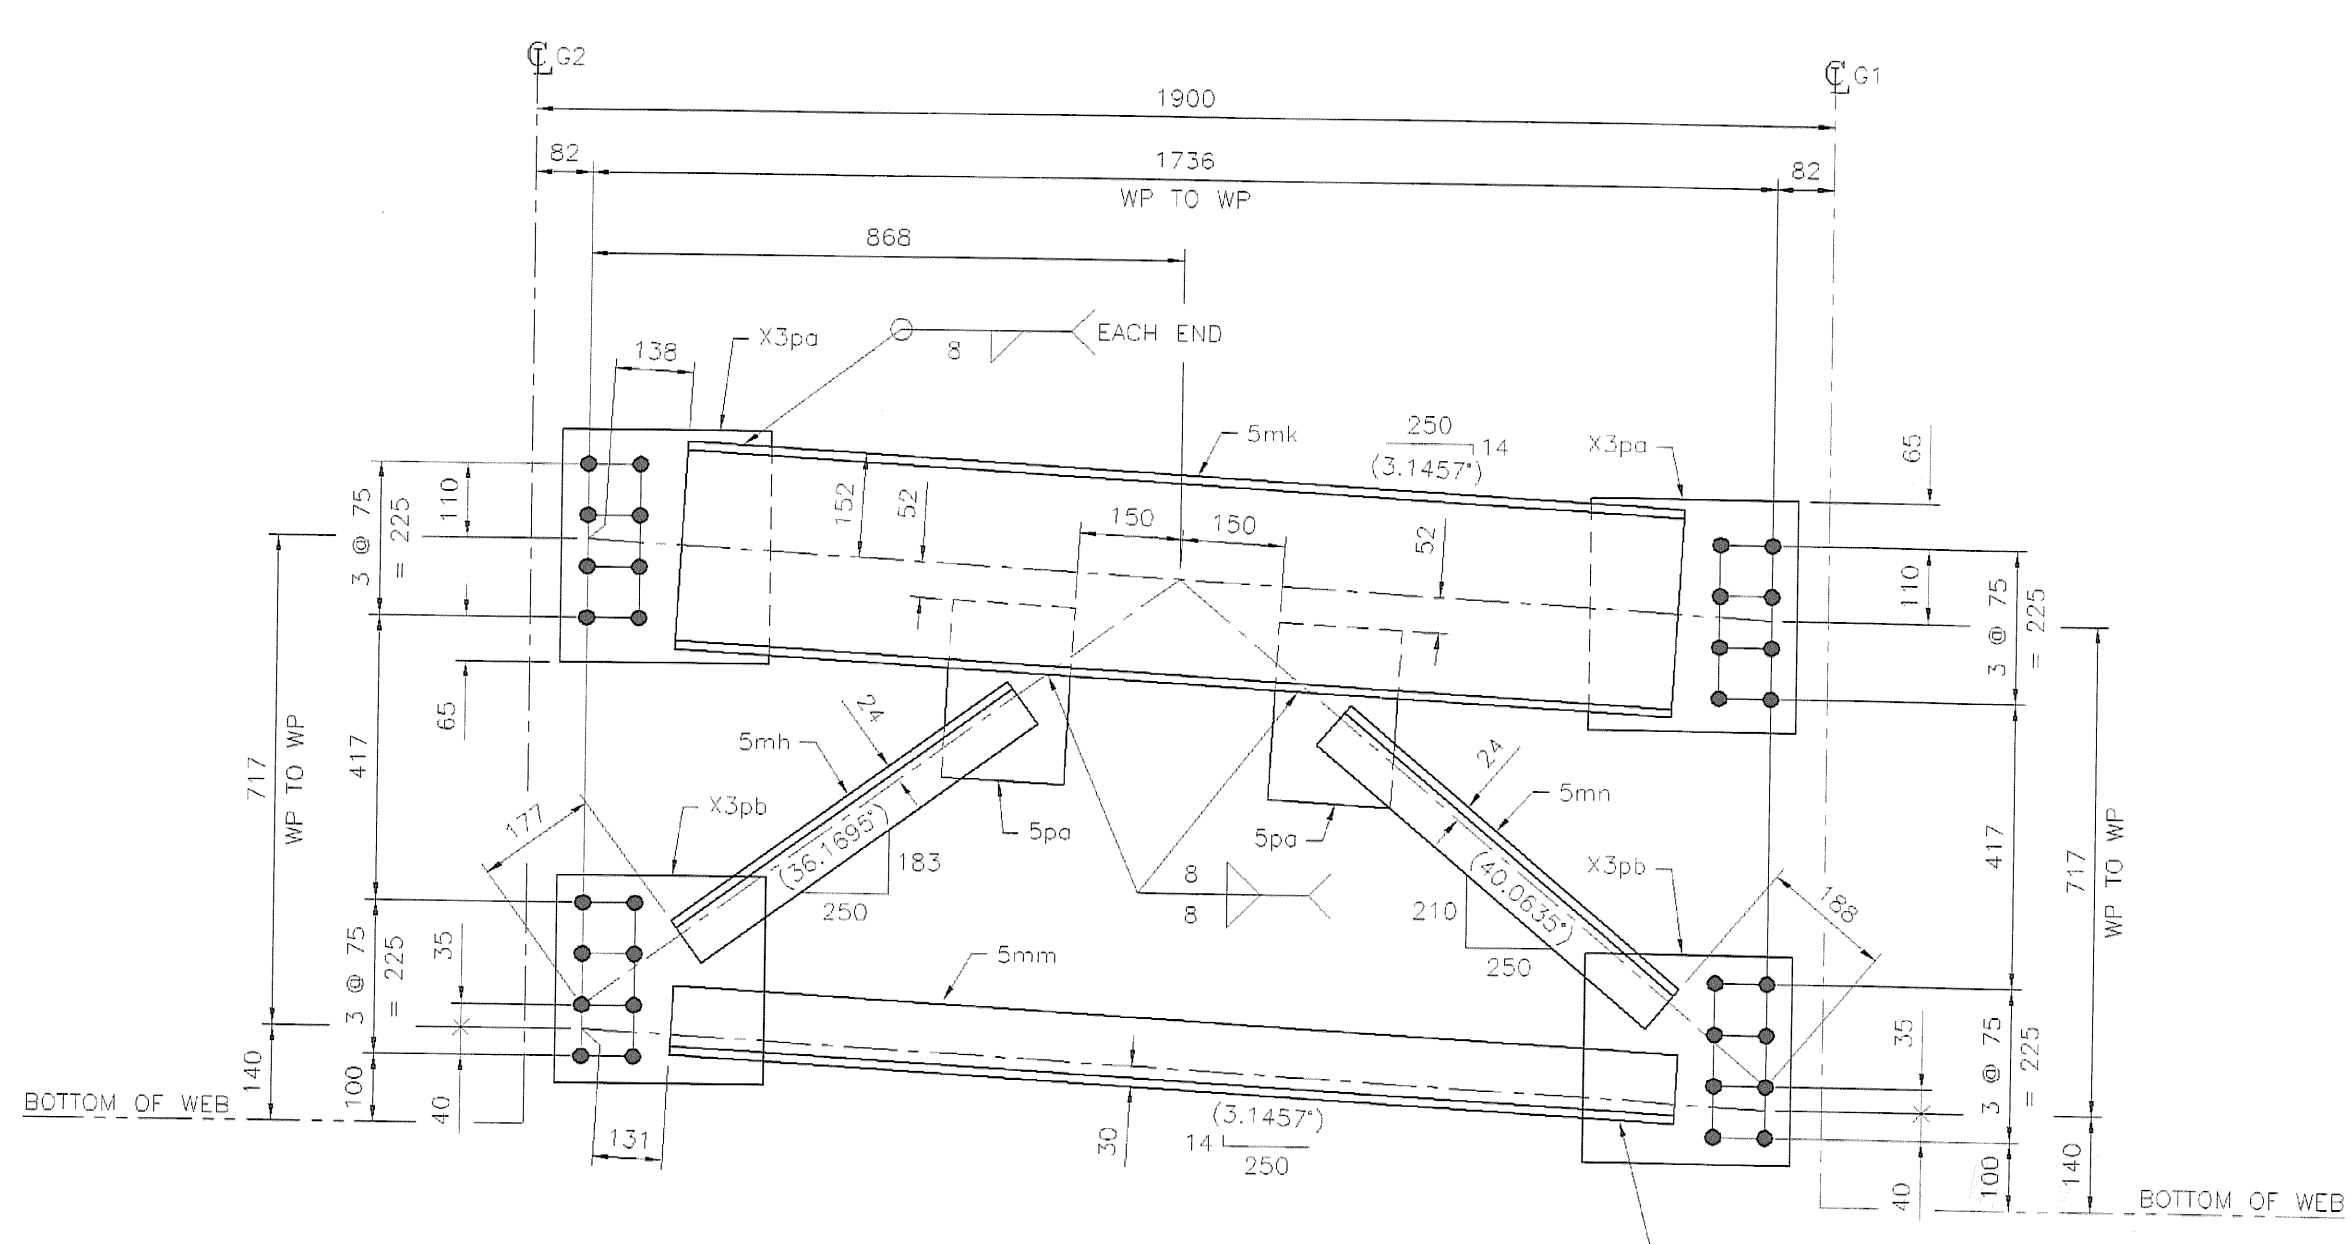

CF5C (1 REQ'D)
SCALE: 1:10
NO PAINT

SHOP BILL									
LINE	MARK	NUMBER	SHAPE	SECTION	FINISHED LENGTH mm	ITEM NO.	REMARKS	Weight kg	
1	CF5A	1						157	
2	5ma	1	C	310x45	1411			63	
3	5mb	1	L	102x102x13	1421			27	
4	5mc	1	L	76x76x13	590			8	
5	5md	1	L	76x76x13	615			9	
6	5pe	2	PL	13x180	260			10	
7	X3pa	2	PL	13x305	340			21	
8	X3pb	2	PL	13x305	305			19	
9									
10	CF5B	1						180	
11	5mf	1	C	310x45	1444			65	
12	5md	1	L	76x76x13	615			9	
13	5mq	1	L	102x102x13	1449			28	
14	5mh	1	L	76x76x13	605			8	
15	5pa	2	PL	13x180	260			10	
16	X3pa	2	PL	13x305	340			21	
17	X3pb	2	PL	13x305	305			19	
18									
19	CF5C	1						161	
20	5mh	1	L	76x76x13	605			8	
21	5mk	1	C	310x45	1463			66	
22	5mn	1	L	102x102x13	1474			28	
23	5mo	1	L	76x76x13	635			9	
24	5pa	2	PL	13x180	260			10	
25	X3pa	2	PL	13x305	340			21	
26	X3pb	2	PL	13x305	305			19	
27									
28									
ALL MATERIAL (EXCEPT BOLTS) TO BE ASTM: A709M-50W
 ALL WELDS TO BE MADE WITH ELECTRODES SERIES E70XX
 OPEN HOLES ARE FOR U.S. BOLTS AND ARE TO BE FREE OF BURRS AND SCALE
 BOLTS: 7/8" M 16MM TYPE III OPEN HOLES: 24 UN PAINT: SEE GN-1

International Bridge & Iron Co.
 90 Day Street
 Newington, CT 06111

VERMONT DOT
 SUNDERLAND BRIDGE
 FED. AID PROJ. NO.: BRP-0114 (2)
 CONTRACTOR: PETRICCA CONSTRUCTION CORP.
 ENGINEER: ROGER WHITE/OMB

For Approval/Revised/Issue to Shop END CROSSFRAMES
 Drawn by J.V. Date 02/18/07 G.D. Date 02/27/07
 Contract Suffix Dwg. Number
 606 5

RECEIVED
 CK'D BY *CWC* OK'D BY *DRP*
 MAR 07 2007
 RESUBMITTED APPROVED AS NOTED
 BY *CWC* DATE 3/30/07

17
 2/28/07