

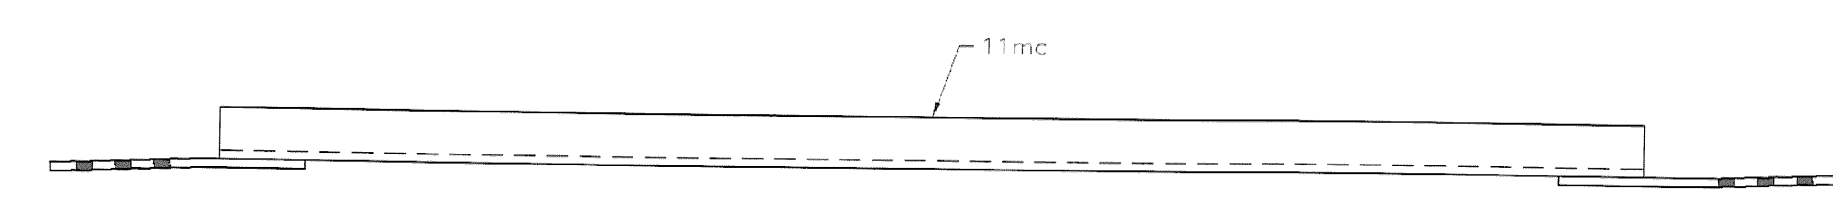
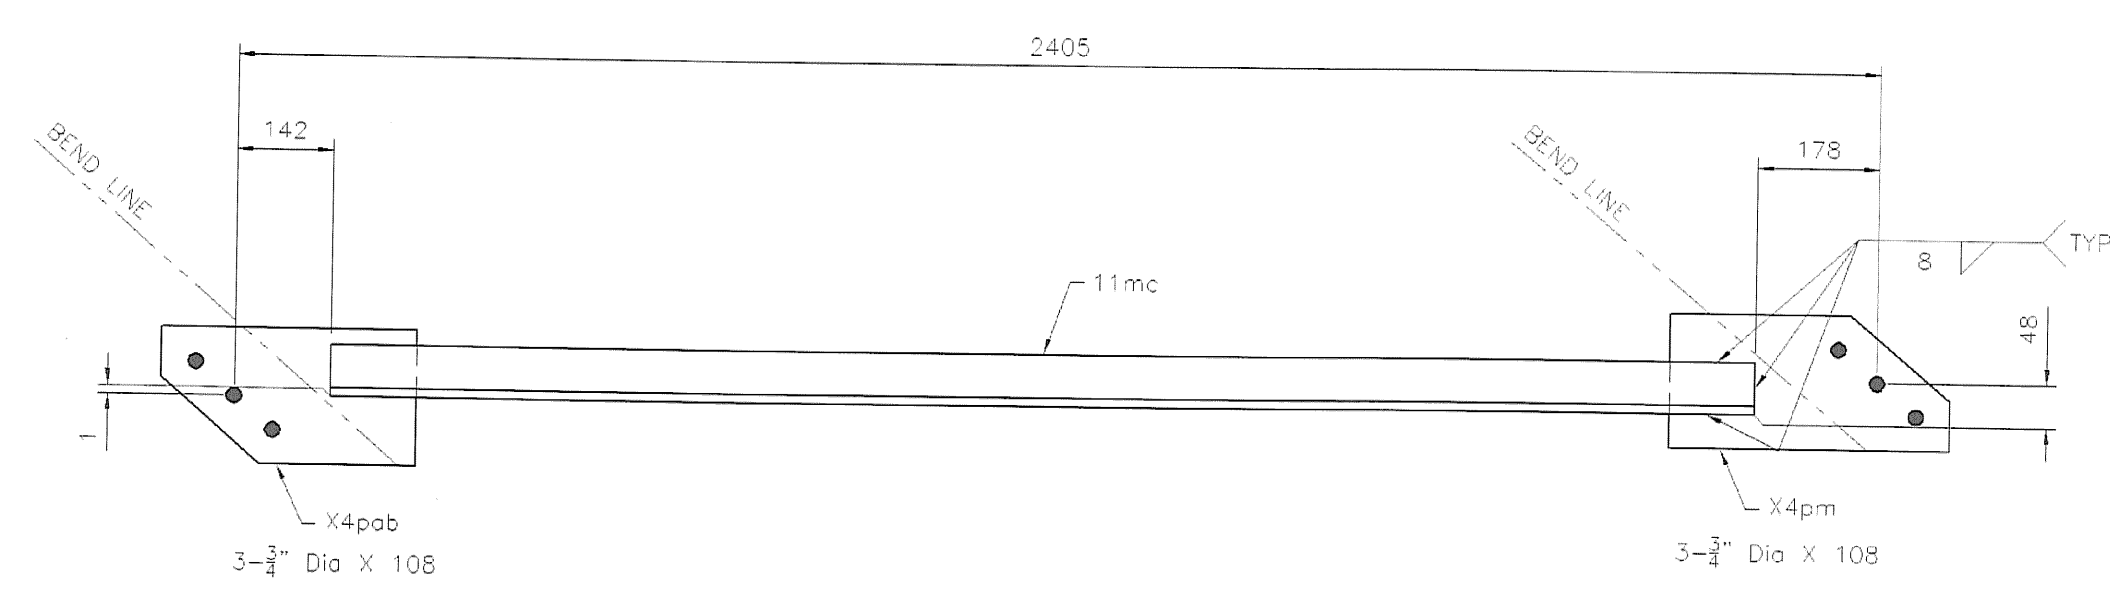




ONE HORIZONTAL BRACING LB11A

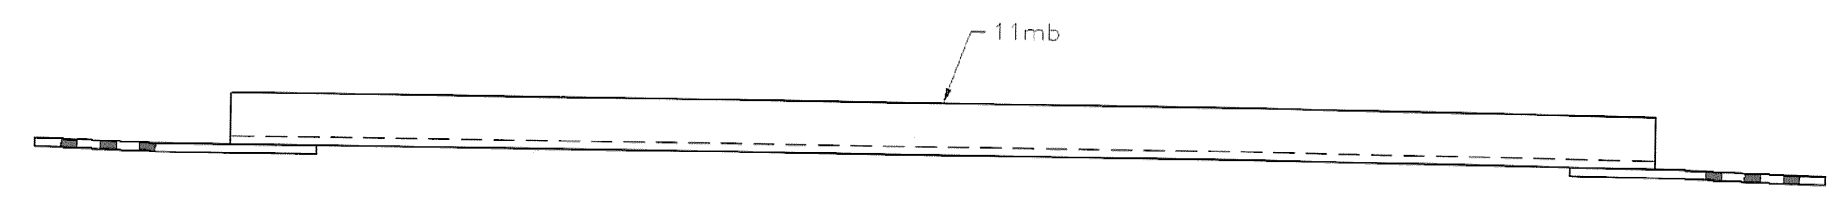

ONE HORIZONTAL BRACING LB11C

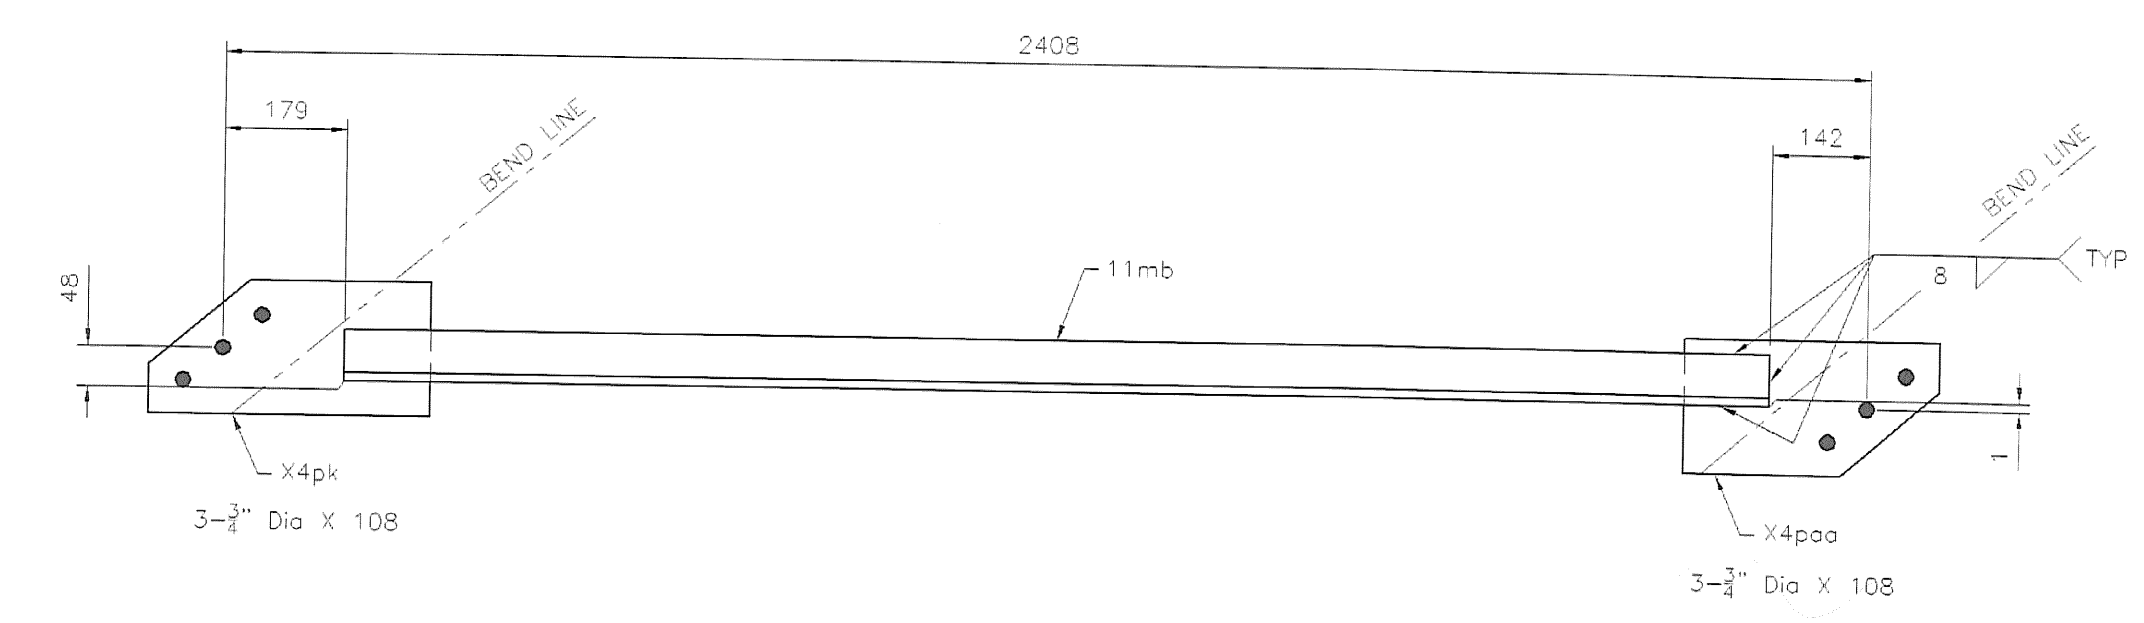

ONE HORIZONTAL BRACING LB11B

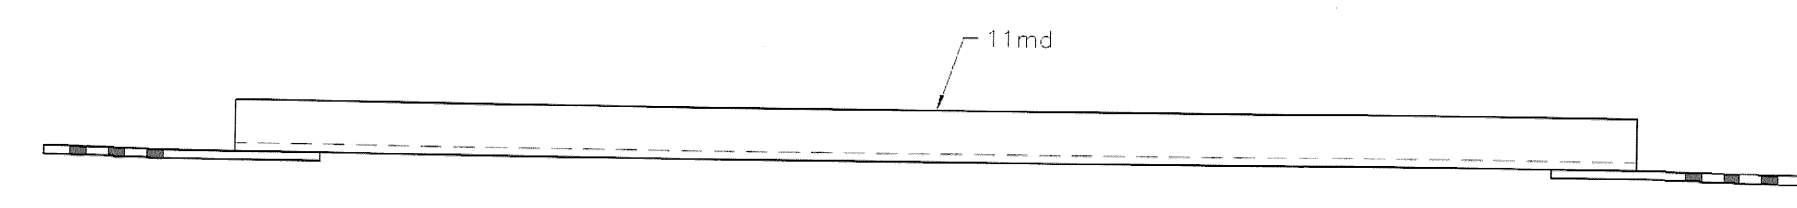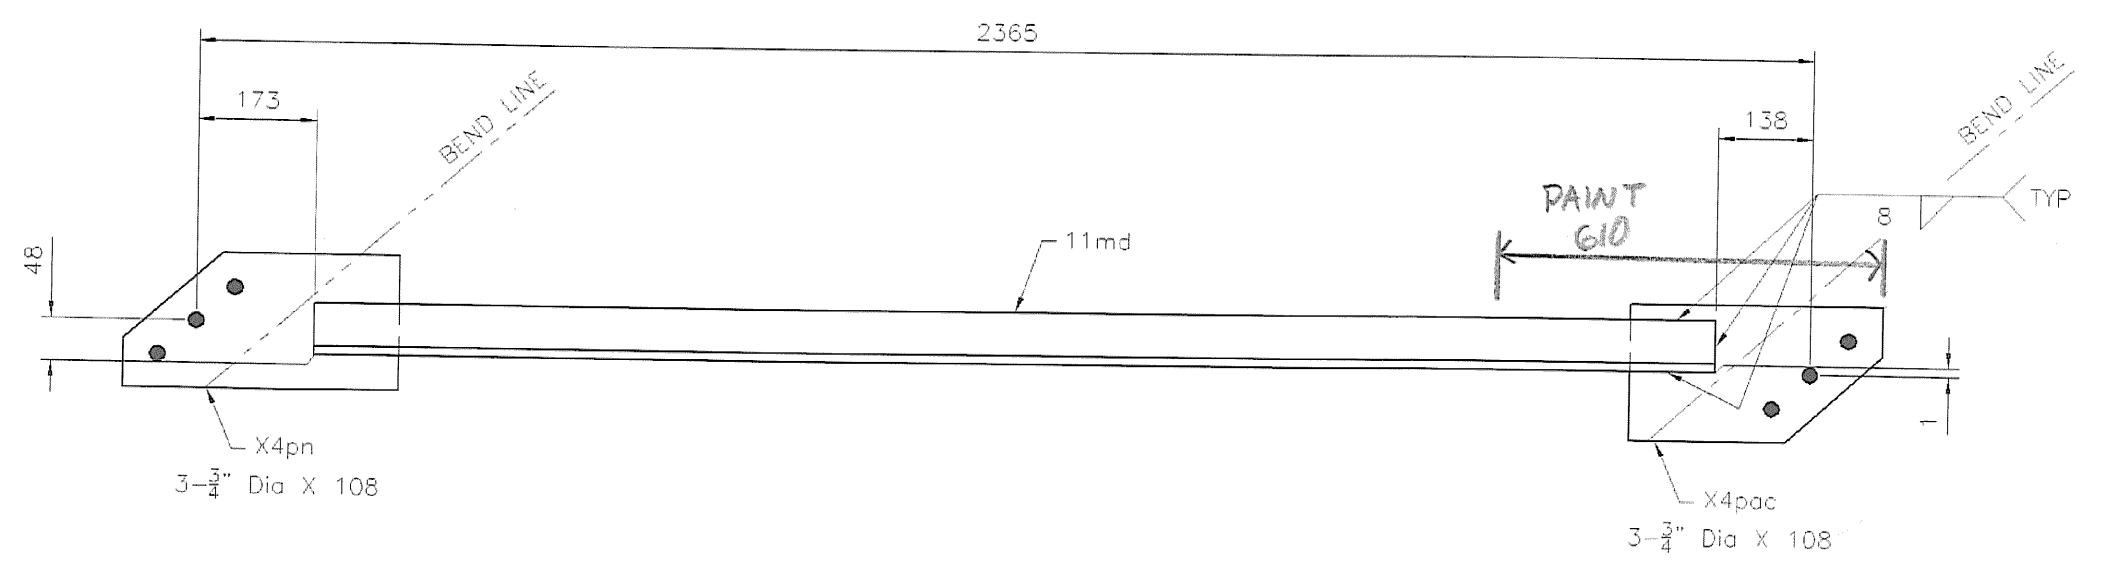

ONE HORIZONTAL BRACING LB11D

SHOP BILL

LINE	MARK	NUMBER	SECTION	FINISHED LENGTH	ITEM NO.	REMARKS	Weight lbs
1	LB11A	1	BRACING				45
2	11mo	1	L 76x76x13	2091			29
3	X4ph	1	PL 13x197	410			8
4	X4py	1	PL 13x198	373			8
5	FB		FIELD BOLTS				
6	34F108D	6	FB 3/4 A325	108		C/W2 WASHERS	
7	LB11B	1	BRACING				45
8	11mb	1	L 76x76x13	2087			29
9	X4pk	1	PL 13x196	411			8
10	X4pob	1	PL 13x198	374			8
11	FB		FIELD BOLTS				
12	34F108D	6	FB 3/4 A325	108		C/W2 WASHERS	
13	LB11C	1	BRACING				45
14	11mc	1	L 76x76x13	2085			29
15	X4pm	1	PL 13x197	411			8
16	X4pob	1	PL 13x198	373			8
17	FB		FIELD BOLTS				
18	34F108D	6	FB 3/4 A325	108		C/W2 WASHERS	
19	LB11D	1	BRACING				45
20	11md	1	L 76x76x13	2053			29
21	X4pn	1	PL 13x199	405			8
22	X4pac	1	PL 13x200	369			8
23	FB		FIELD BOLTS				
24	34F108D	6	FB 3/4 A325	108		C/W2 WASHERS	
25							
26							
ALL MATERIAL (EXCEPT BOLTS) TO BE ASTM: A709M-50W
 ALL WELDS TO BE MADE WITH ELECTRODES SERIES E6XX
 OPEN HOLES ARE FOR H.S. BOLTS AND ARE TO BE FREE OF BURRS AND SCALE
 BOLTS: 7/8" M 16MM TYPE III OPEN HOLES: 3/4" UN PAINT: SEE GX-1

International Bridge & Iron Co.
 90 Day Street
 Newington, CT. 06111

VERMONT DOT
 SUNDERLAND BRIDGE
 FED. AID PROJ. NO.: BRF-0114 (2)
 CONTRACTOR: PETRICCA CONSTRUCTION CORP.
 ENGINEER: ROGER WHITCOMB

For Approval	Revised	Issue to Shop	HORIZONTAL BRACING		
			Contract	Sheet	Dwg. Number
			606		11

RECEIVED
 OK'D BY *ML* OK'D BY *DRP*
 MAR 07 2007
 RESUBMIT APPROVED *AS NOTED*
 BY *CWE* DATE *3/30/07*