



PROFILE T.H. 4

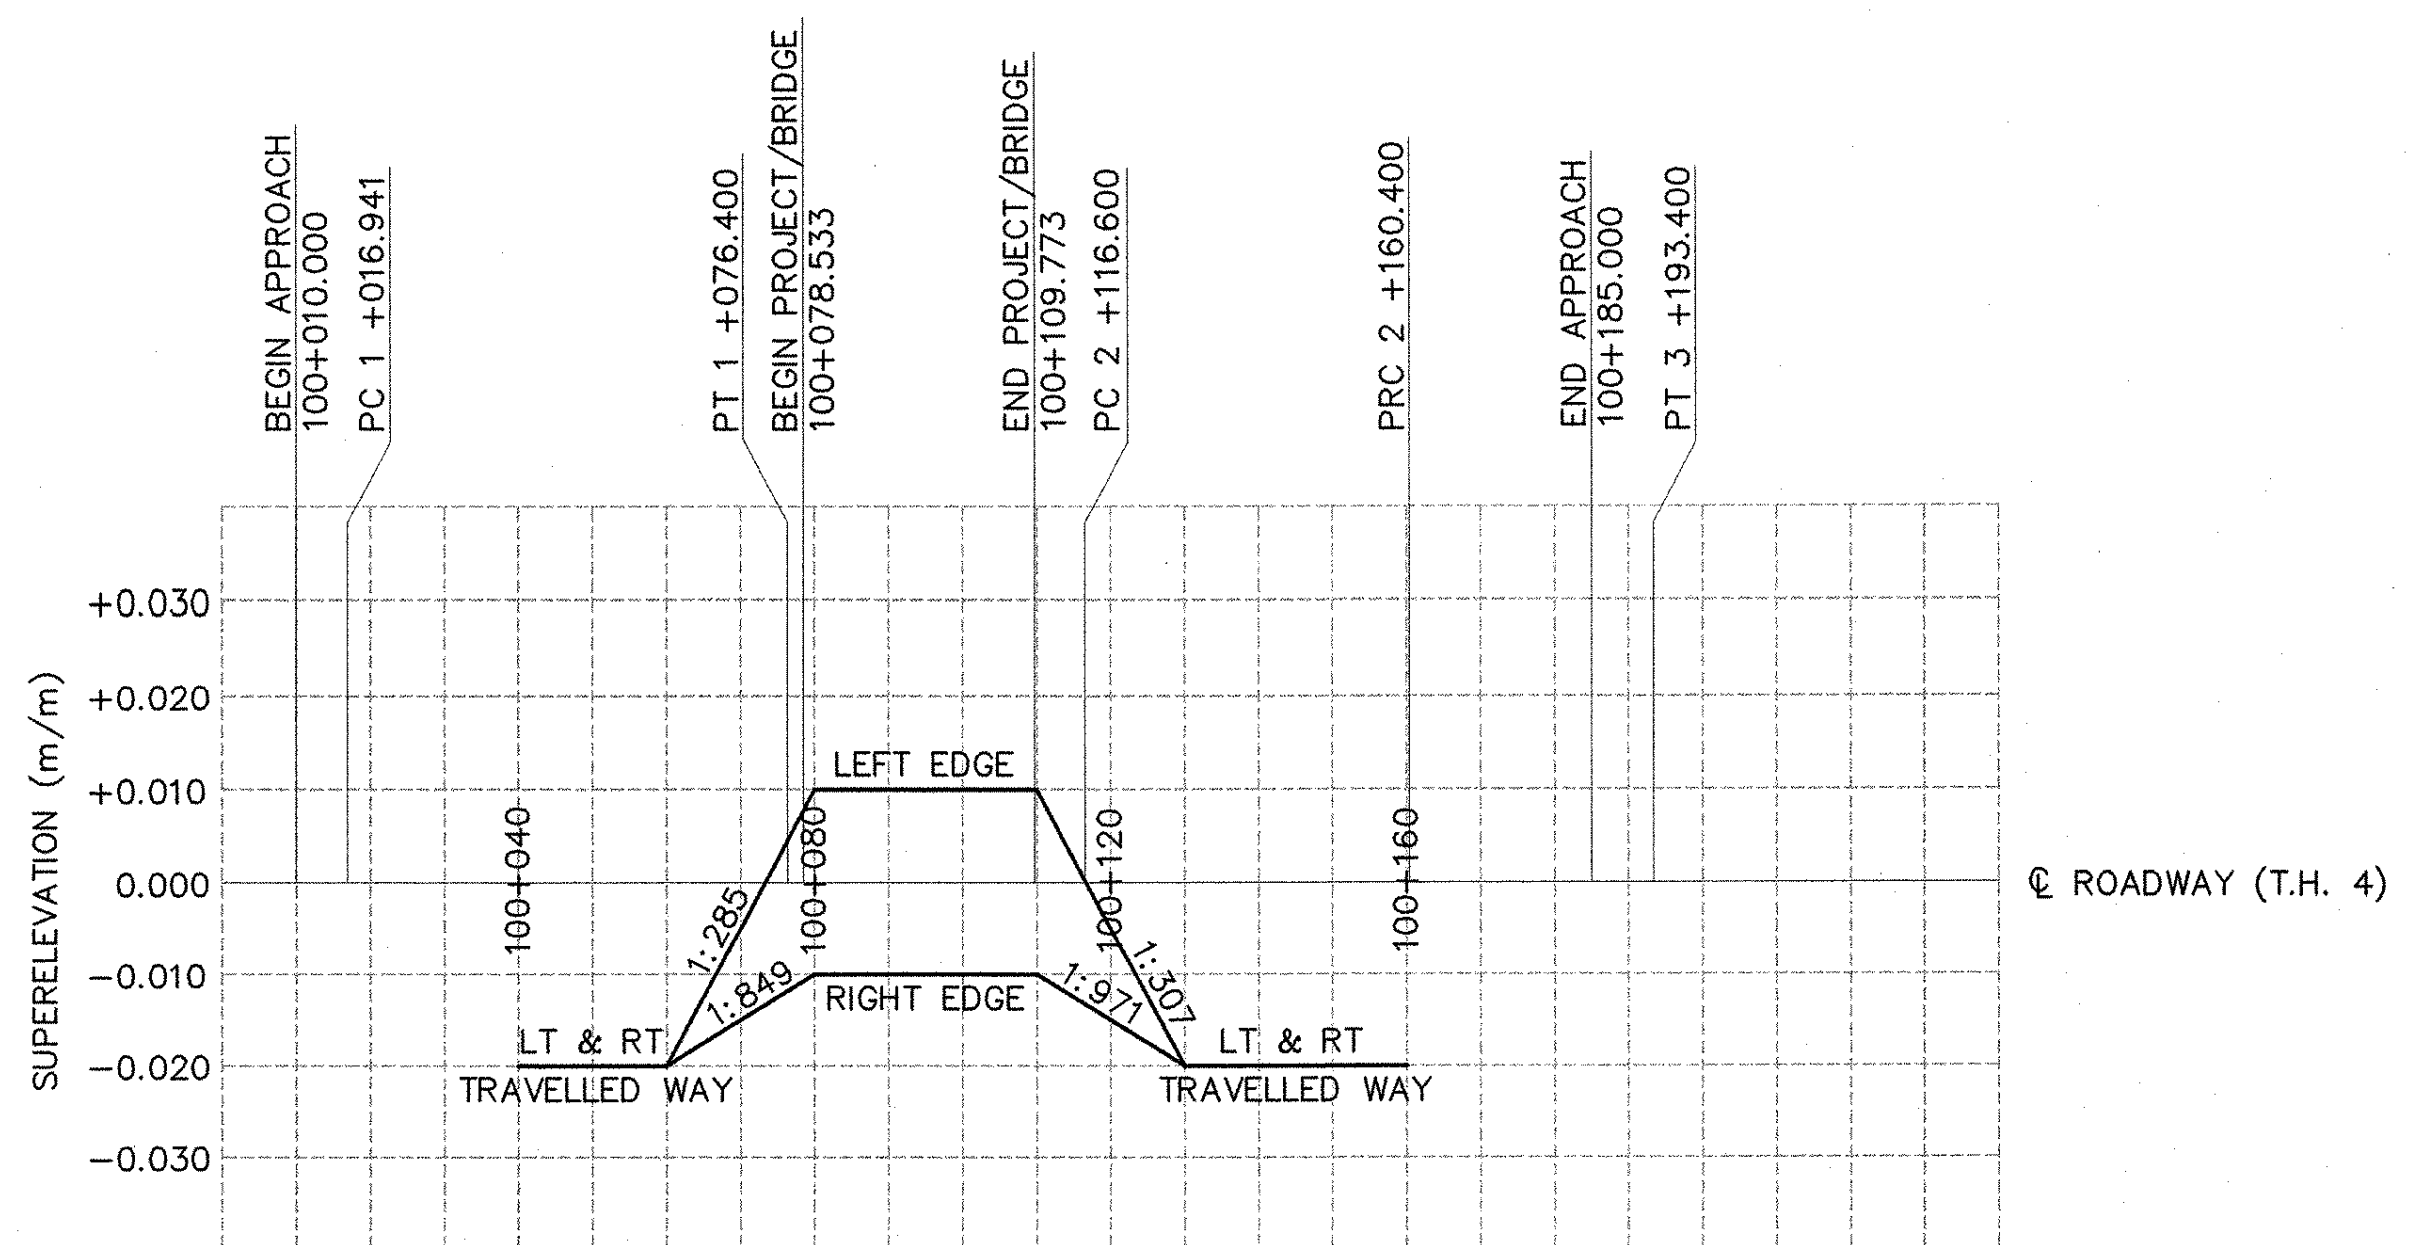

BANKING DIAGRAM

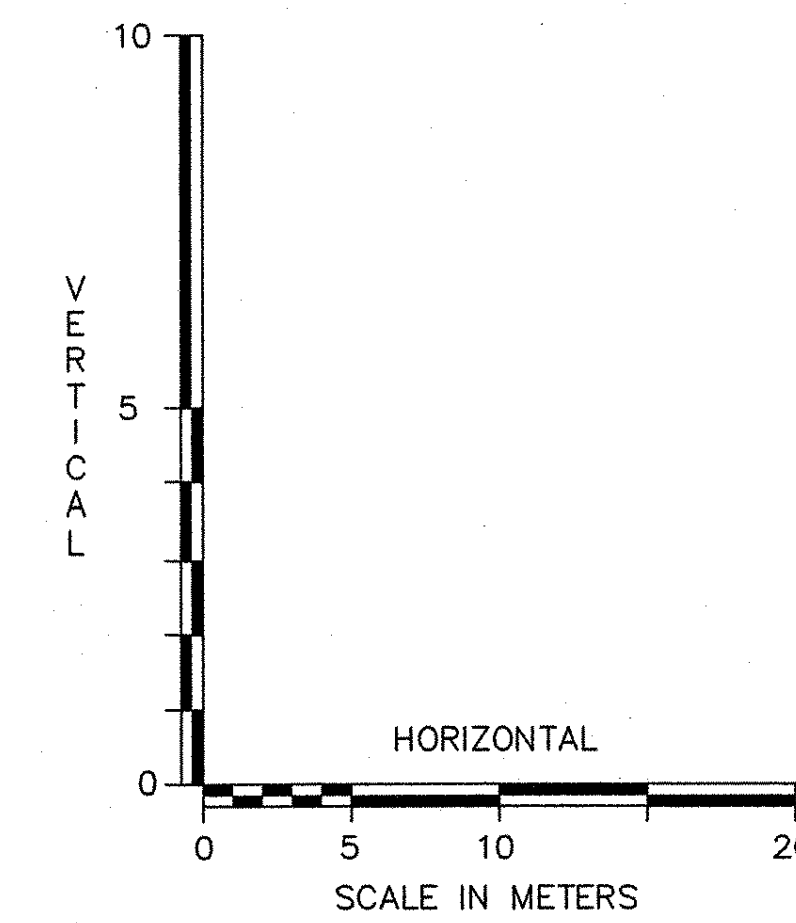

STATE OF VERMONT
AGENCY OF TRANSPORTATION

Town Of	CAVENDISH	Bridge No.	12
Highway No.	T.H. 4	Log Sta.	
		Surv. Sta.	
T.H. 4 OVER BLACK RIVER			
PROFILE			
Designed By	R.F. CLARK	Drawn By	R.F. CLARK
Checked By	Date	Bridge Design Supervisor	
T.S. BRYANT	1/04	S.W. JOHNSON	Date 1/04
PROJECT	CAVENDISH	PROJECT NO.	BHO 1442 (22)

VANASSE HANGEN BRUSTLIN, INC.

I.G.C. Info.
Bridge Sheet No. 49912PRO Sheet 8 of 34