



CHK'D PLATE 9.5 x 305 x 1370
 ONE - PLATE - A6 (AS SHOWN)
 ONE - do - B6 (EXACT OPP HAND)

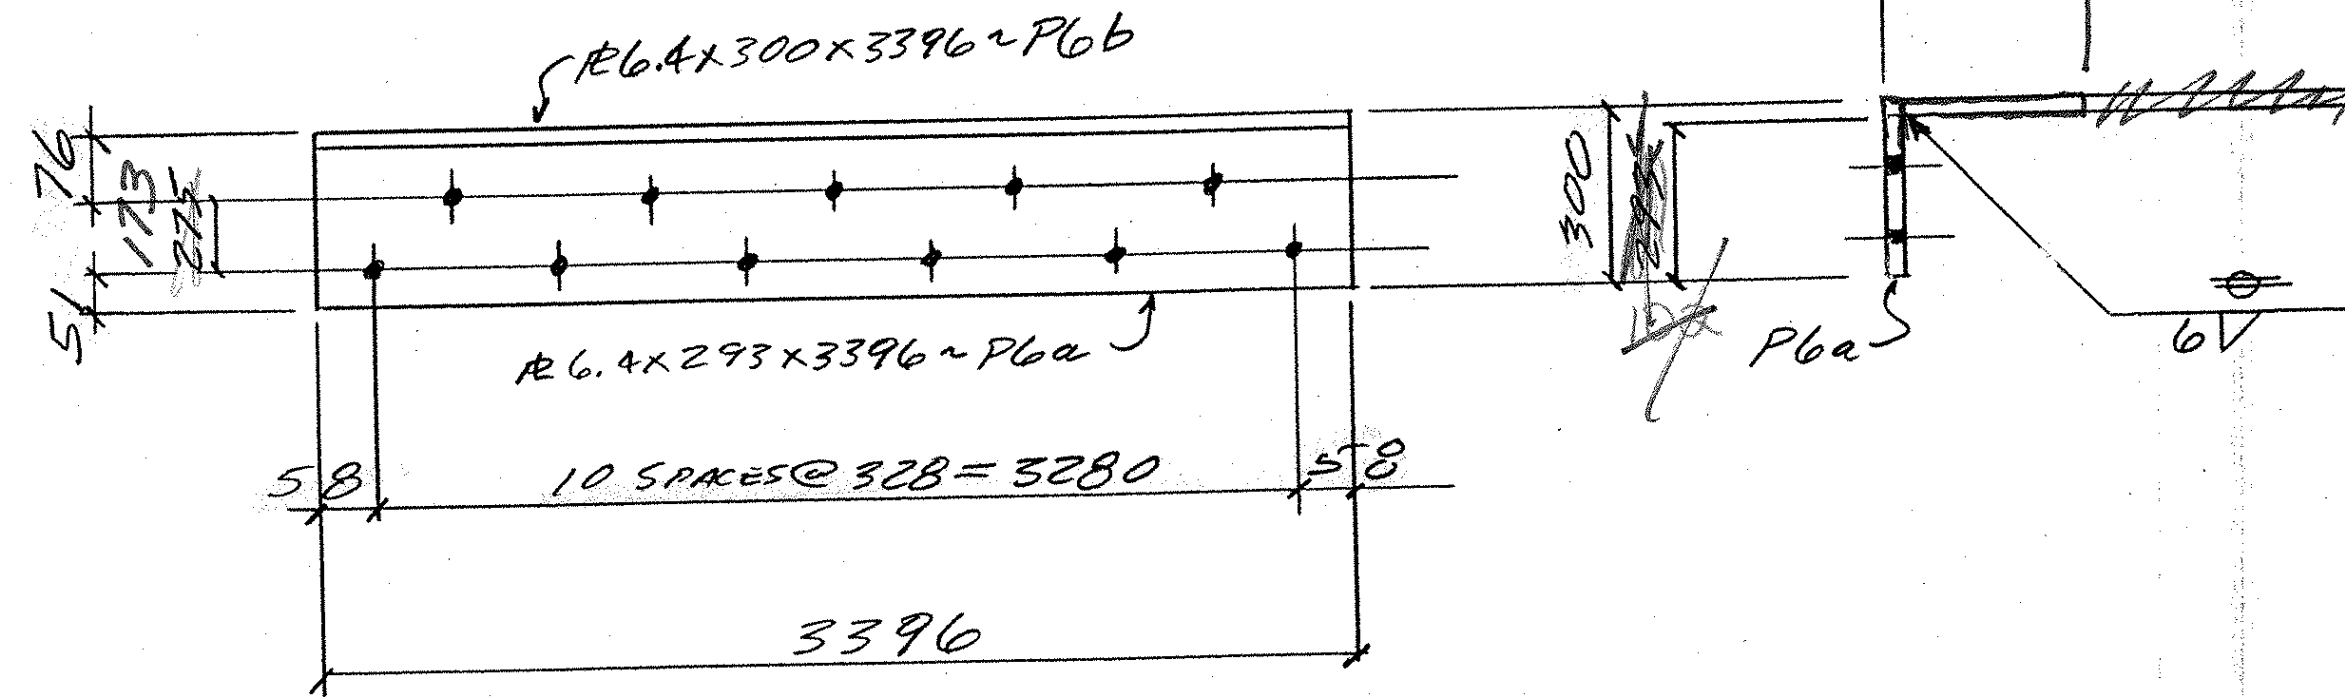

2 - PLATES - C6

300
 173
 225
 173

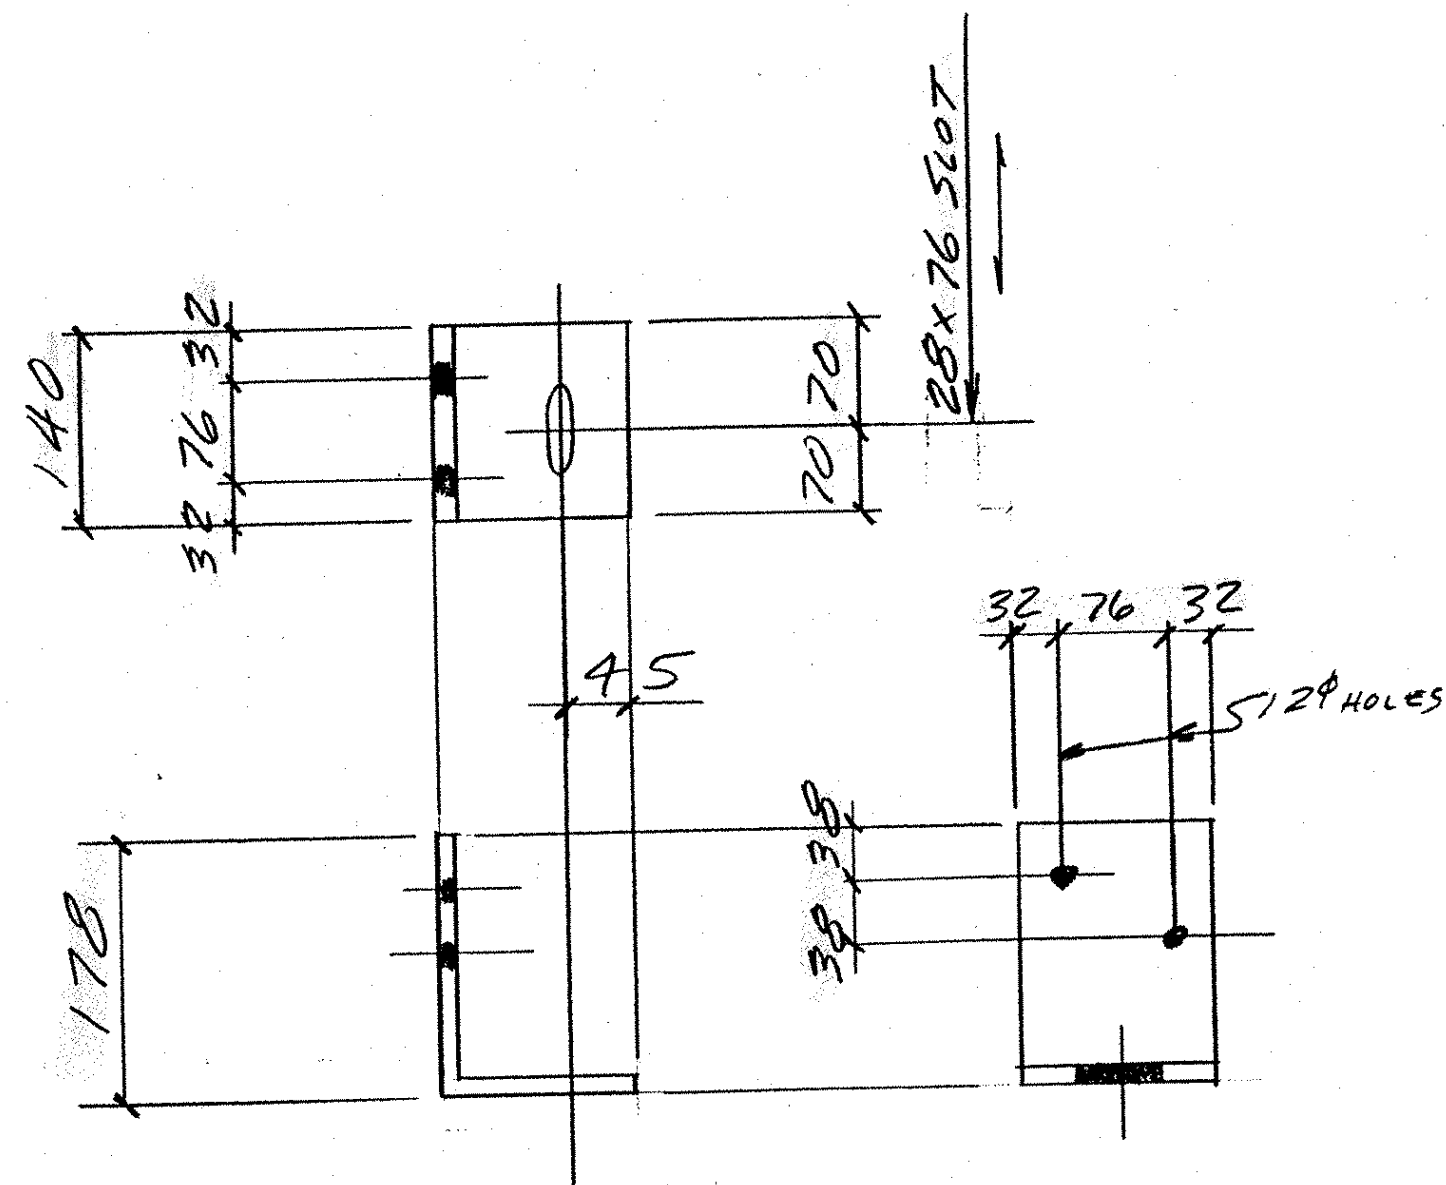

4 - ANGLES - D6

ABM INFO		SHOP BILL				JOB NO.	DRG. NO.	
PAGE	LINE	NO.	DESCRIPTION	QTY	ASSEMBLY MARK	SHIPPING MARK	REMARKS	WEIGHT
		ONE	CHK'D PLATE 9.5 x 305	1370		A6		
		ONE	do	1370		B6		
		2	PLATES			C6		
		2	R6.4 x 293	3396	P6a			
		2	R6.4 x 300	3396	P6b			
		4	L178x102x9.5	140		D6		
BOLTS FOR ROADWAY SIDEWALK JOINT RIS								
		8	1/2" DIA. CARBIDE BOLTS	150		FIELD	1/4" DIA.	
		22	6" LAG SCREWS	100		FIELD		
ANCHOR BOLTS FOR SIDEWALK BIRB ANGLES								
		4	25# ANCHOR BOLTS	400		FIELD	1/4" DIA.	
PAY ITEM 560.60								

OUT FOR APPROVAL	4-28-04								
OUT FOR APPROVAL									
ISSUED TO SHOP									
FIELD & OFFICE									

REV.	REMARKS	DATE	OWN	CHK	APP	Q.A.	NO.	DIA.	LGT	TYPE	WASHER
PROJECT NO. BHO 1442 (22) STATE PROJECT NO. BHO 1442 (22)											
MATERIAL: ASHTO M 250 ELECTRODES: P62 PROCESS HOLES: 8/16" SHOP BOLTS: -											
SURFACE PREP. & PAINT: GALVANIZE - PAY ITEM 513.25 ASHTO M 111											

DESCRIPTION: SIDEWALK RIS + L'S	DRAWN BY	DATE
JOB: TH4 OVER BLACK RIVER BRIDGE PROJECT CAVENDISH, VT	RLB	4-04
	CHKD BY	
	APPROV BY	
	Q.A.	
CUSTOMER: MILLER CONSTRUCTION	JOB NO.	DRG. NO.
CASCO BAY STEEL STRUCTURES, INC.	236	6
75 SPRING HILL ROAD SACO, MAINE 04072	PHONE (207) 282-7360	FAX (207) 282-1179
	REV.	△

PLANS DRAWN USING METRIC DIMENSIONS

RECEIVED
 OK'D BY: [Signature] APR 27 2004
 RESUBMIT: _____ APPROVED: _____
 BY: _____ DATE: _____
 054 55