


DATUM	
VERTICAL	NGVD 1927
HORIZONTAL	ASSUMED

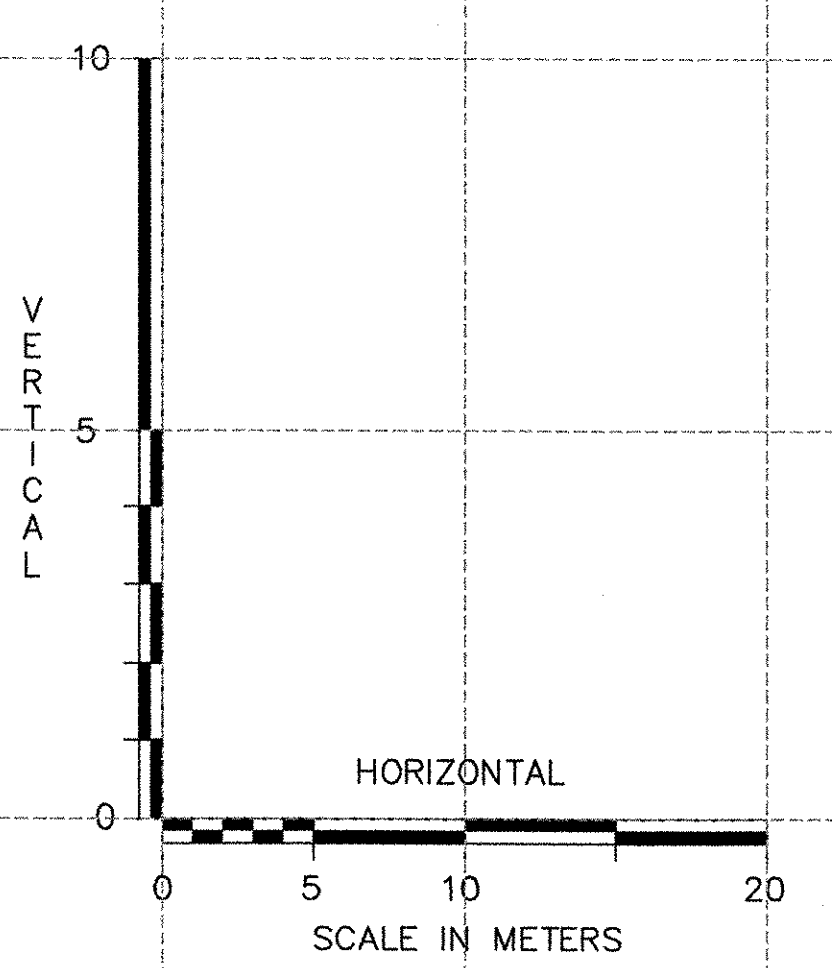

<b>STATE OF VERMONT AGENCY OF TRANSPORTATION</b>	
Town Of CAVENDISH	Bridge No. 45
Highway No. TH 29	Log Sta. Surv. Sta.
TH 29 OVER BLACK RIVER	
<b>PROFILES</b>	
Designed By R.F. CLARK	Drawn By R.F. CLARK
Checked By S.M. GUNN	Bridge Design Supervisor C.D. BAKER Date 5/06
PROJECT CAVENDISH	PROJECT NO. BRO 1442(23)
I.G.C. Info.	
Bridge Sheet No. 50499PRO	Sheet 11 of 47

VANASSE HANGEN BRUSTLIN, INC.