




PLAN
SCALE: 1:40

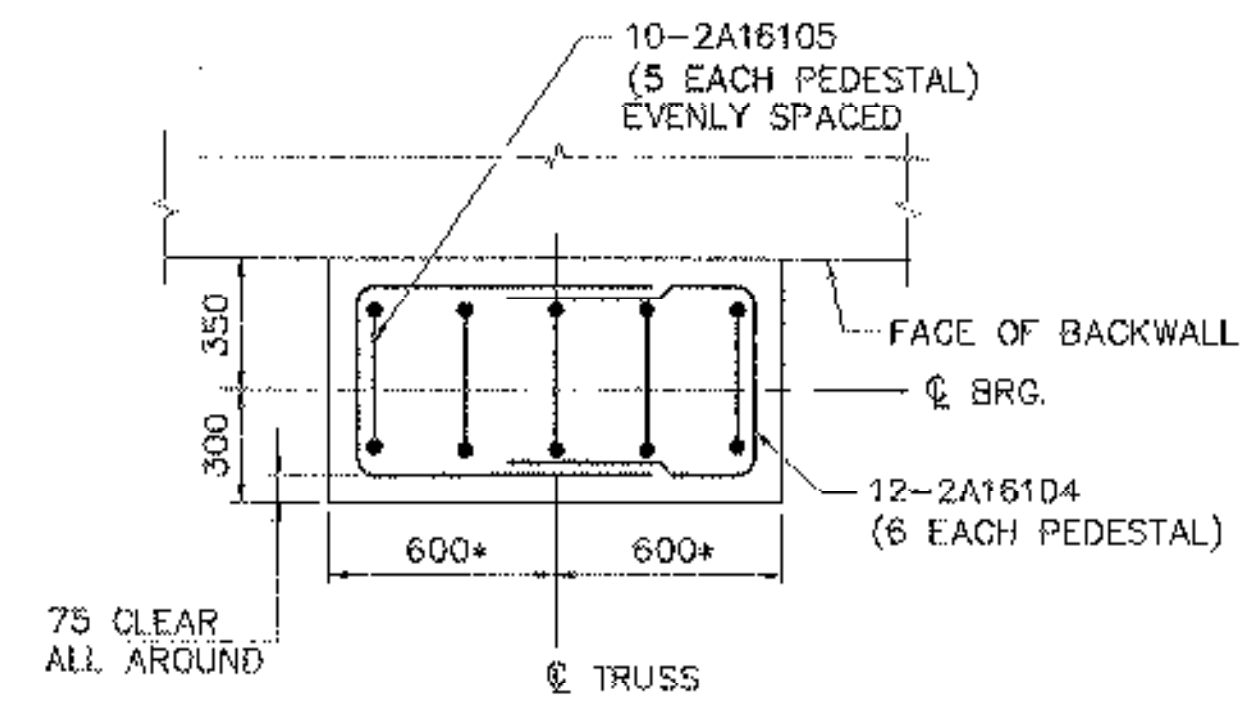


TYPICAL PEDESTAL PLAN DETAIL
(PLACE PEDESTAL REINFORCING TO AVOID ANCHOR RODS)
SCALE: 1:20

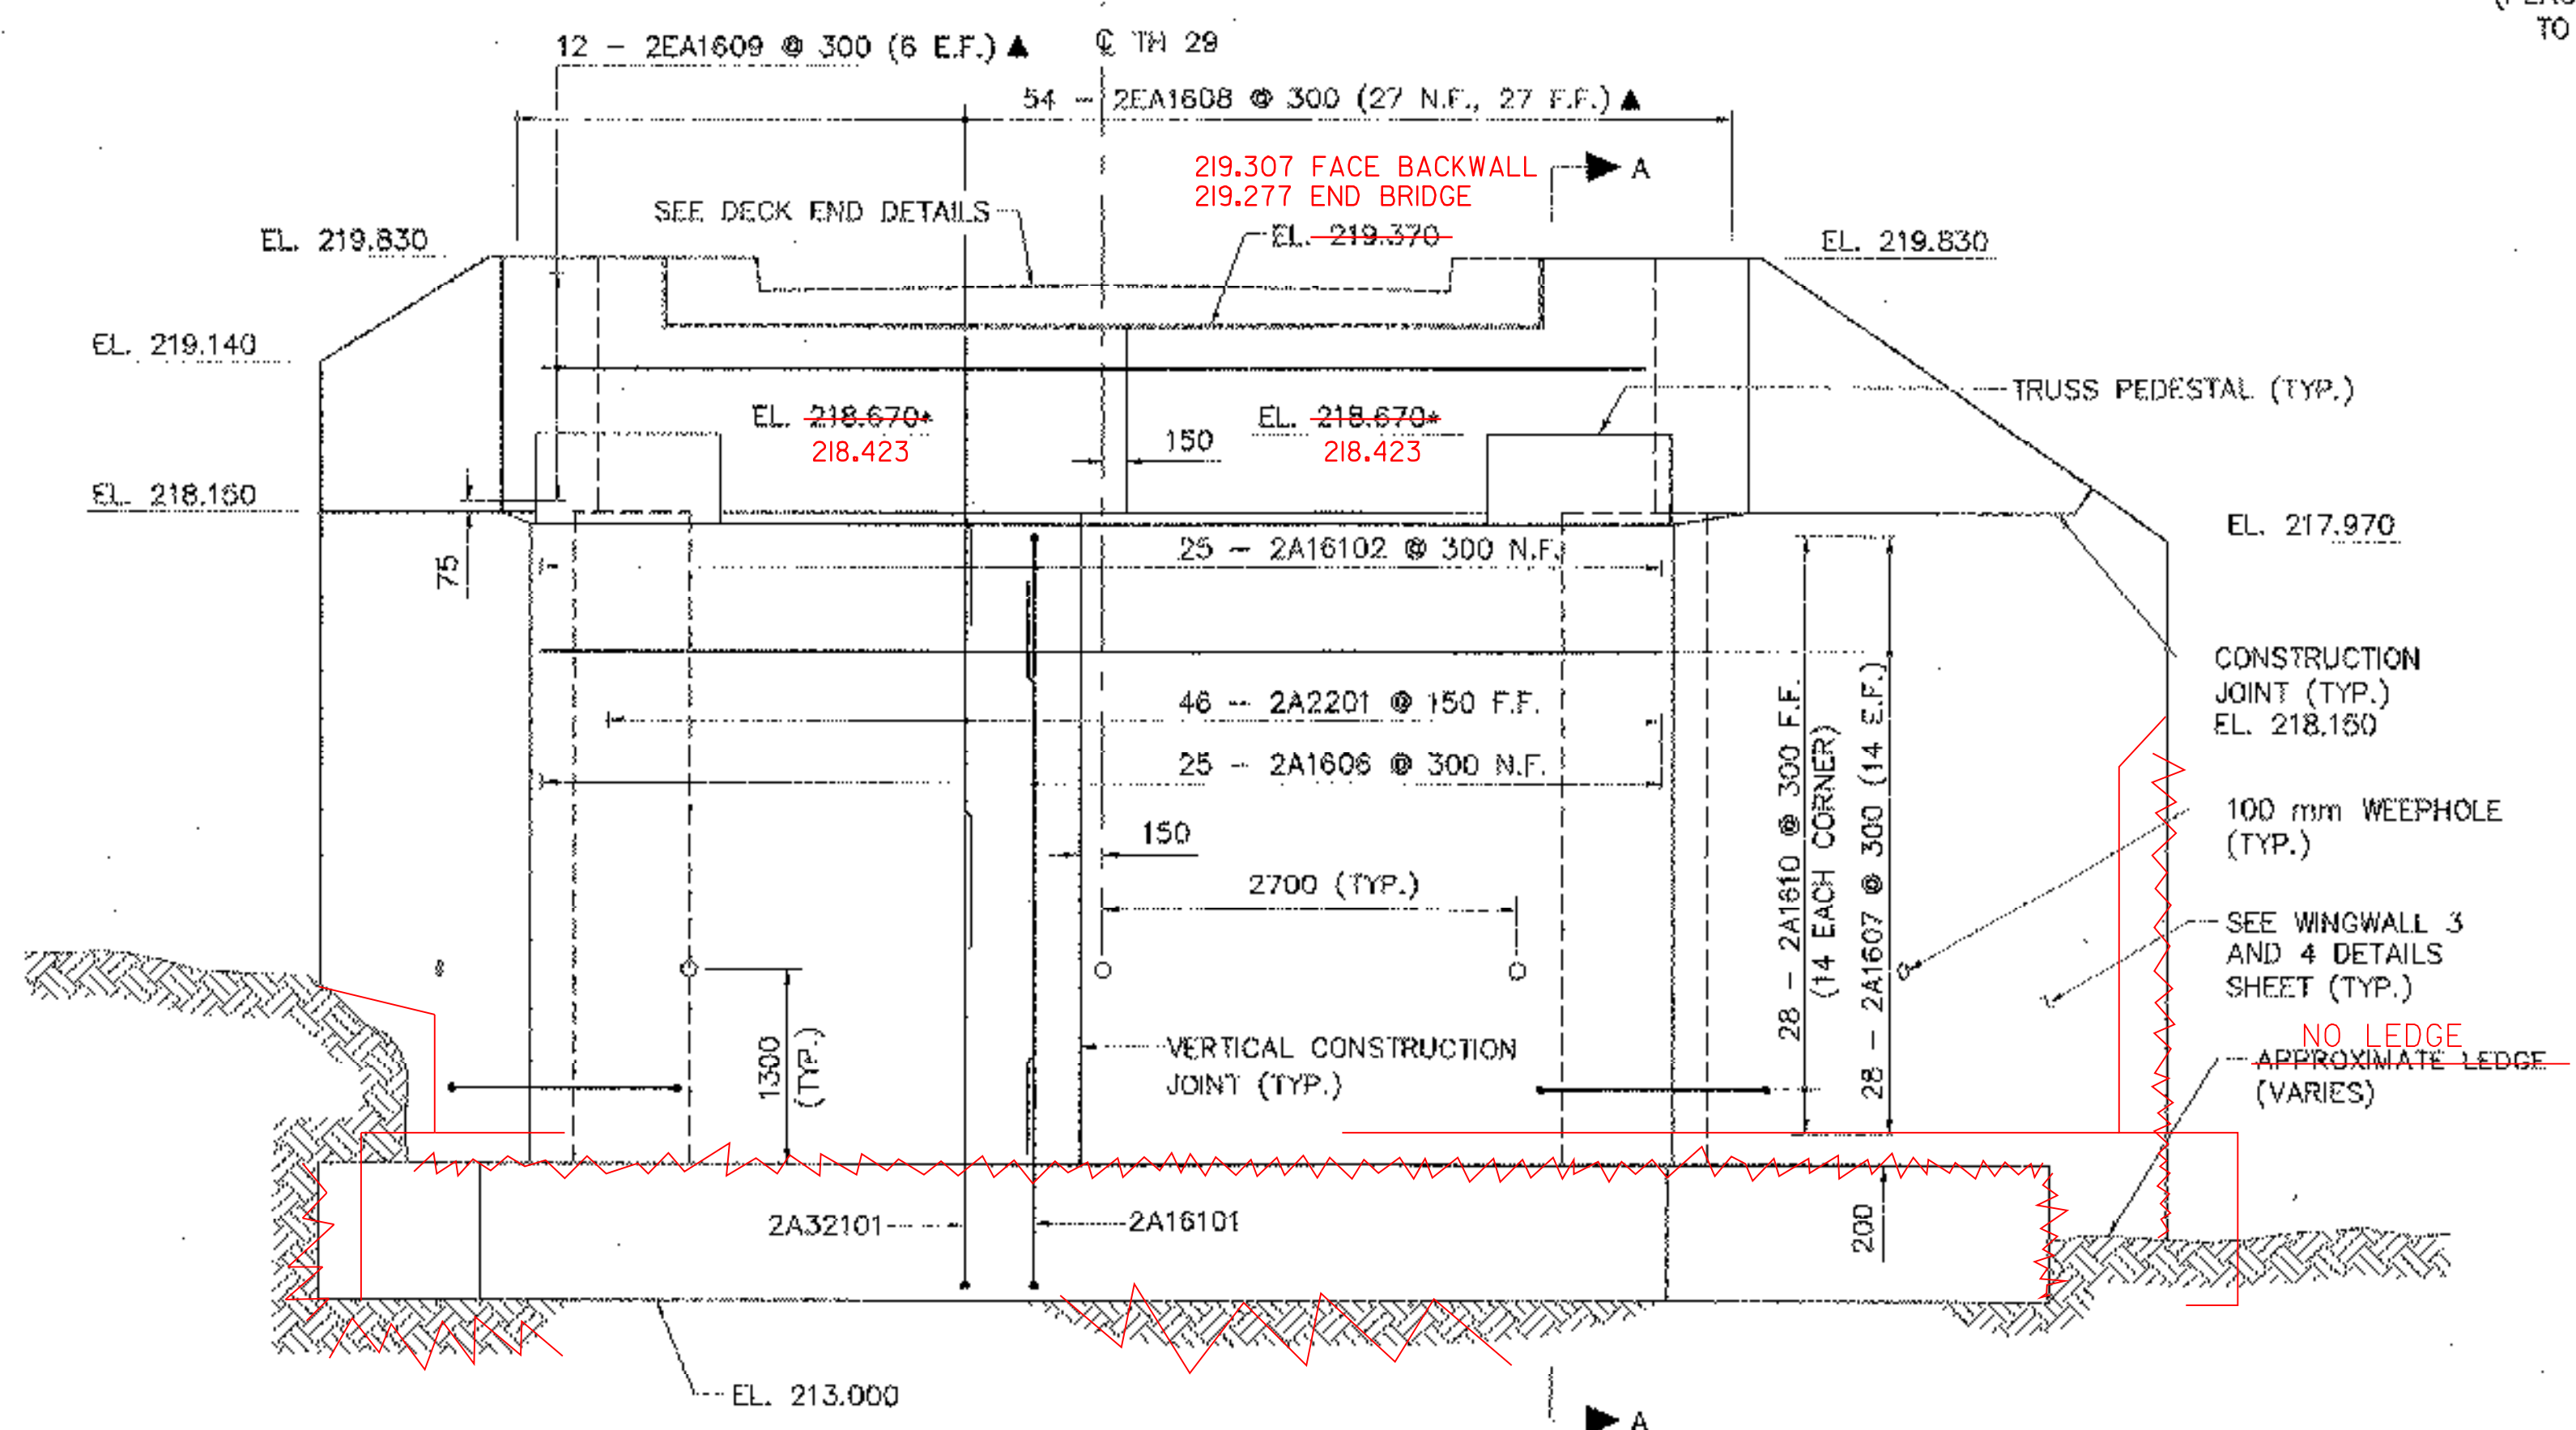

ELEVATION
SCALE: 1:40

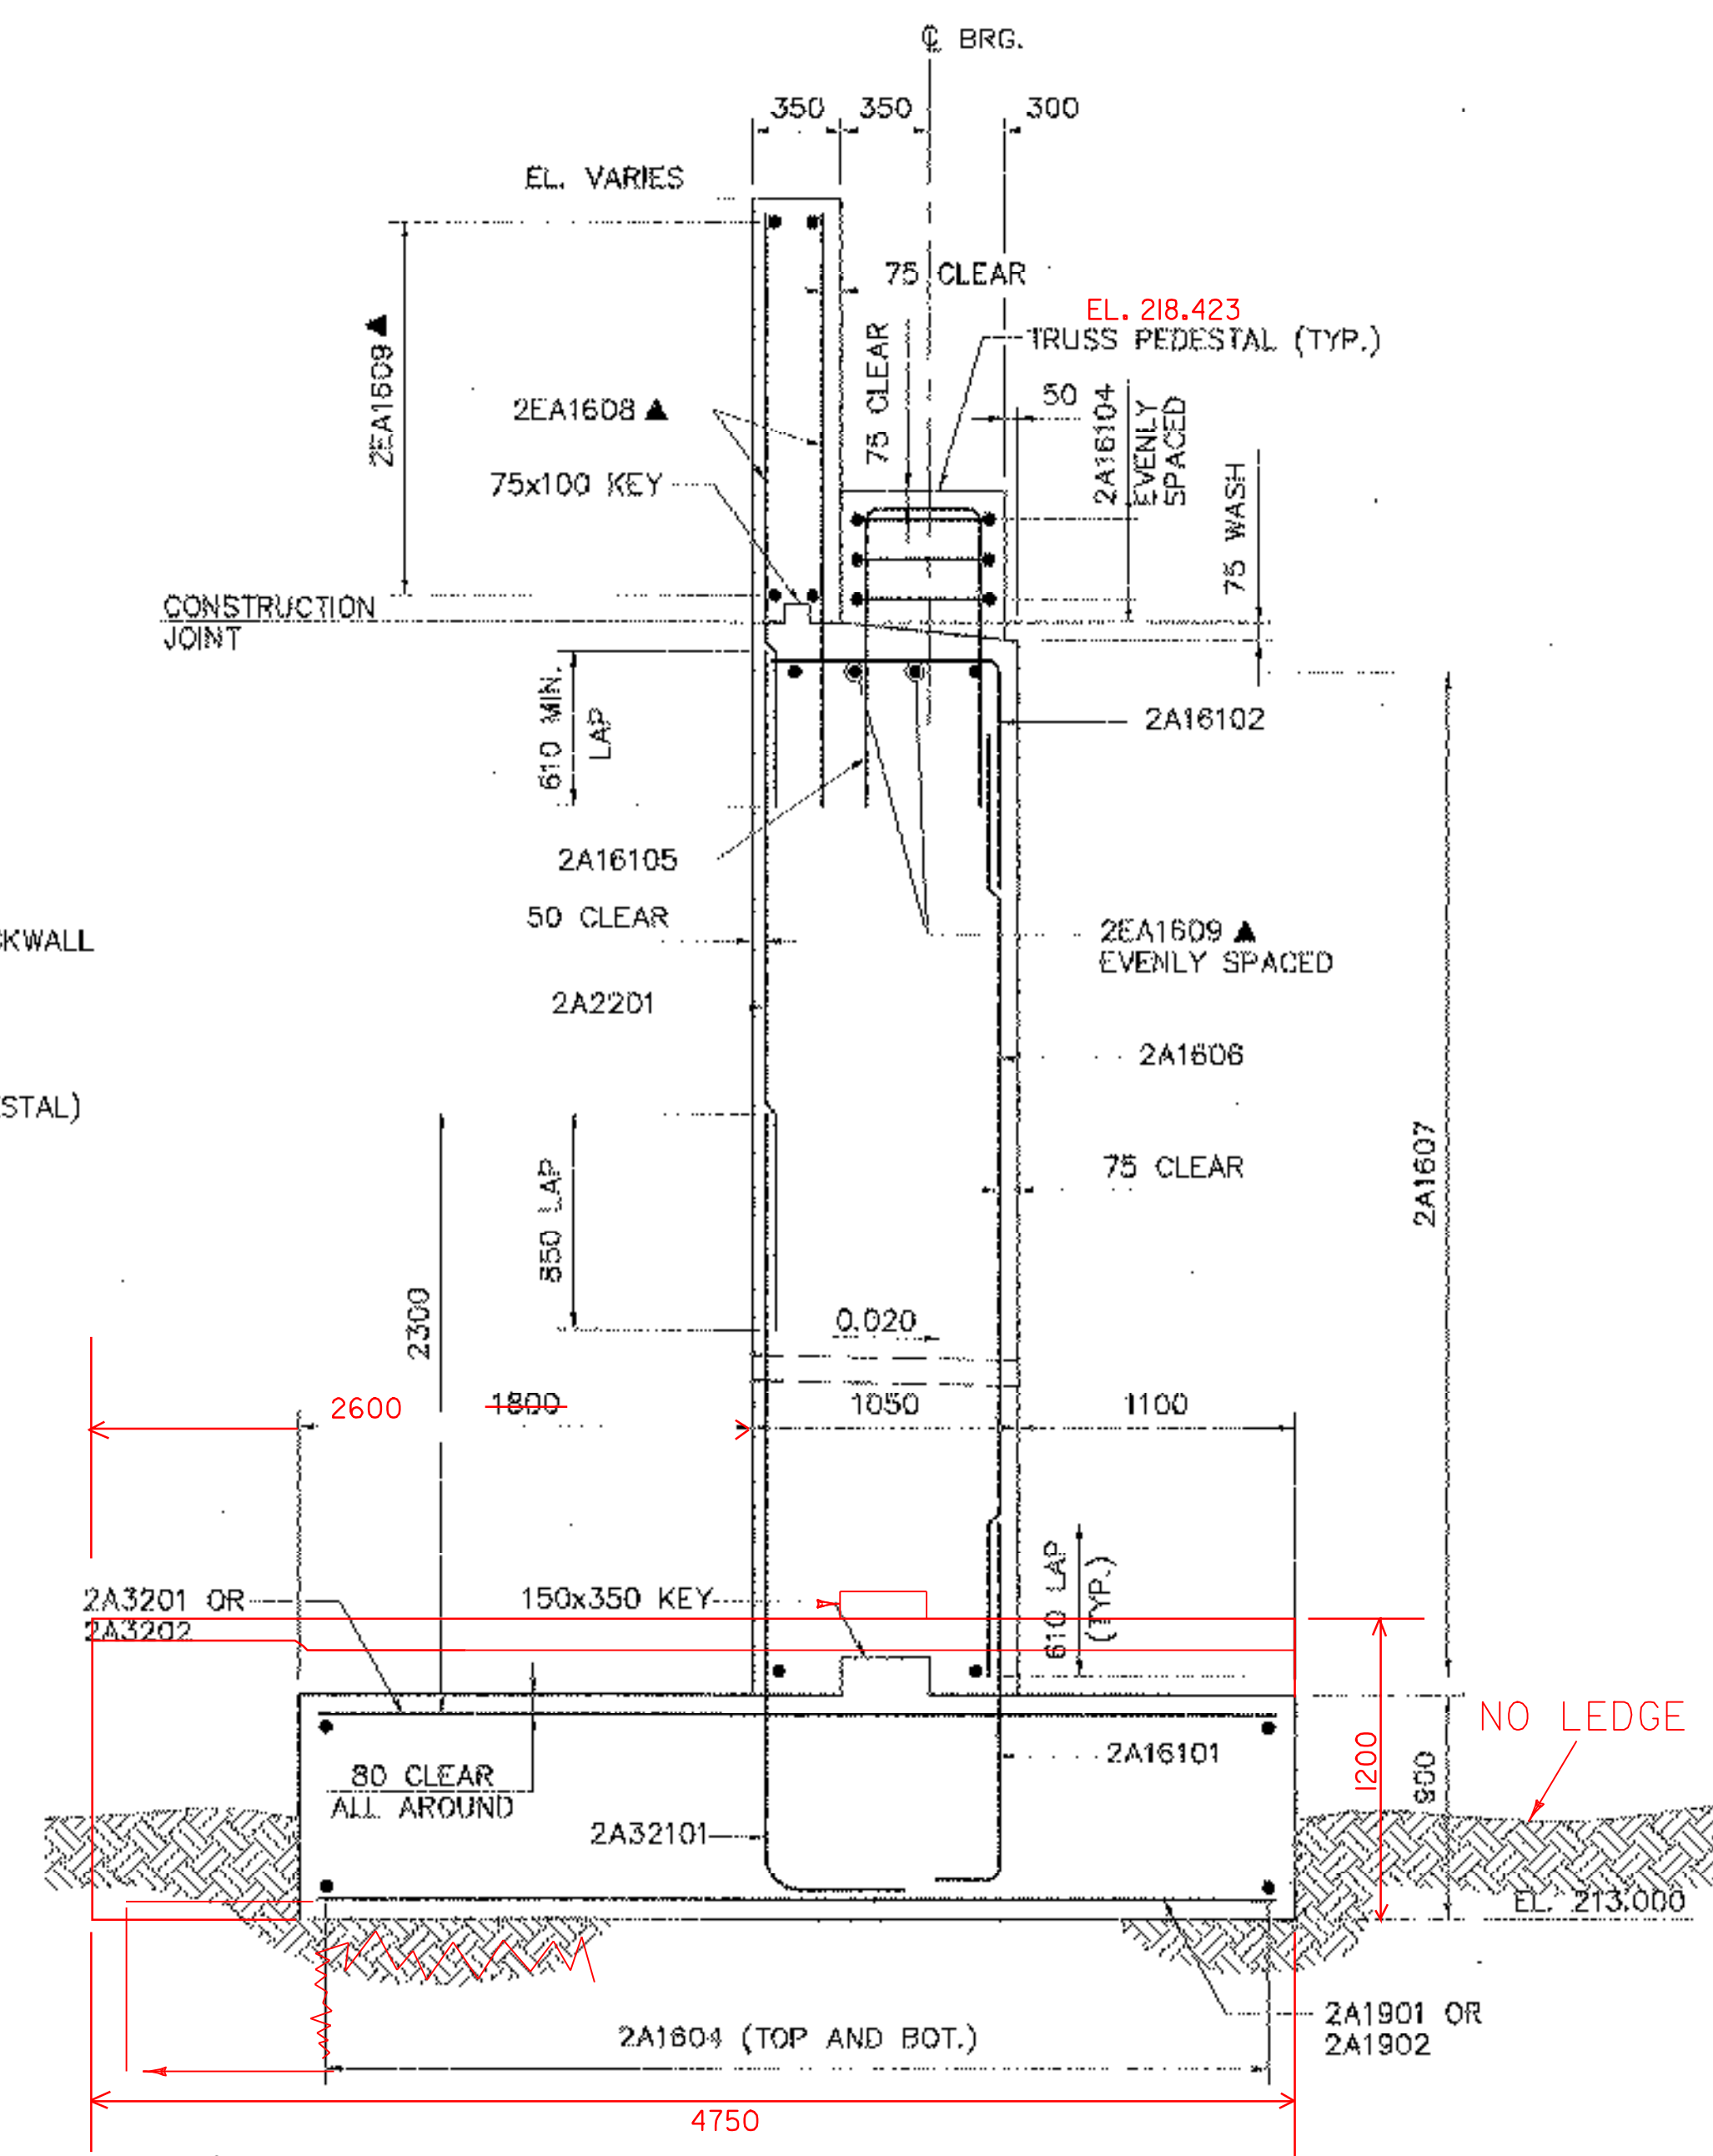

SECTION A-A
SCALE: 1:25

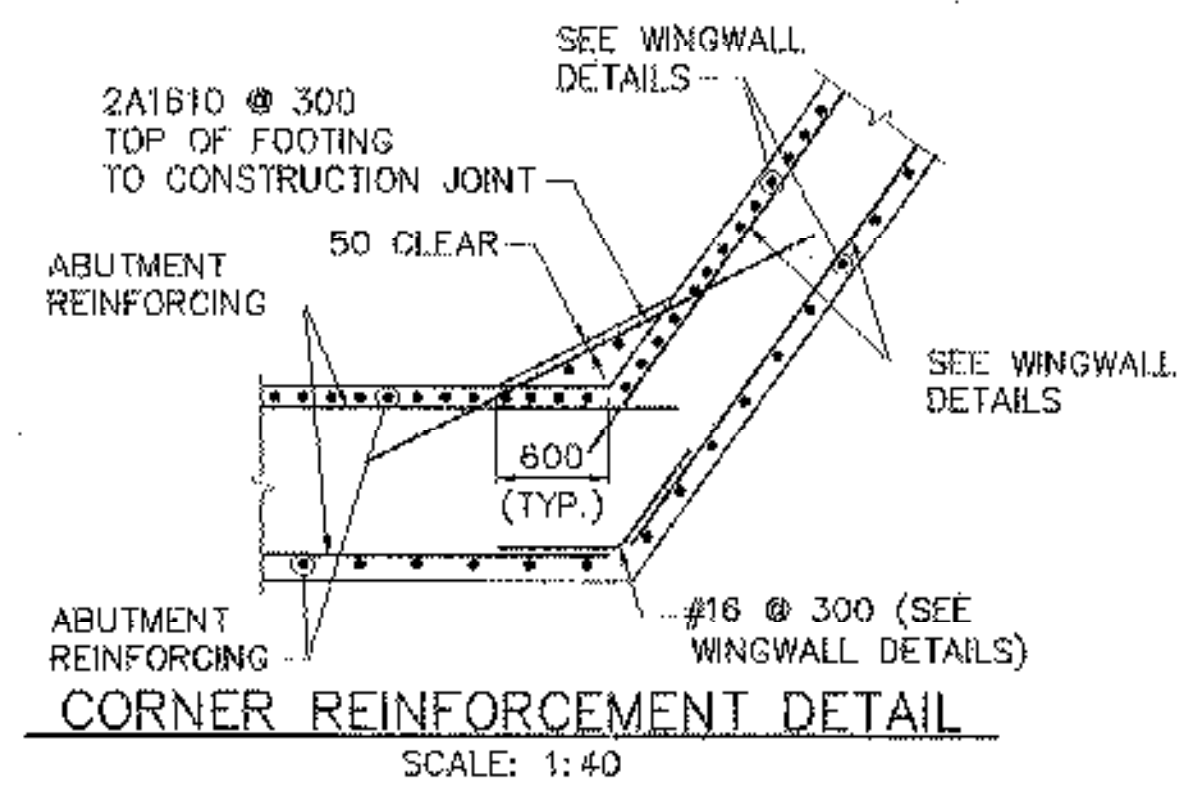

CORNER REINFORCEMENT DETAIL
SCALE: 1:40

NOTE:
1. SEE SHEET 28 FOR TYPICAL WEEPHOLE DETAIL.

**STATE OF VERMONT
AGENCY OF TRANSPORTATION**

Town Of	CAVENDISH	Bridge No.	45
Highway No.	TH 29	Log Sta.	
		Surv. Sta.	
TH 29 OVER BLACK RIVER			
ABUTMENT 2 DETAILS			
Designed By	S.M. HODGDON	Drawn By	M.M. LANDREY
Checked By	W.M. MOSHER	Date	5/06
		Bridge Design Supervisor	C.D. BAKER Date 5/06
PROJECT	CAVENDISH	PROJECT NO.	BRO 1442(23)
I.G.C. Info.			
Bridge Sheet No.	50499AB2	Sheet	27 of 47

KEY
E.F. = EACH FACE
N.F. = NEAR FACE
F.F. = FAR FACE
▲ CUT TO FIT IN THE FIELD

* DIMENSION OR ELEVATION TO BE CONFIRMED BY THE TRUSS MANUFACTURER