


SEE ROADWAY CROSS SECTIONS

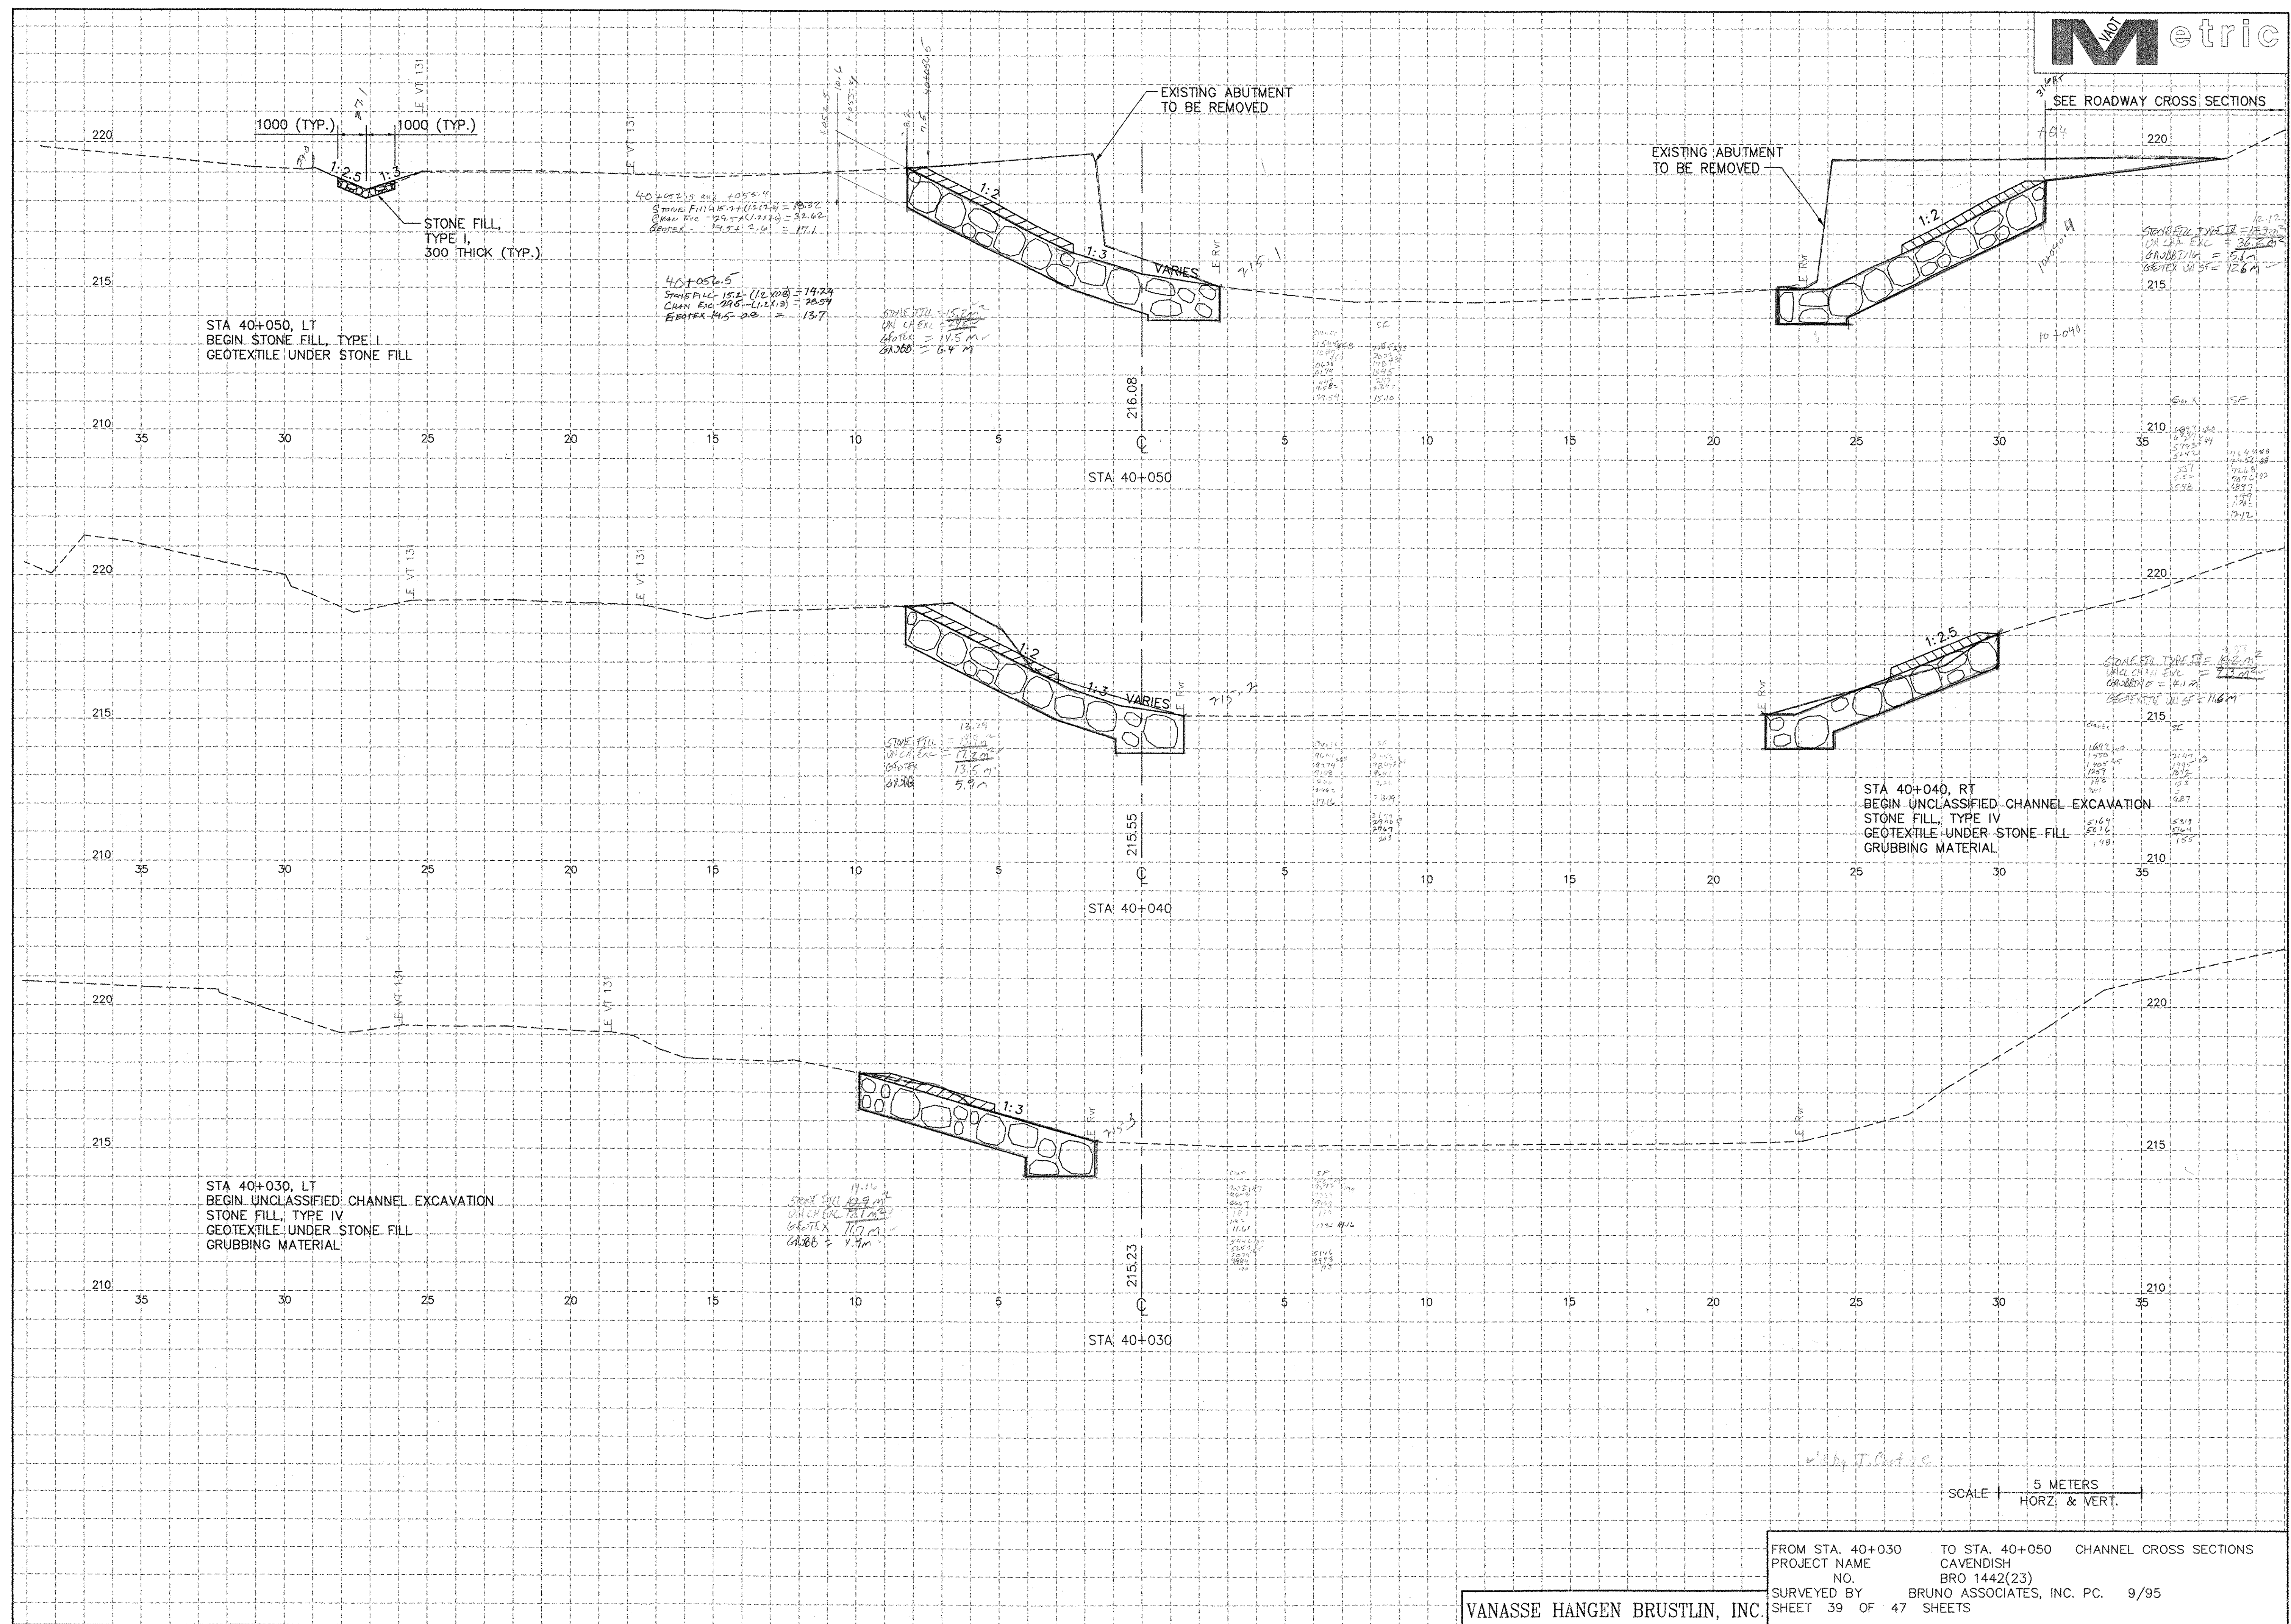

FROM STA. 40+030 TO STA. 40+050 CHANNEL CROSS SECTIONS
 PROJECT NAME CAVENDISH
 NO. BRO 1442(23)
 SURVEYED BY BRUNO ASSOCIATES, INC. PC. 9/95
 SHEET 39 OF 47 SHEETS