



MATERIAL TRANSITION DETAIL

SCALE HORIZ. 1:250
VERT. 1:25

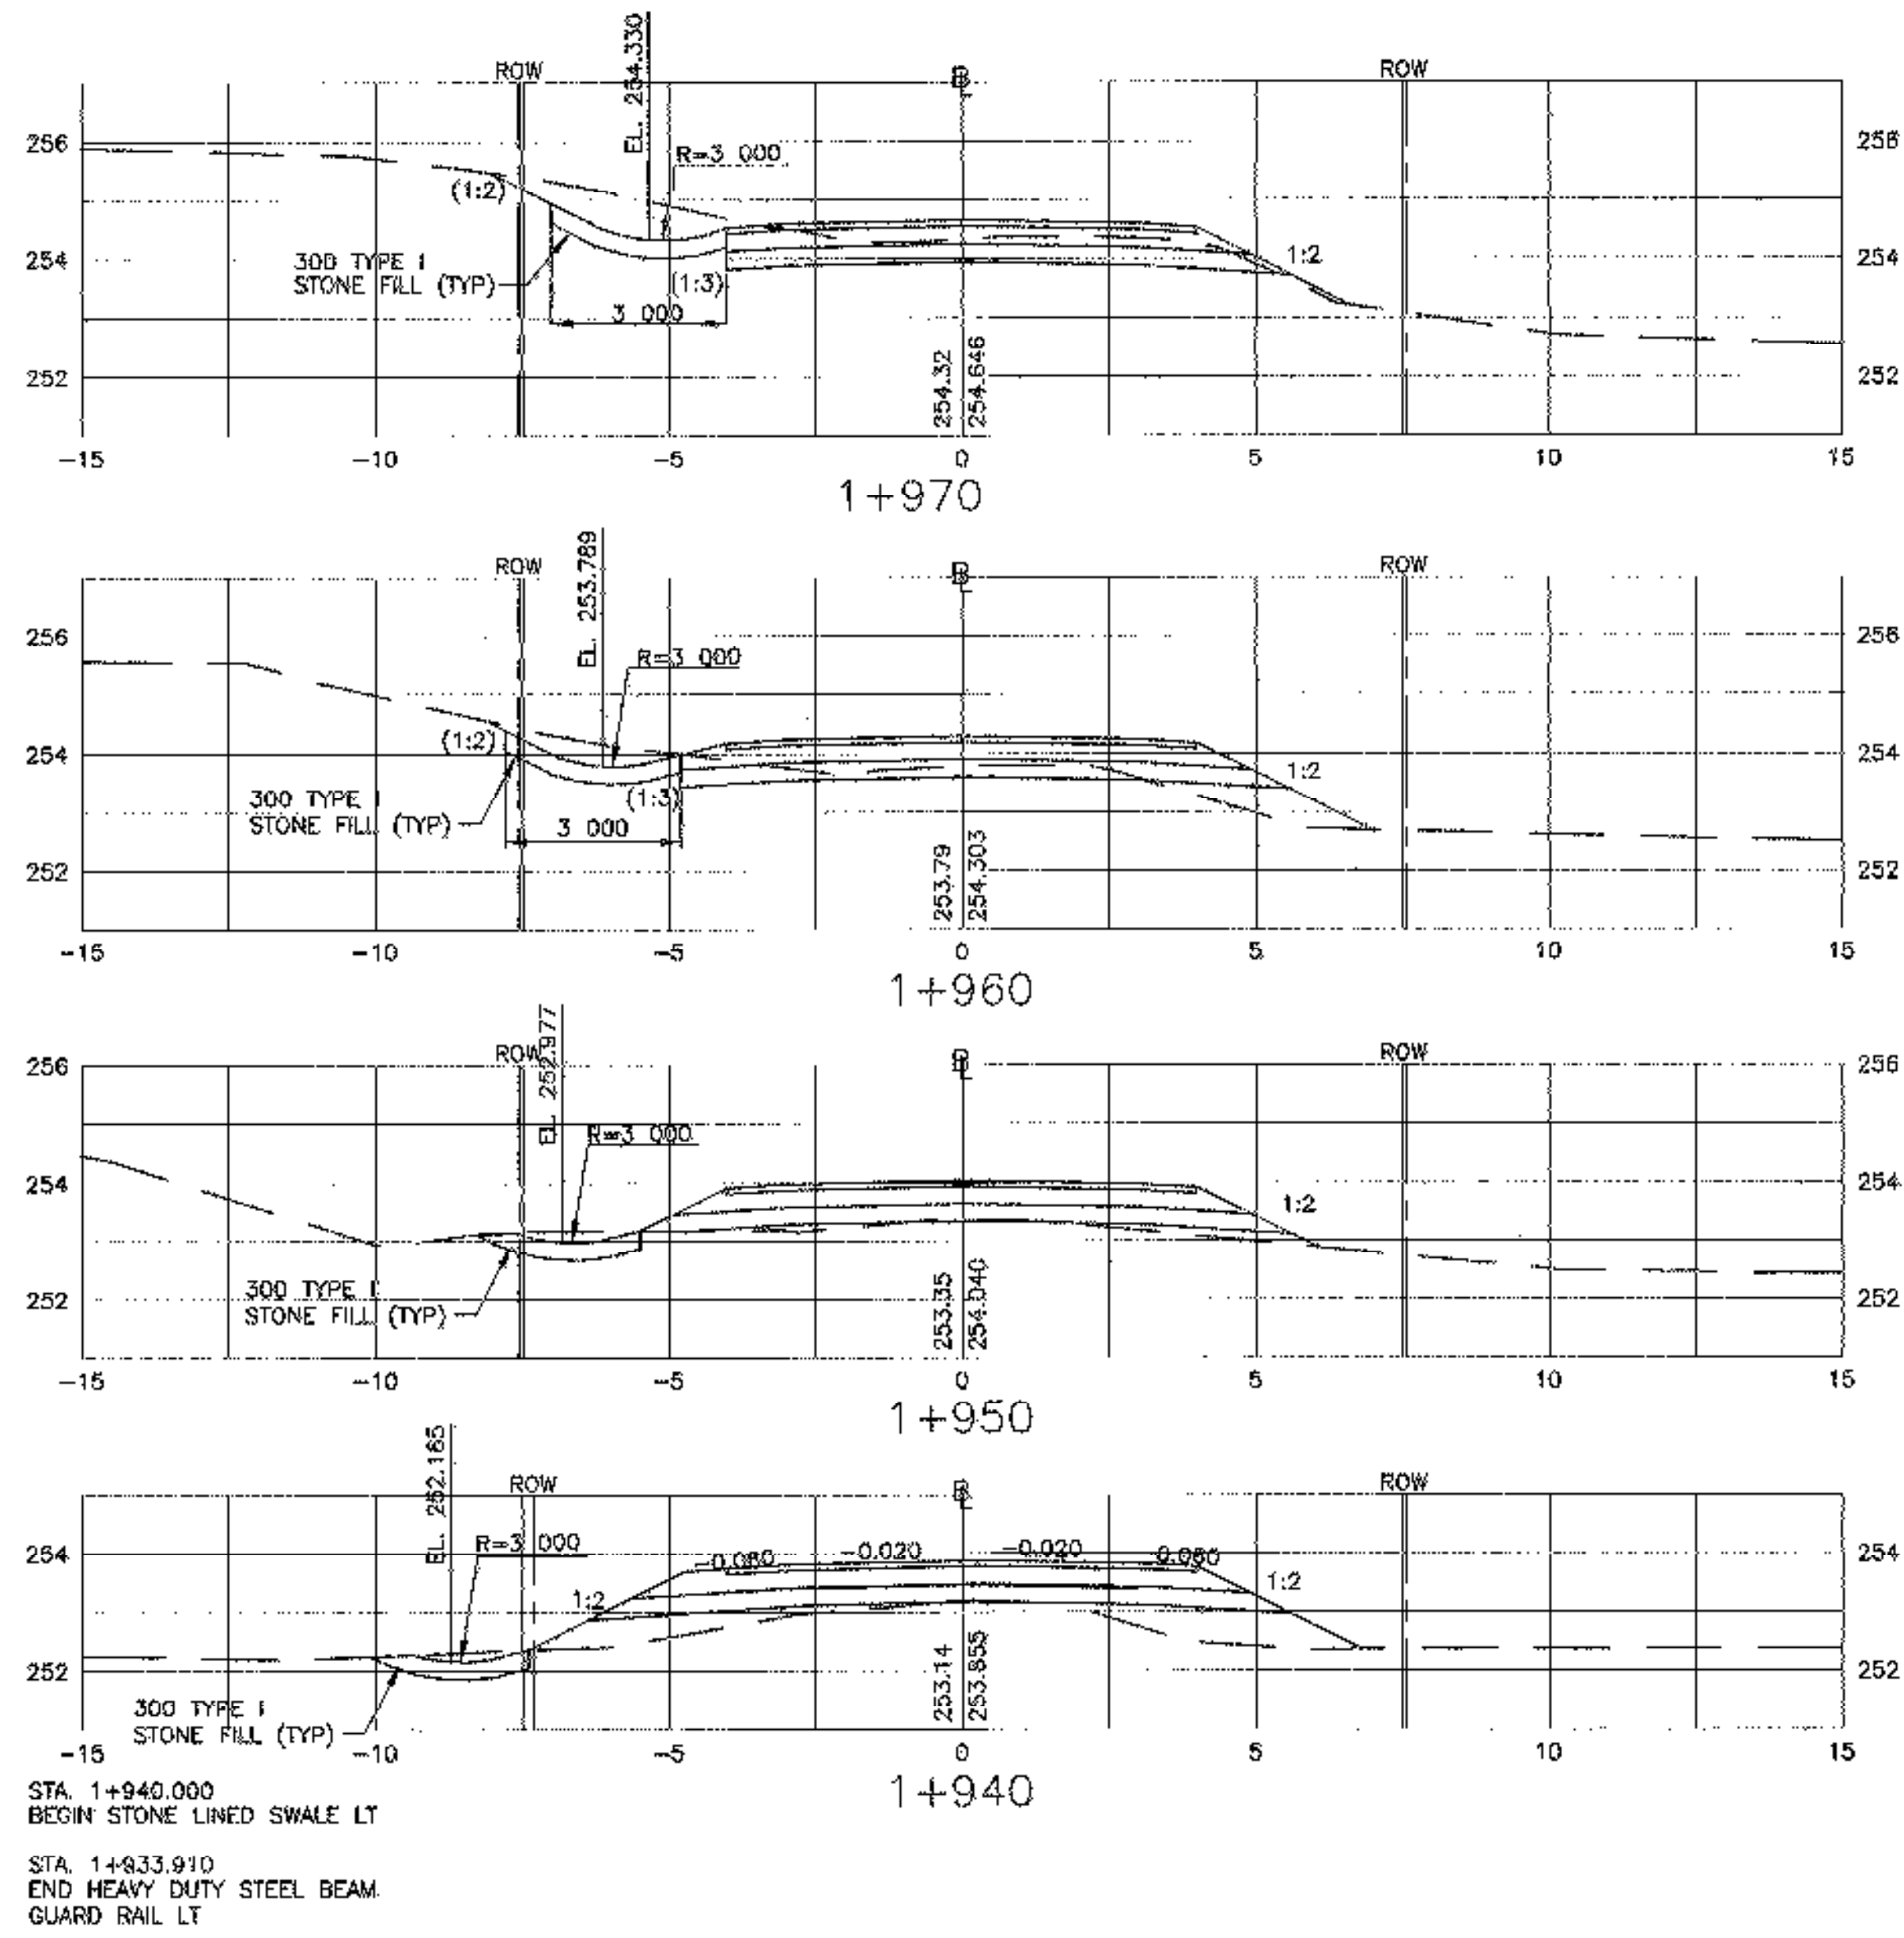

ROADWAY CROSS SECTIONS

SCALE HORIZ. 1:100 VERT. 1:100

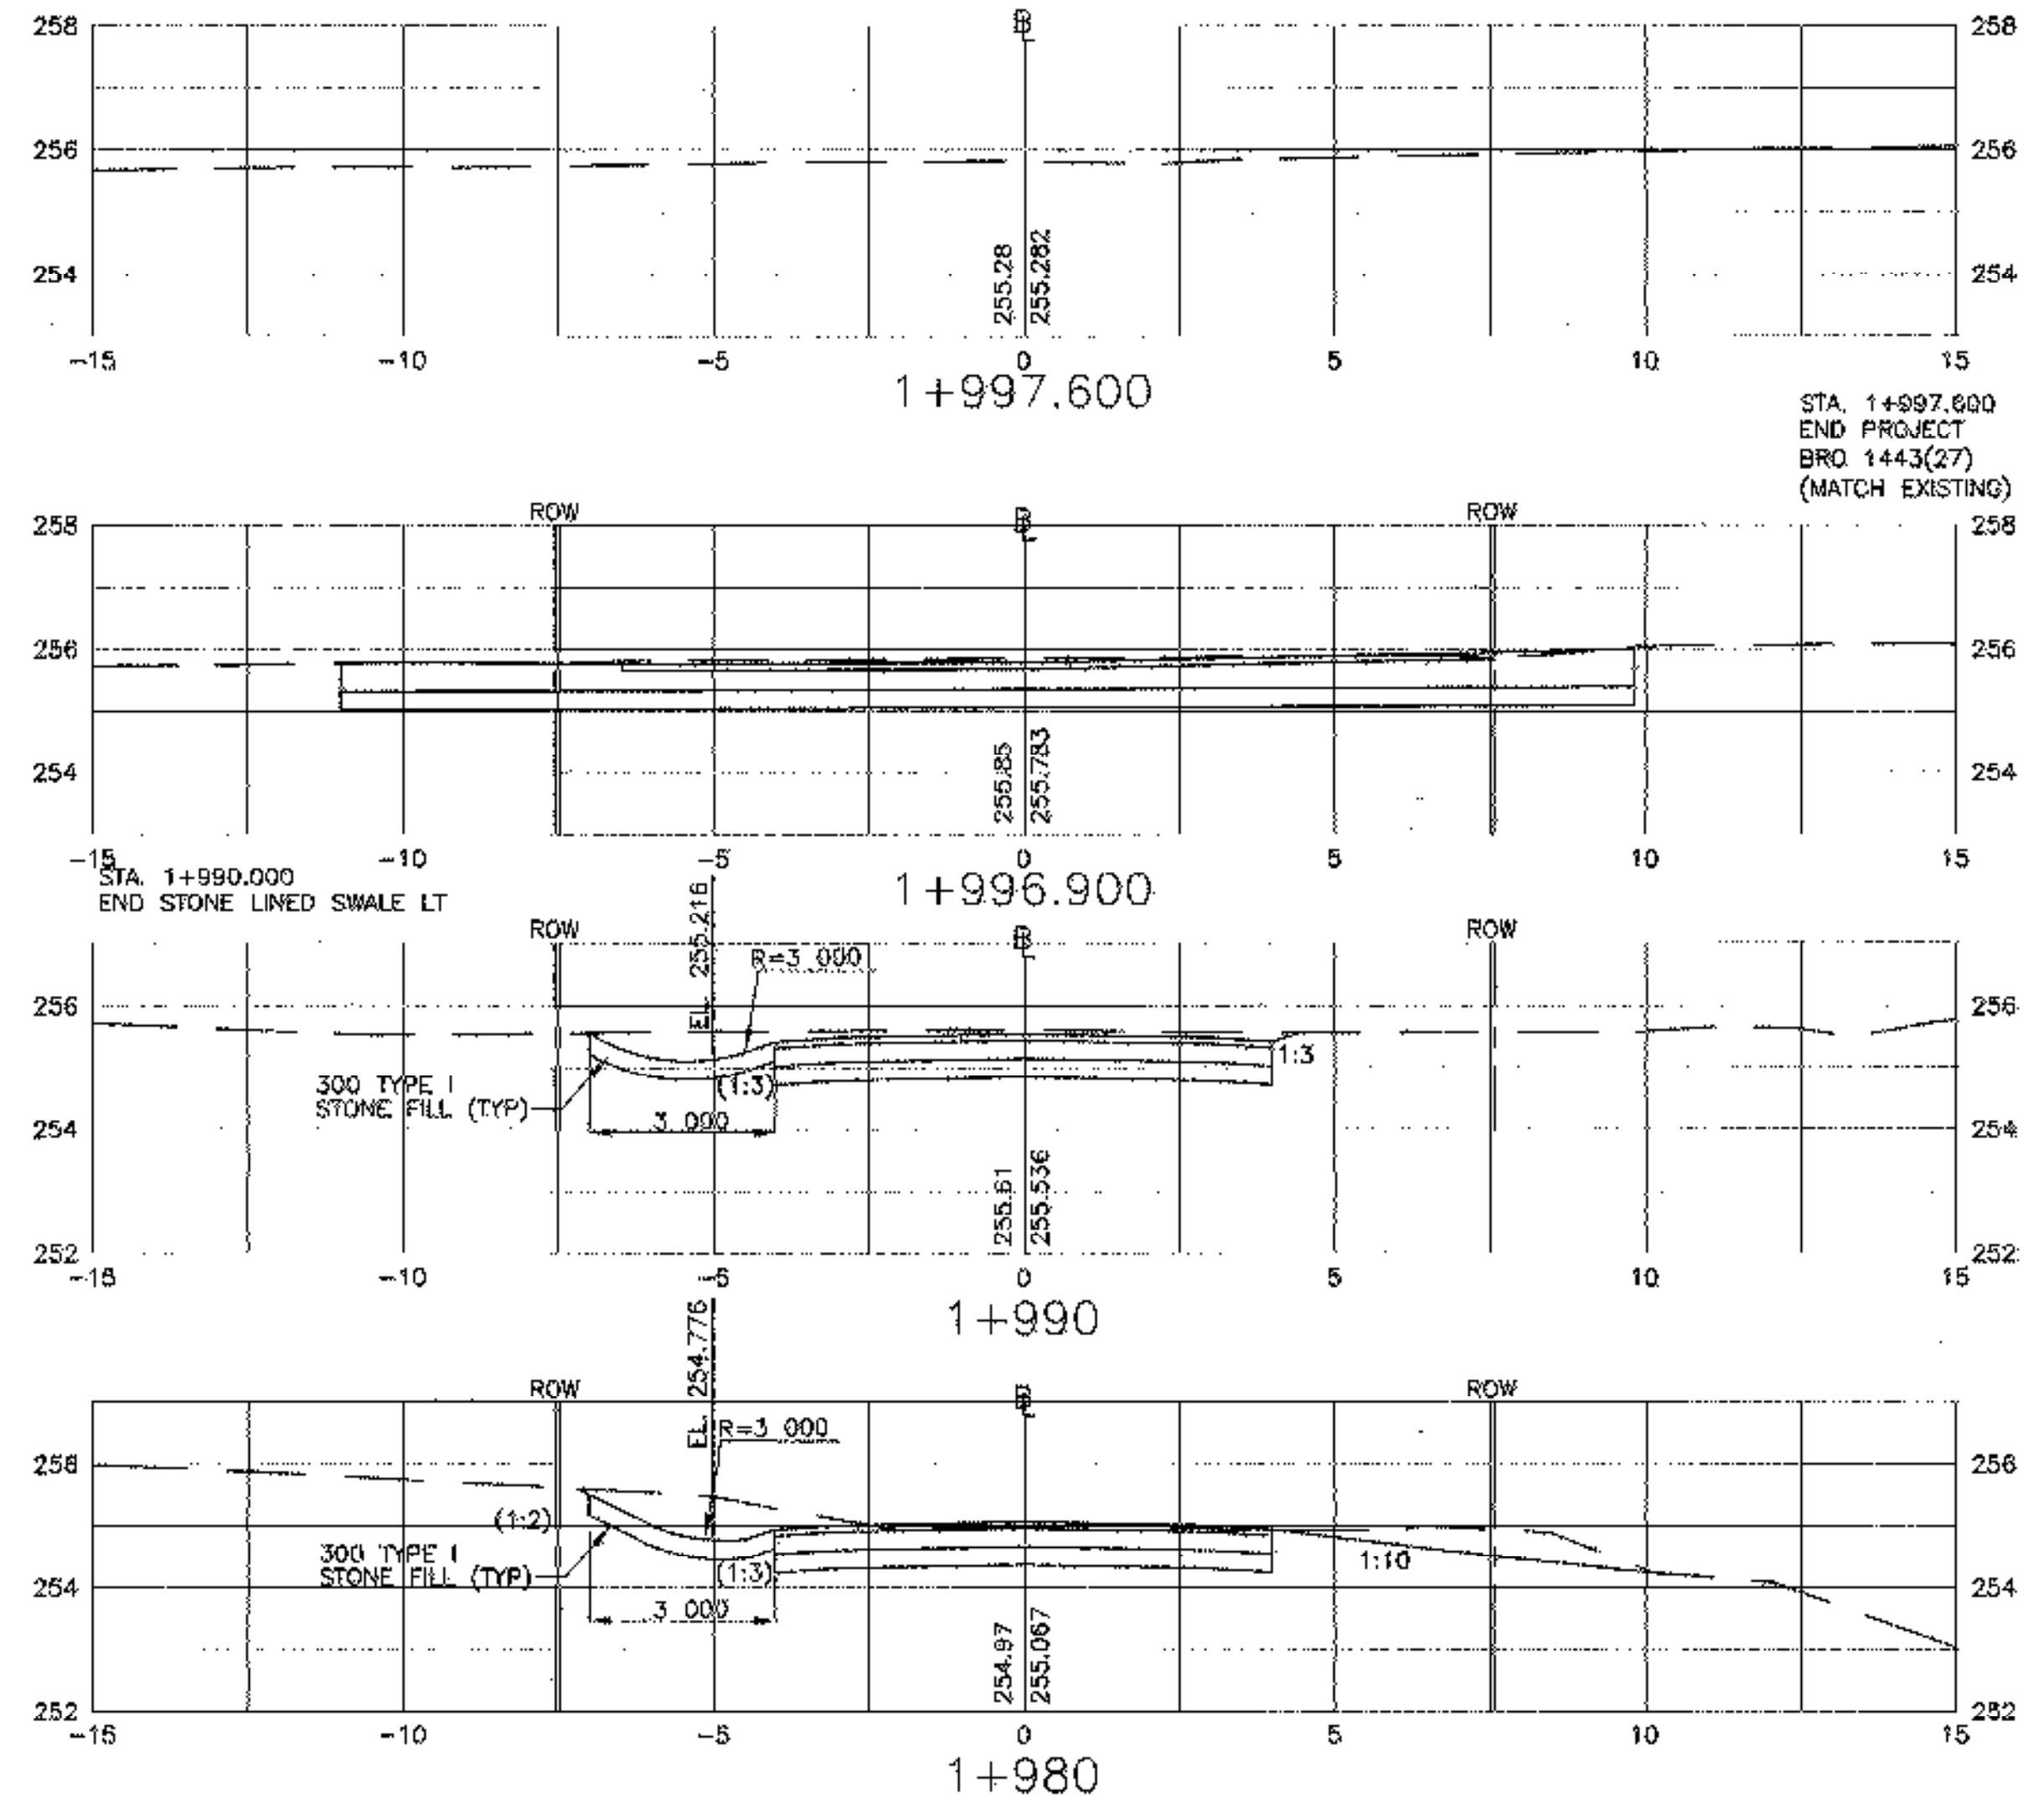

REVISIONS			STATE OF VERMONT AGENCY OF TRANSPORTATION	
NO.	DESCRIPTION	BY & DATE		
<p>engineering planning management development</p>			CLARENDON, VERMONT	
			TOWN HIGHWAY NO. 10	
			TOWN HIGHWAY NO. 10 OVER THE CLARENDON RIVER	
			ROADWAY CROSS SECTIONS	
Designed by: W.S. CHESBROUGH		Drawn by: N.B. DIMICK		
Checked by: K.S. MARSHALL		Bridge Design Supervisor: J.W. TUCKER		
VAOT PROJECT NO. BRO 1443(27)		DK PROJECT NO. R13567F5		
Bridge Sheet No.		SHEET 24 of 25		