

NOTES:

1. USE THIS SHEET IN CONJUNCTION WITH STANDARDS T1M AND T2M.
2. AN ALTERNATE EROSION CONTROL PLAN MAY BE SUBMITTED BY THE CONTRACTOR. SUBJECT TO THE APPROVAL OF THE RESIDENT ENGINEER.
3. THE CONTRACTOR WILL USE OTHER TEMPORARY OR PERMANENT EROSION CONTROL MEASURES AS REQUIRED BY THE CONSTRUCTION SEQUENCE AND THE RESIDENT ENGINEER. (SEE SECTION 105.23 OF THE VERMONT STANDARD SPECIFICATIONS FOR CONSTRUCTION, DATED 2001).
4. THE CONTRACTOR SHALL SUBMIT A PLAN FOR MAINTAINING STREAM FLOW DURING PLACEMENT OF THE PRECAST BOX UNITS PRIOR TO THE START OF THIS WORK.

REMOVAL OF EXISTING GUIDE POSTS

STA 1+010.6 RT
 STA 1+013.9 LT
 STA 1+020.7 LT
 STA 1+027.9 LT

HEAVY DUTY STEEL BEAM GUARD RAIL

STA 0+986.0 RT - STA 1+008.2 RT
 STA 1+015.8 RT - STA 1+048.8 RT
 STA 1+000.9 LT - STA 1+012.0 LT
 STA 1+019.6 LT - STA 1+035.3 LT

HEAVY DUTY STEEL BEAM GUARD RAIL (NESTED)

STA 1+008.2 RT - STA 1+015.8 RT
 STA 1+012.0 LT - STA 1+019.6 LT

CONSTRUCT STONE FILL, TYPE I, DITCH


STA 1+040.0 LT - STA 1+050.0 LT
 030.7 077.7
 STA 0+989.2 - 1+012 LT

ANCHORS FOR STEEL BEAM GUARD RAIL

STA 0+987.5 RT
 STA 1+002.4 LT
 STA 1+046.9 RT
 STA 1+033.5 LT

BARSALOW, WILLIAM E., SR. &
 BARSALOW, WILLIAM E., JR.

BEGIN R.O.W. PROJECT
 BRO 1443 (32) STA. 0+968.0
 7.54 M LT. (25')

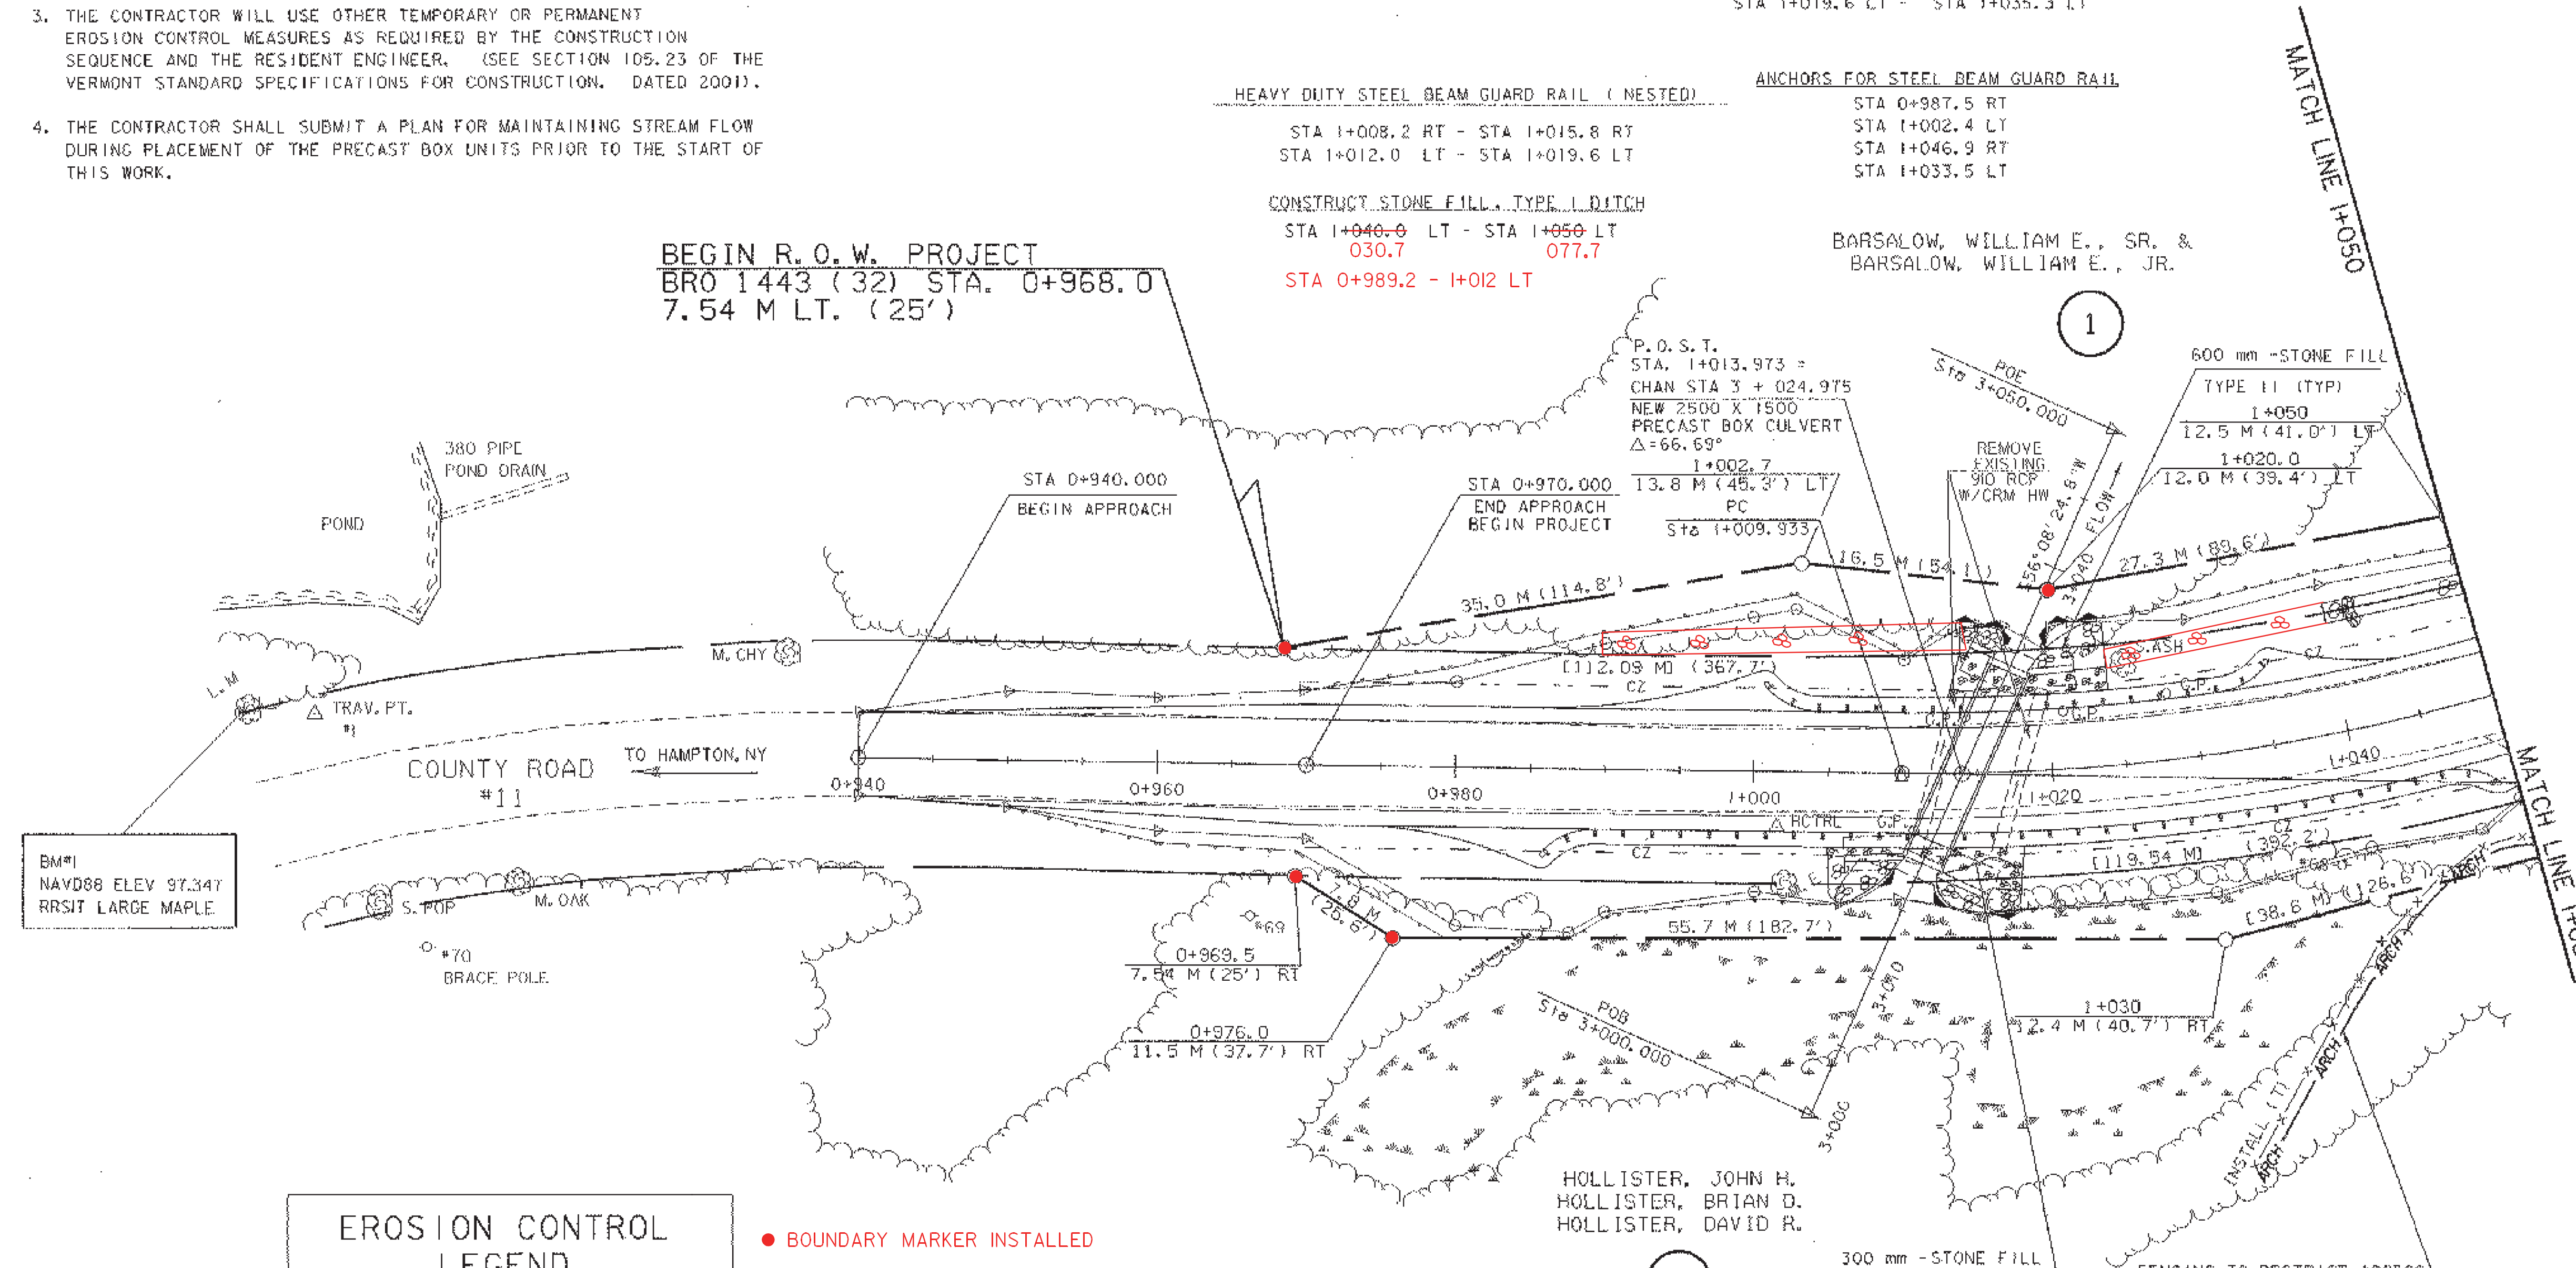


BM#1
 NAVD88 ELEV 97.347
 RRSIT LARGE MAPLE

EROSION CONTROL LEGEND	
	FILTER CURTAIN
	SILT FENCE
	ROCK CHECK DAM
	STONE FILL, TYPE I
	STONE FILL, TYPE II

● BOUNDARY MARKER INSTALLED

TOWN OF HAMPTON, N.Y.

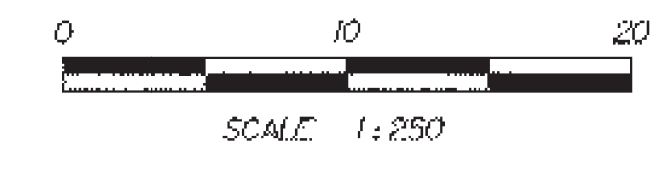

**FOR R.O.W.
 USE ONLY**

SHEET NAME: RIGHT-OF-WAY PLAN SHEET #1	
PROJECT NAME: FAIR HAVEN-HAMPTON	HIGHWAY NO.: TH 6
PROJECT NUMBER: BRO 1443(32)	BRIDGE NO.: 6
	OVER: POULTNEY RIVER
FILE NAME: /str/1/93j021/sj021bdr.dgn	PLOT DATE: 28-JAN-2003
PROJECT MANAGER: G.S. ROGERS	DRAWN BY: STRI
DESIGNED BY: C. MEUNIER	IPARM NAME: sj021row.1
R.O.W. SHEET 8 OF 9 SHEETS	SHEET 6 OF 53