


### Profile

THE GRADES SHOWN TO THE NEAREST HUNDRETH ARE THE ORIGINAL GROUND ELEVATIONS ALONG THE PROPOSED ALIGNMENT. THE GRADES SHOWN TO THE NEAREST THOUSANDTH ARE THE PROPOSED GRADES FOR THE NEW ALIGNMENT.

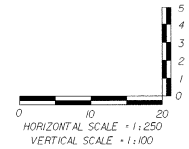

SHEET NAME: <b>MAINLINE PROFILE</b>	
PROJECT NAME: <b>FAIR HAVEN-HAMPTON</b>	HIGHWAY NO.: TN 6
PROJECT NUMBER: <b>BRO 1443(32)</b>	BRIDGE NO.: 6
FILE NAME: /s11/93/02/sj021ks.dgn	OVER: POLTNEY RIVER
PROJECT MANAGER: G.S. ROGERS	PLOT DATE: 28-JAN-2003
DESIGNED BY: C. WEINER	DRAWN BY: STR
BRIDGE SHEET NUMBER:	IPARM NAME: 2100p21
	SHEET 12 OF 53