

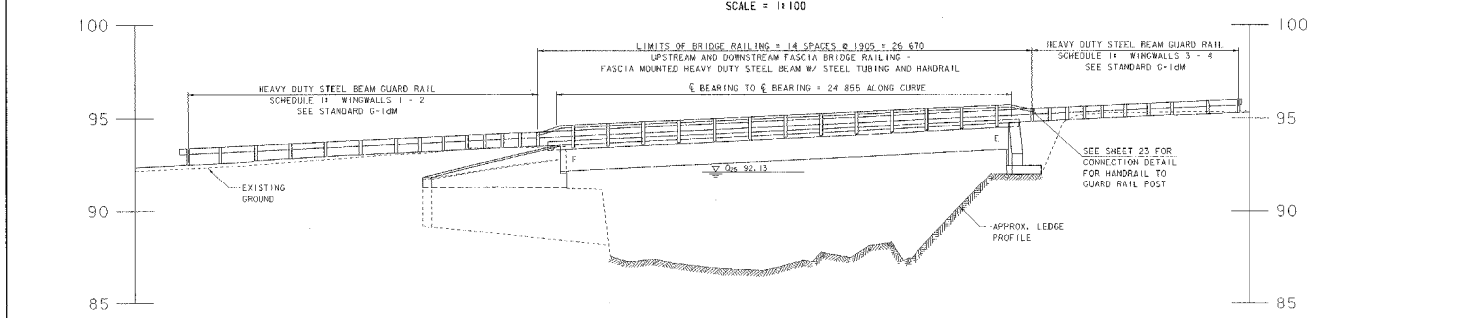


PLAN

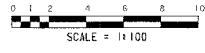

ELEVATION

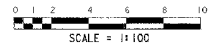

SHEET NAME: <b>PLAN AND ELEVATION SHEET</b>	
PROJECT NAME: <b>FAIR HAVEN-HAMPTON</b>	HIGHWAY NO.: <b>104</b>
PROJECT NUMBER: <b>BRO 1443(32)</b>	BRIDGE NO.: <b>6</b>
	OVERS: <b>POULTNEY RIVER</b>
FILE NAME: <b>/etc/1/03/02/030206.dwg</b>	PLOT DATE: <b>28-JAN-2003</b>
PROJECT MANAGER: <b>S.S. ROGERS</b>	DRAWN BY: <b>STB</b>
DESIGNED BY: <b>C. WELCHER</b>	PARM NAME: <b>s302p.e1</b>
BRIDGE SHEET NUMBER:	SHEET <b>16</b> OF <b>53</b>