



PLAN

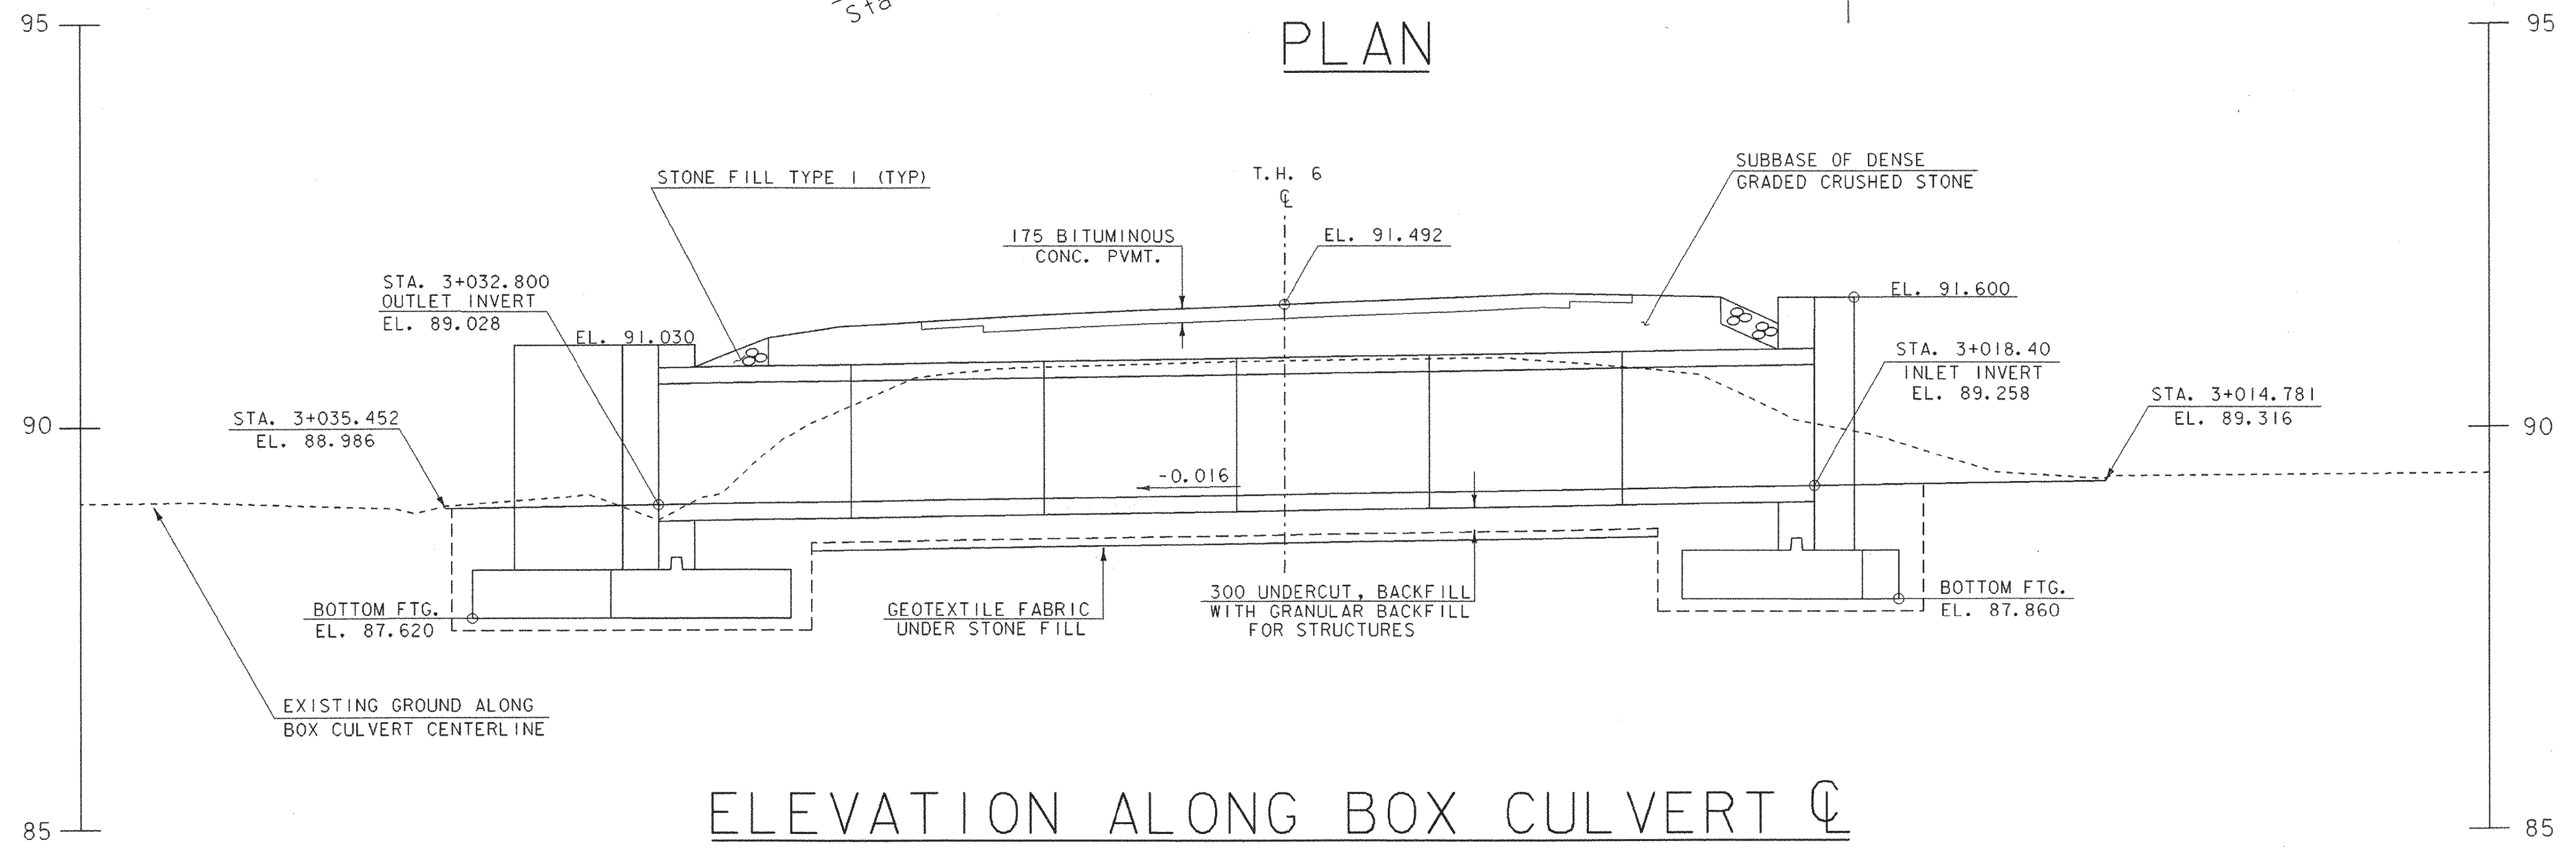

ELEVATION ALONG BOX CULVERT C

DATUM	
VERTICAL	_____
HORIZONTAL	_____

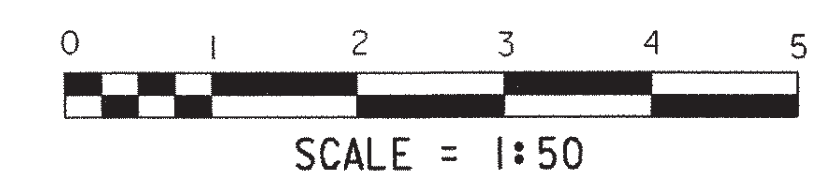

SHEET NAME: BOX PLAN AND ELEVATION SHEET	
PROJECT NAME: FAIR HAVEN-HAMPTON	HIGHWAY NO.: TH 6
PROJECT NUMBER: BRO 1443(32)	BRIDGE NO.: 6
FILE NAME: /str/93j021/boxpe.dgn	OVER: POULTNEY RIVER
PROJECT MANAGER: G.S. ROGERS	PLOT DATE: 28-JAN-2003
DESIGNED BY: C. MEUNIER	DRAWN BY: STRI
BRIDGE SHEET NUMBER:	IPARM NAME: sj02lbp.ej
	SHEET 31 OF 53