
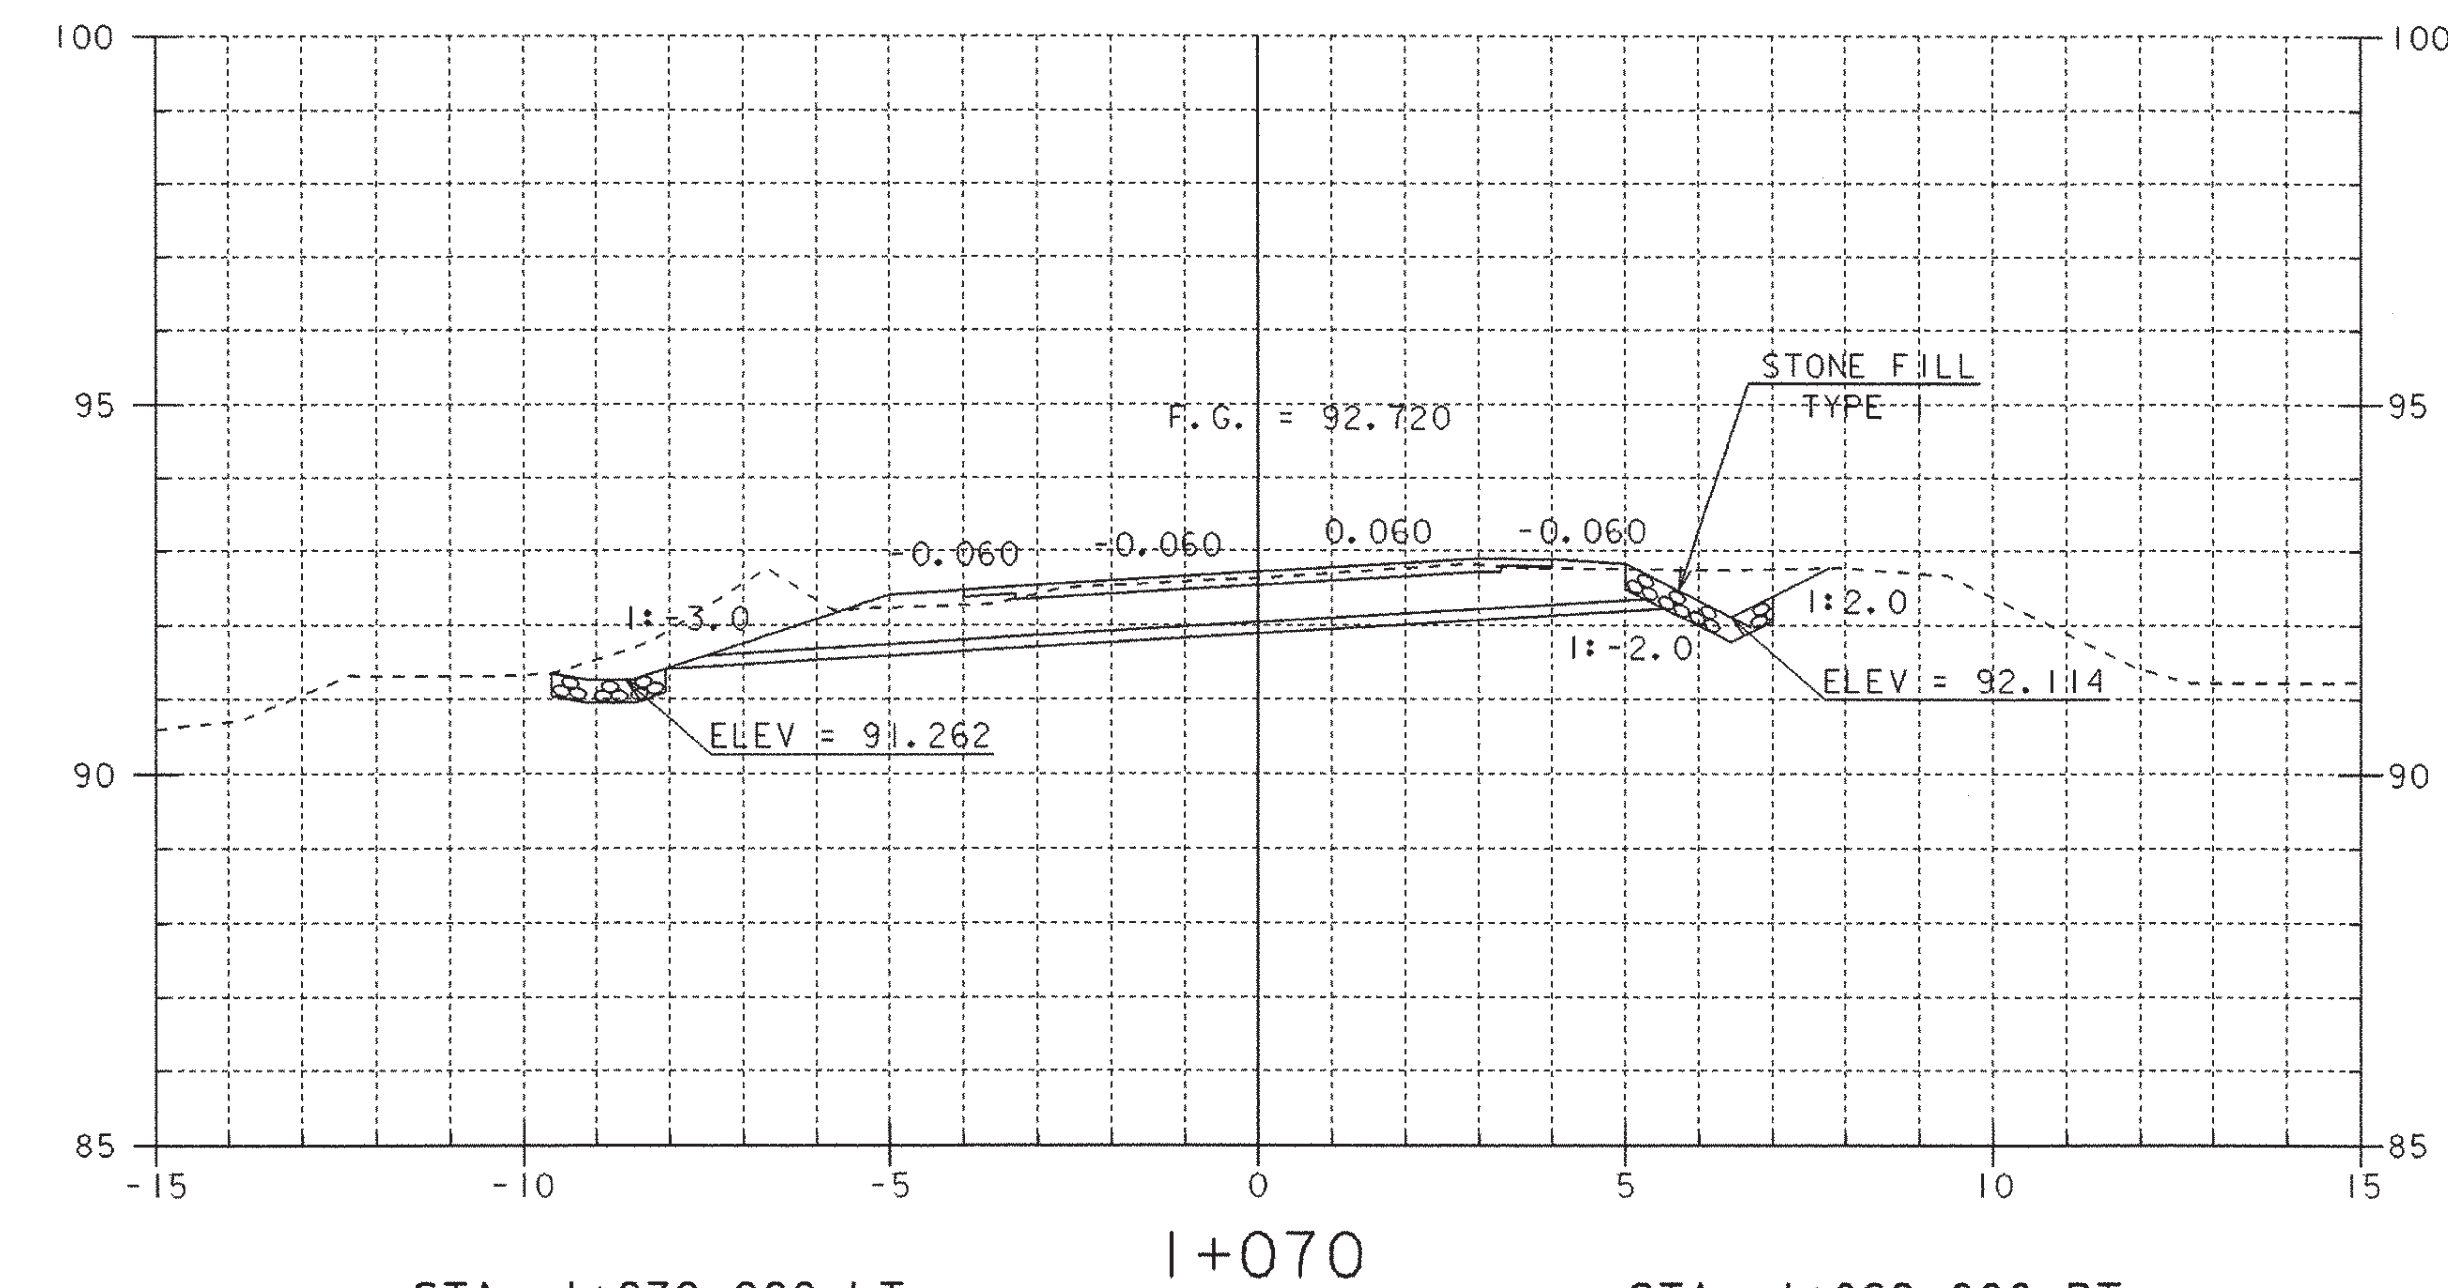


STA. I+080.500 RT
END DITCH
END STONE FILL, TYPE I

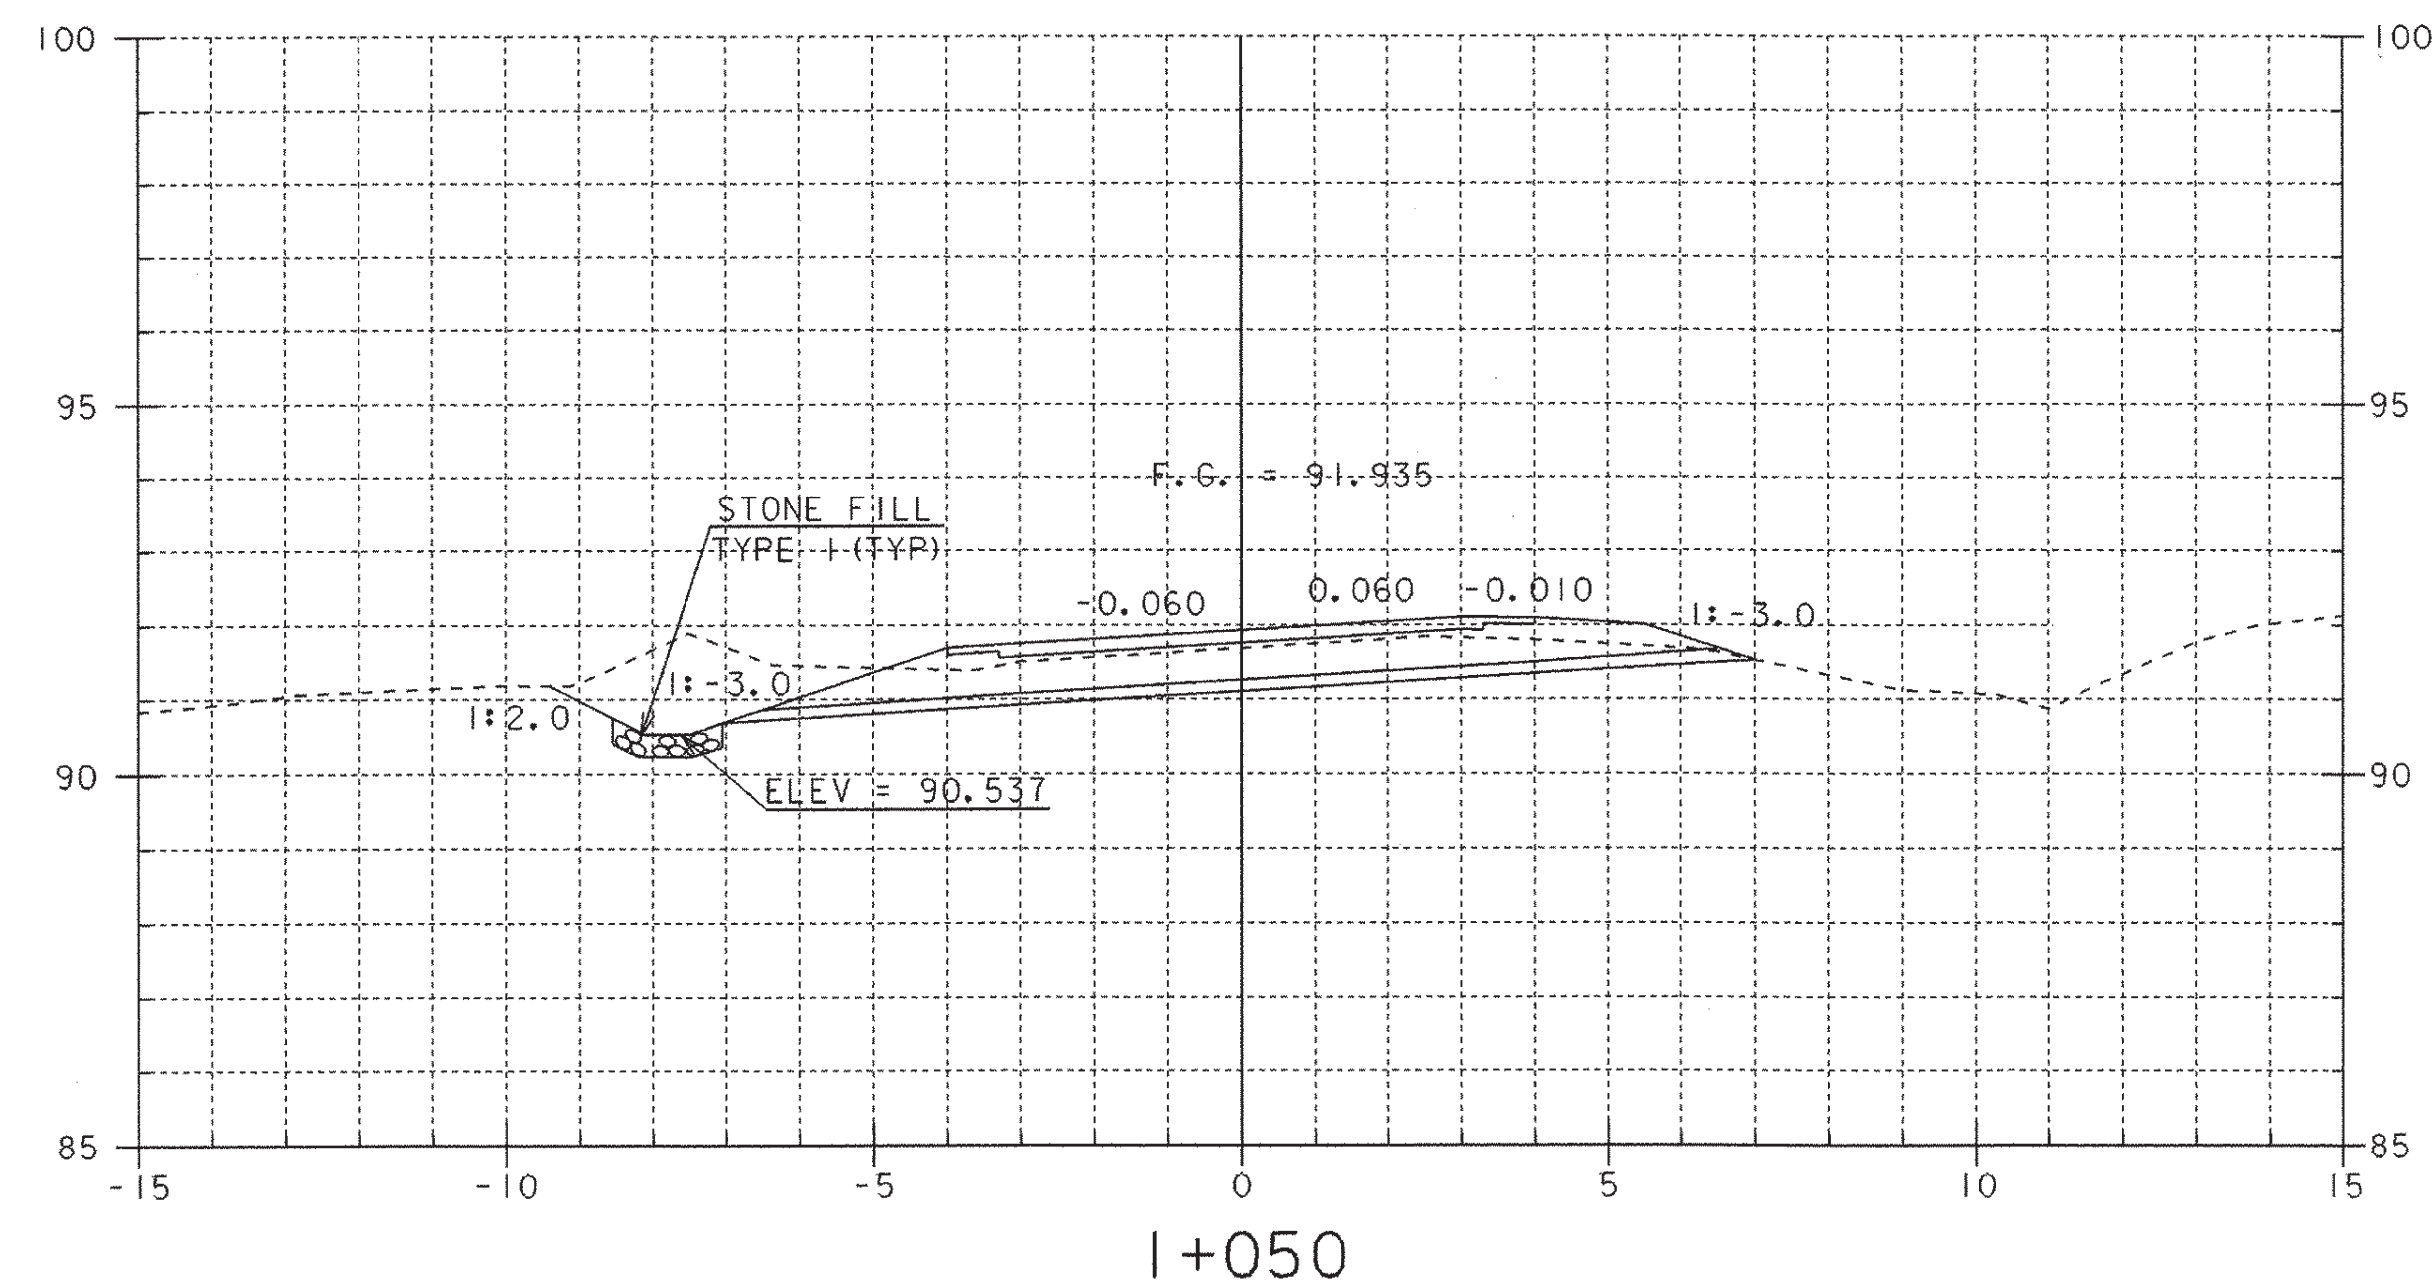

STA. I+070.000 LT
END STONE FILL, TYPE I DITCH

STA. I+068.000 RT
BEGIN DITCH
BEGIN STONE FILL, TYPE I

SHEET NAME: MAINLINE CROSS SECTIONS	
PROJECT NAME: FAIR HAVEN-HAMPTON	HIGHWAY NO.: TH 6
PROJECT NUMBER: BRO 1443(32)	BRIDGE NO.: 6
	OVER: POULTNEY RIVER
FILE NAME: /s+r/93j021/sj021xs.dgn	PLOT DATE: 28-JAN-2003
PROJECT MANAGER: G.S. ROGERS	DRAWN BY: STRI
DESIGNED BY: C. MEUNIER	IPARM NAME: sj021m4.1
BRIDGE SHEET NUMBER:	SHEET 40 OF 53