


NOTE: ALL TOS ELEV. @ STEEL CAMBERED/NO LOAD POSITION


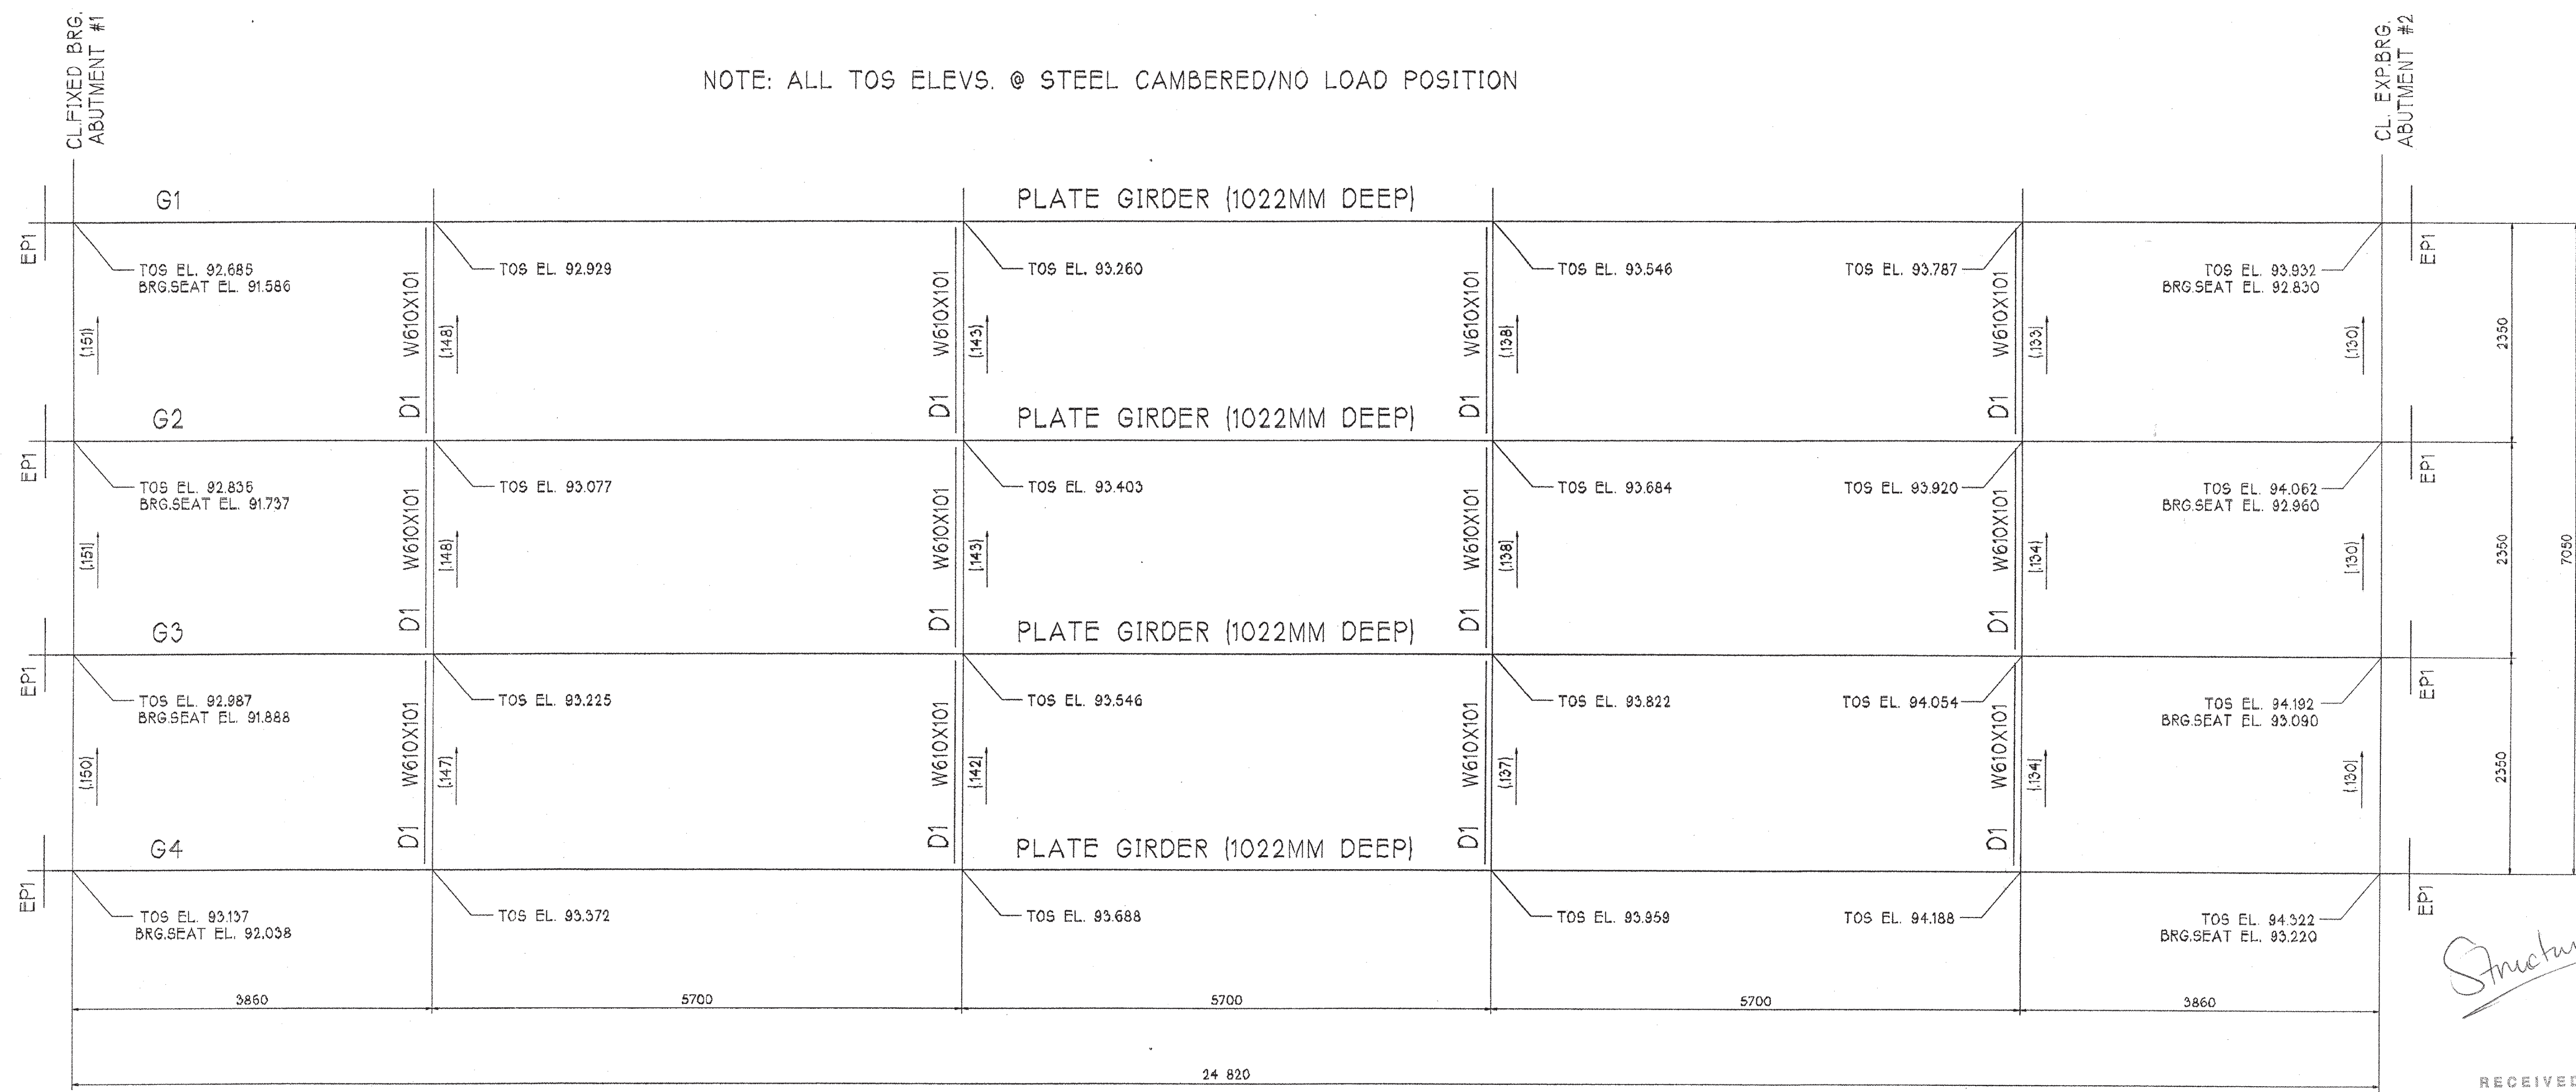


**ERECTION FRAMING PLAN**  
NOT TO SCALE  
(BEARINGS/ANCHORS BY OTHERS)

*Structural*

RECEIVED  
CK'D BY *ML* OK'D BY *Chn*  
APR 14 2003  
RESUBMIT *AS NOTED* APPROVED *AS NOTED*  
BY *GJR* DATE *4/15/03*

**FOR APPROVAL**

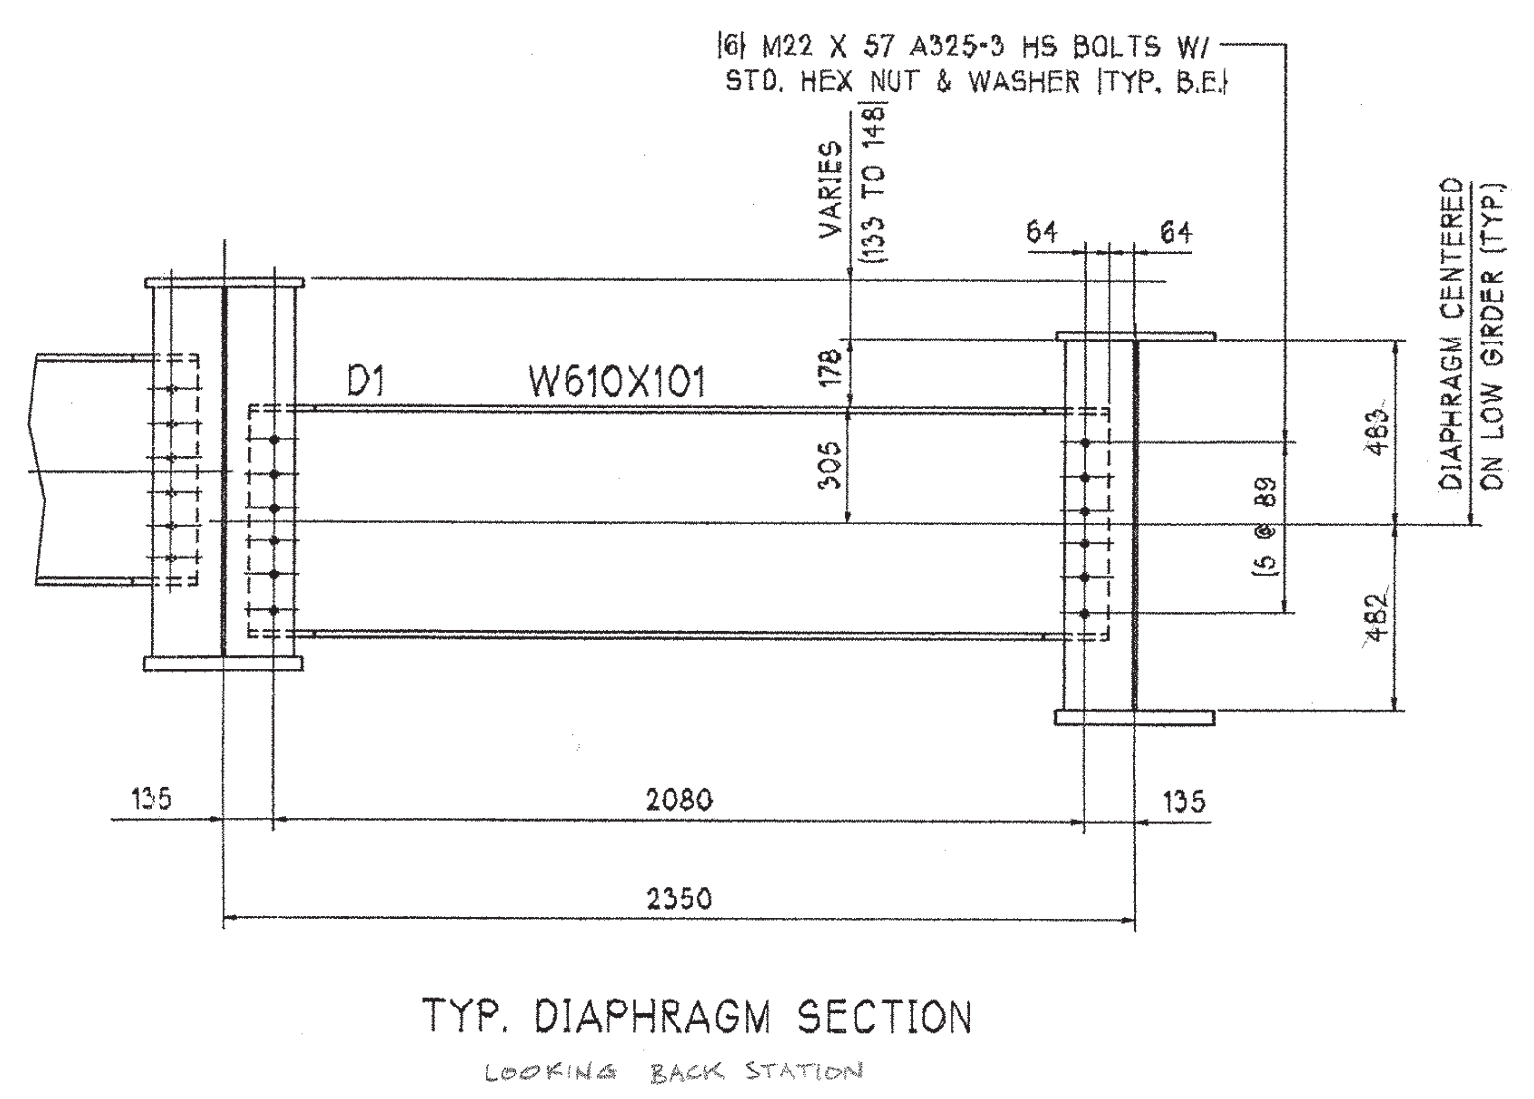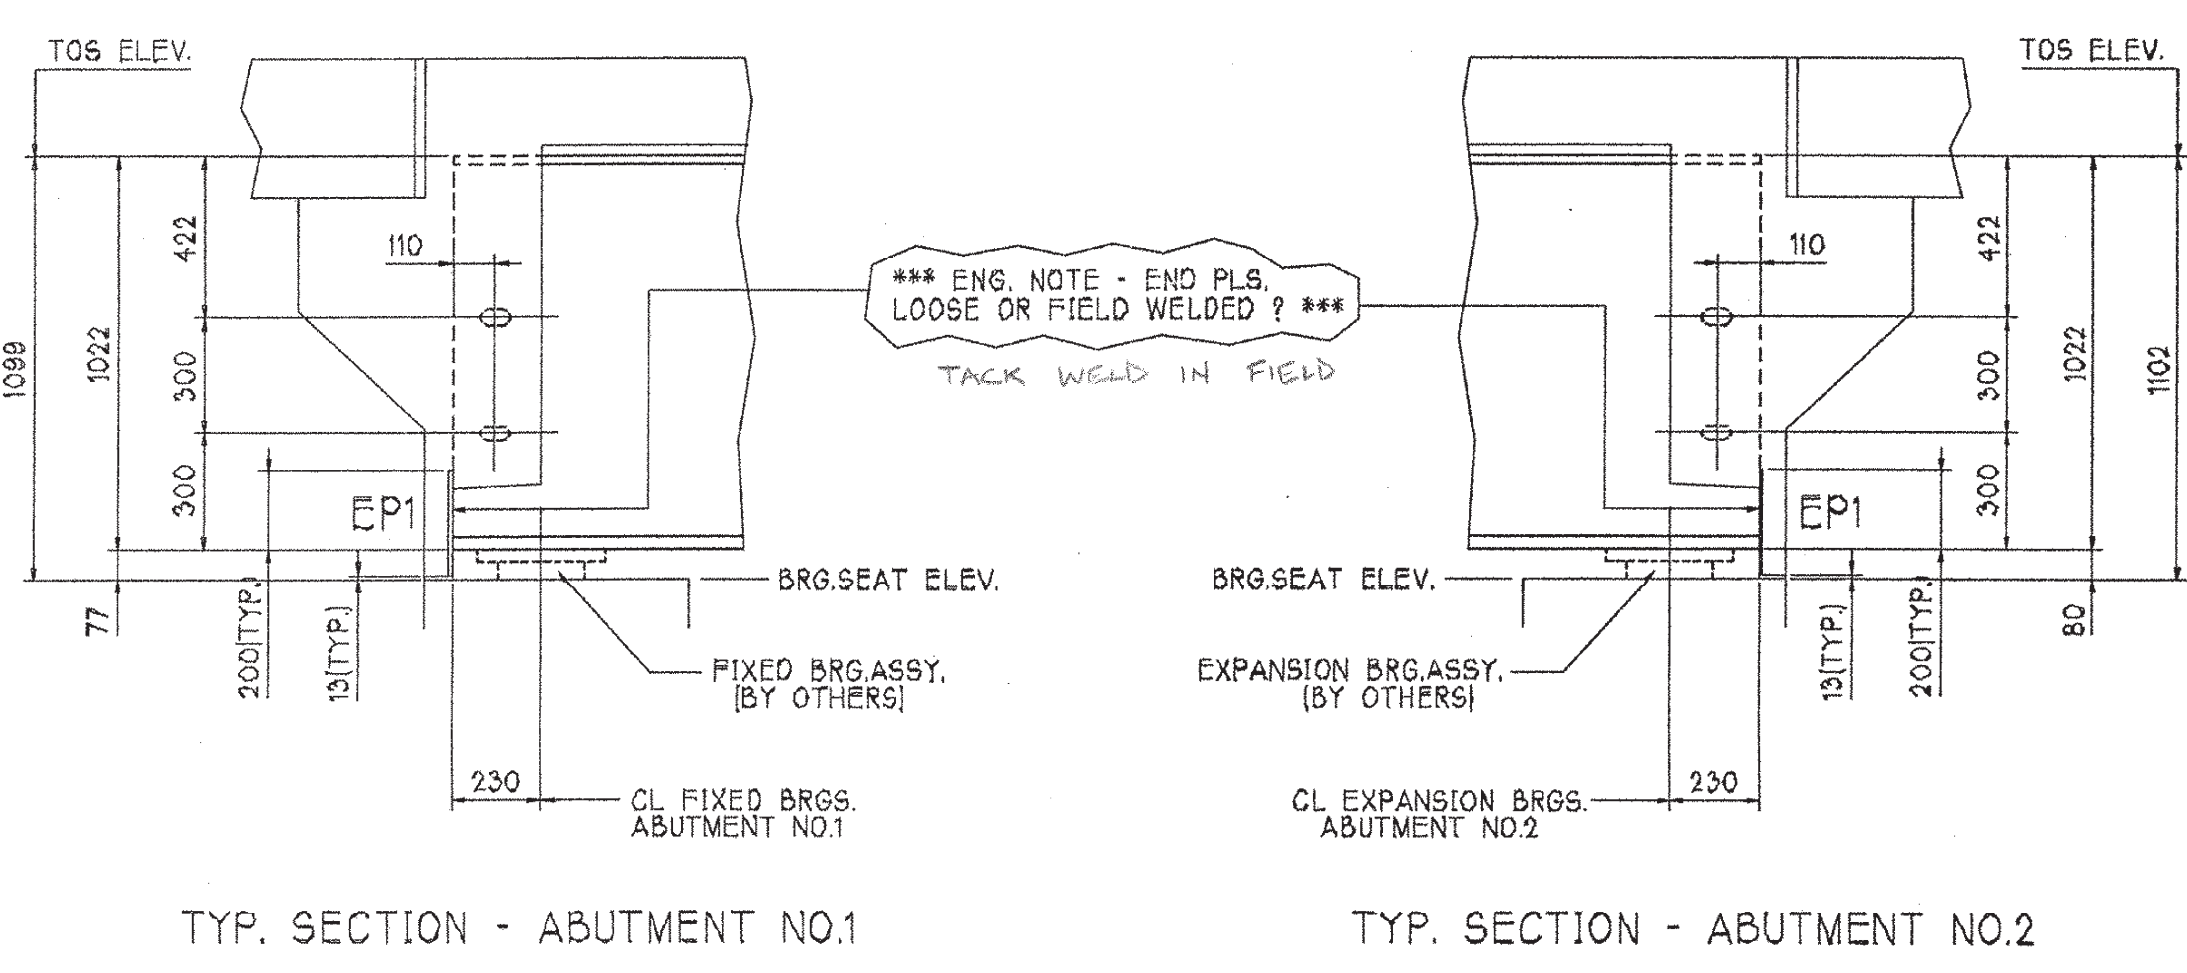

(XXX) : DESIGNATES TOS ELEV. DIFFERENTIAL & DIRECTION OF DOWNWARD SLOPE

ITEM NO.	506.55	BR. NO.	6	PROJ. NO.	BRO 1443(32)
TITLE: STRUCTURAL STEEL ERECTION PLAN					
APPROVED:	 STRUCTURAL STEEL FABRICATORS MAJOR STEEL BRIDGES 860-747-3700				
PRINT DIST.					
6 3/25/03 APPR.					
ORIG. FAB.					
JOB: CL 2 LOCAL BRIDGE NO. 6 RTE. TH 6 OVER THE POULTNEY RIVER RUTLAND COUNTY FAIRHAVEN, VERMONT - HAMPTON, NEW YORK					
CUSTOMER: AUSTIN CONSTRUCTION, INC.					
DESIGNER: VERMONT AGENCY OF TRANSPORTATION					
WORK ORDER NO.				DRAWING NO.	
15948				E1	
CHECKED	DS/NEC	3/24/03			
DRAWN	RAB/NEC	3/12/03			