

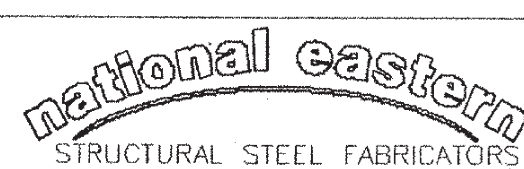
### CAMBER DIAGRAM - G1 THRU G4

GIRDER

ALL WEBS/FLANGES AASHTO M270, GR. 345W, T2

RECEIVED  
 OK'D BY *[Signature]* OK'D BY *[Signature]*  
 MAR 25 2003  
 RESUBMIT \_\_\_\_\_ APPROVED   
 BY GSR DATE 4/15/03

FOR APPROVAL

ITEM NO.	506.55	BR. NO.	6	PROJ. NO.	BRO 1443[32]
TITLE: CAMBER DIAGRAMS					
APPROVED:			 STRUCTURAL STEEL FABRICATORS MAJOR STEEL BRIDGES PLAINVILLE, CT 860-747-3700		
PRINT DIST.					
6	3/25/03	APPR.	JOB: CL 2 LOCAL BRIDGE NO. 6 RTE. TH 6 OVER THE POULTNEY RIVER RUTLAND COUNTY FAIRHAVEN, VERMONT - HAMPTON, NEW YORK		
ORIG.		FAB.			
DESIGNER: VERMONT AGENCY OF TRANSPORTATION			CUSTOMER: AUSTIN CONSTRUCTION, INC.		
WORK ORDER NO.			DRAWING NO.		
15948			10-1		
CHECKED	DS/NEC	3/24/03	REV.		
DRAWN	RAB/NEC	3/13/03			