

REMOVAL OF EXISTING GUARD RAIL
 STA 1+076 LT - STA 1+082 LT
 STA 1+078 RT - STA 1+082 RT
 STA 1+108 RT - STA 1+110 RT
 STA 1+108 LT - STA 1+113 LT

HEAVY DUTY STEEL BEAM GUARD RAIL
 STA 1+063.5 RT - STA 1+082.0 RT
 STA 1+065.5 LT - STA 1+081.0 LT
 STA 1+108.0 RT - STA 1+118.6 RT
 STA 1+108.6 LT - STA 1+124.2 LT

BRIDGE RAILING - HEAVY DUTY STEEL BEAM
 FASCIA MOUNTED W/ STEEL TUBING W/
 HANDRAIL
 STA 1+081.2 LT - STA 1+108.6 LT
 STA 1+082.0 RT - STA 1+108 RT

ANCHORS FOR STEEL BEAM GUARD RAIL
 STA 1+065.5 RT
 STA 1+067.5 LT
 STA 1+116.6 RT
 STA 1+122.2 LT

DRILLING AND BLASTING OF SUBGRADE
 STA 1+110 - STA 1+150

REMOVE FENCE
 STA 1+120 RT - STA 1+160 RT
 STA 1+119 RT - STA 1+125 RT
 STA 1+056 RT - STA 1+063 RT

REMOVE AND RESET FENCE
 STA 1+115 LT - STA 1+160 LT
 STA 1+139 LT - STA 1+156.5 LT
 (ELECTRIC & BARBED WIRE FENCE)

CONSTRUCT DRIVES (GRAVEL)
 STA 1+059 RT
 STA 1+121 RT


CONSTRUCT STONE FILL, TYPE J, DITCH
 STA 1+050 LT - STA 1+070 LT 077.7
 STA 1+127.5 LT - STA 1+160 RT
 126.1

NEW BARBED WIRE FENCE (2 STRANDS)
 STA 1+124.5 RT - STA 1+160 RT

SOLID ROCK EXCAVATION
 STA 1+110 LT - STA 1+128 LT

END R.O.W. PROJECT
 BRO 1443 (32) STA. 1+1157.4
 8.5 M LT. (27.9')

CURVE DATA
 $\Delta = 78.000^\circ$
 R = 138.000 m
 T = 111.680 m
 L = 187.790 m
 E = 39.530 m
 BANK = 0.060

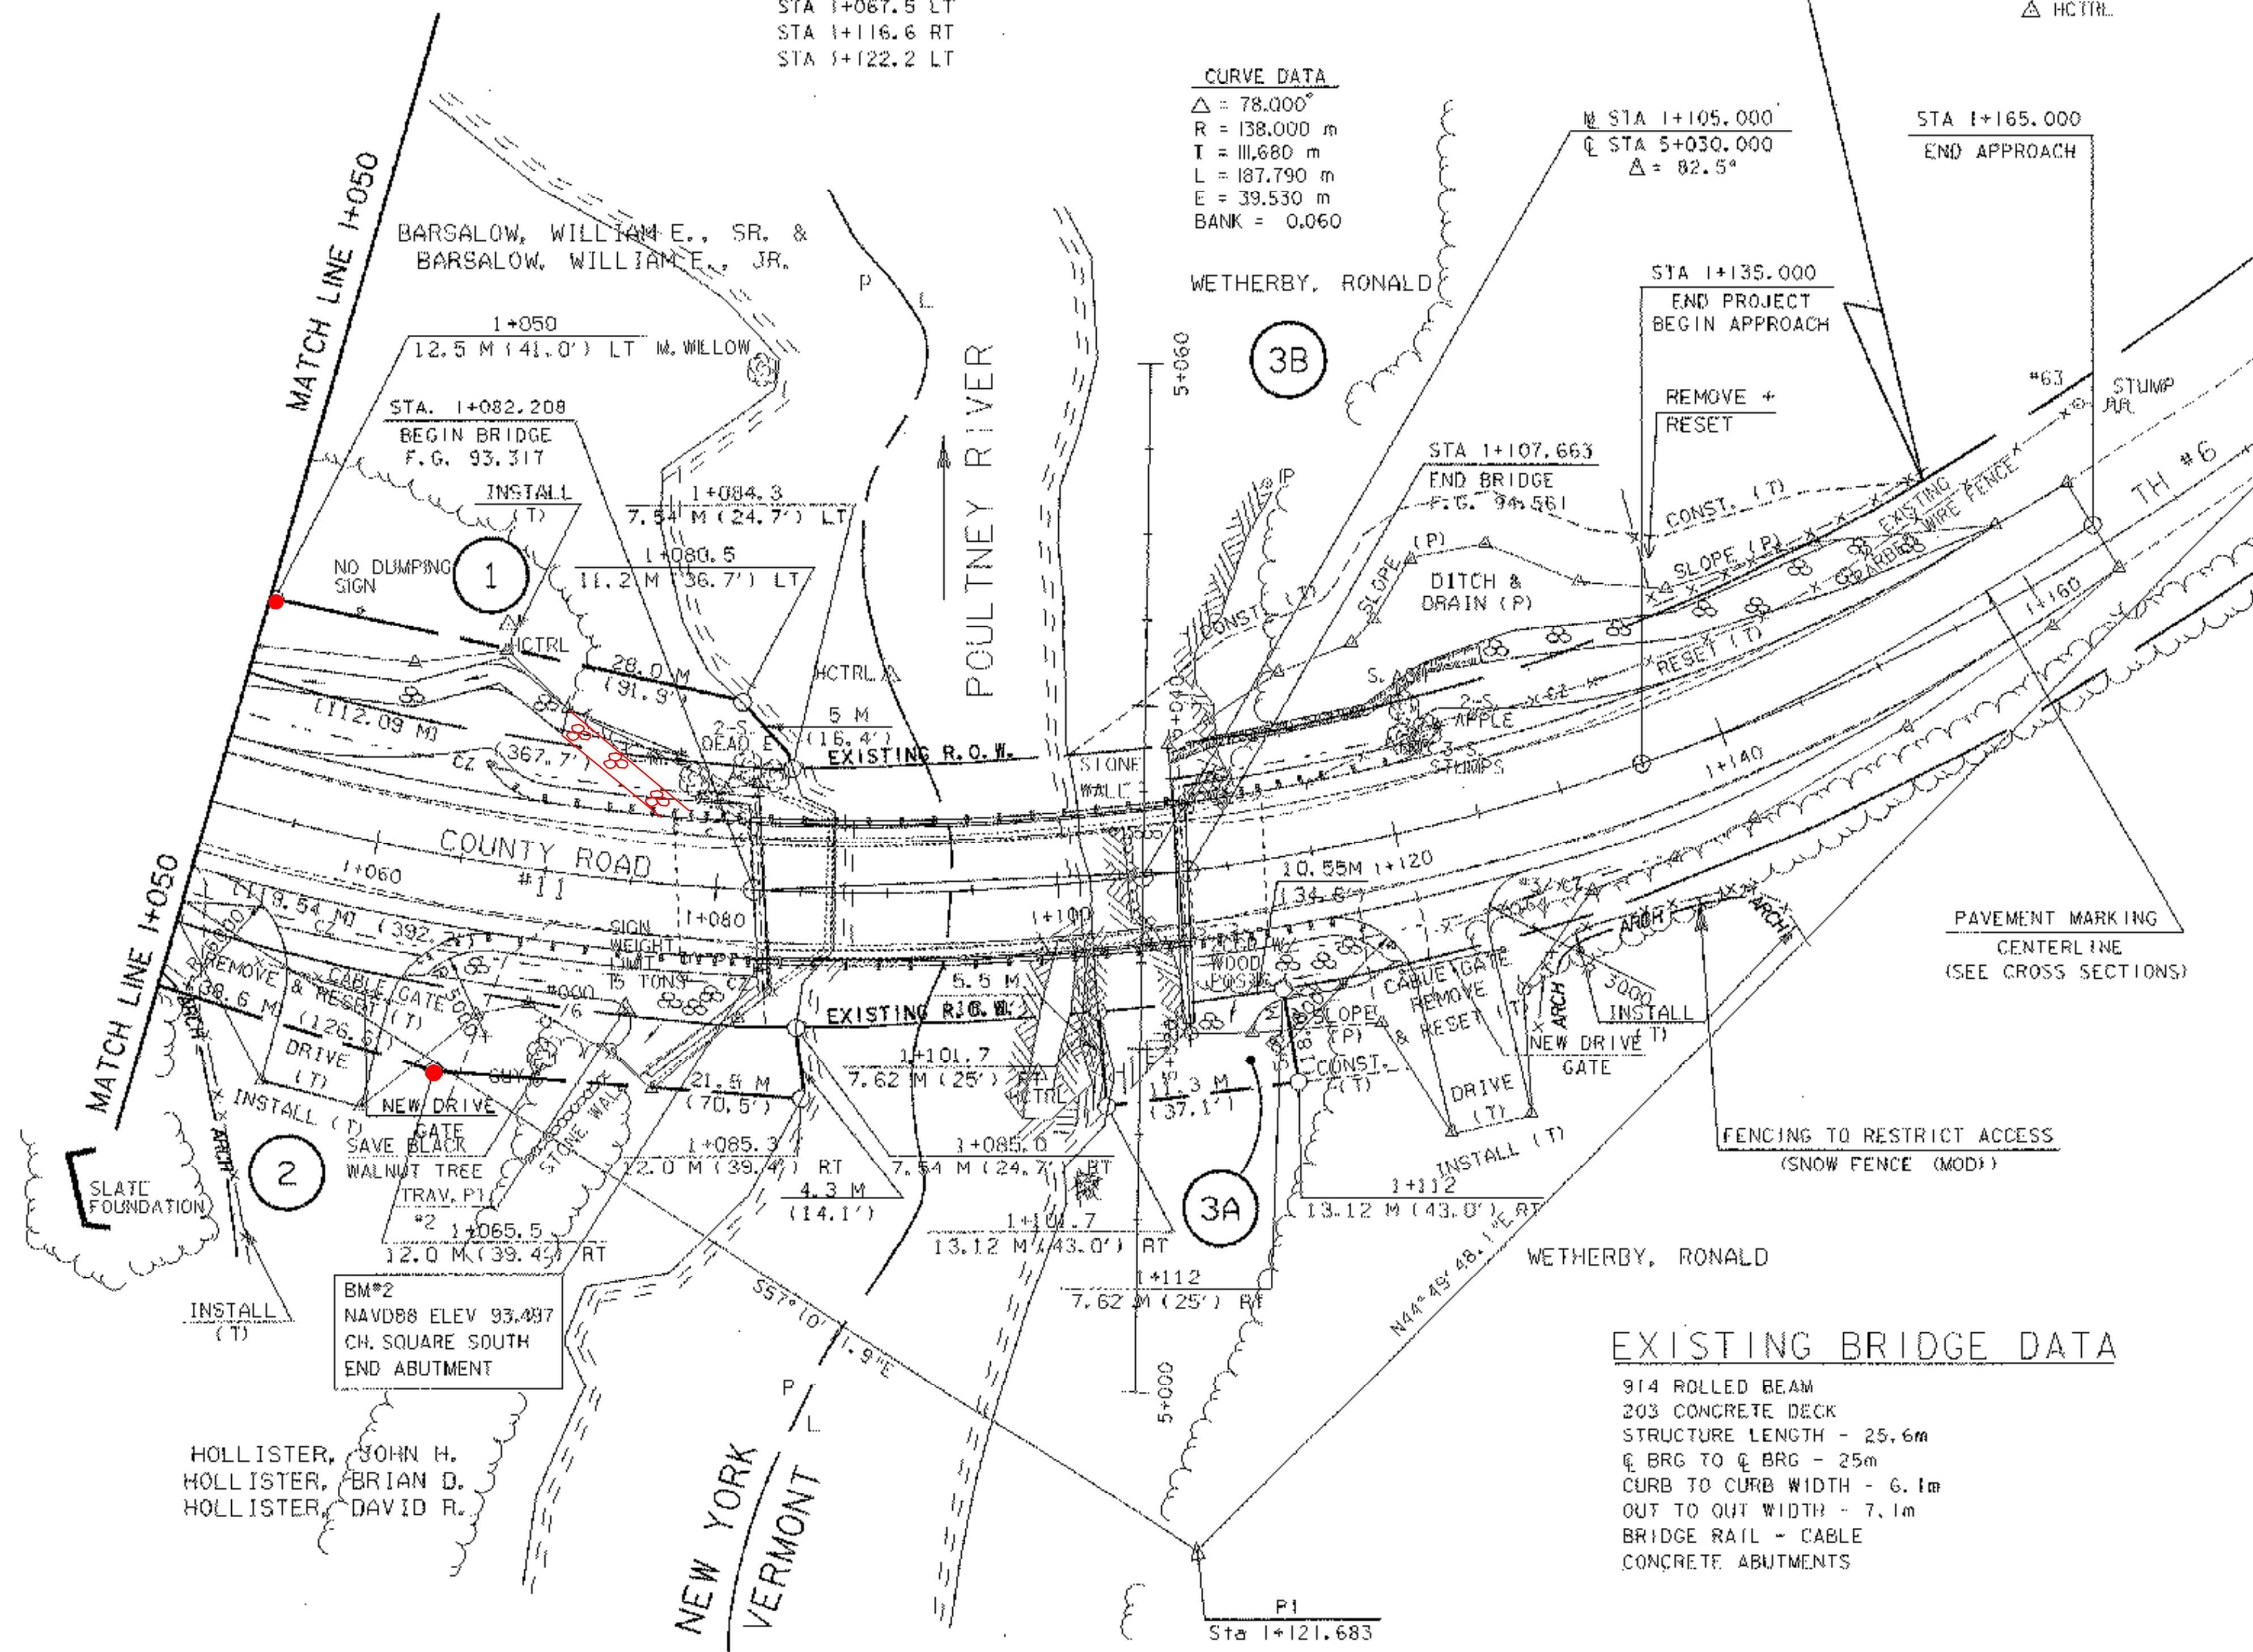


BM#3
 NAVD88 ELEV 104.368
 RRST IN LARGE OAK

FOR R.O.W. USE ONLY

EXISTING BRIDGE DATA

914 ROLLED BEAM
 203 CONCRETE DECK
 STRUCTURE LENGTH - 25.6m
 @ BRG TO @ BRG - 25m
 CURB TO CURB WIDTH - 6.1m
 OUT TO OUT WIDTH - 7.1m
 BRIDGE RAIL - CABLE
 CONCRETE ABUTMENTS

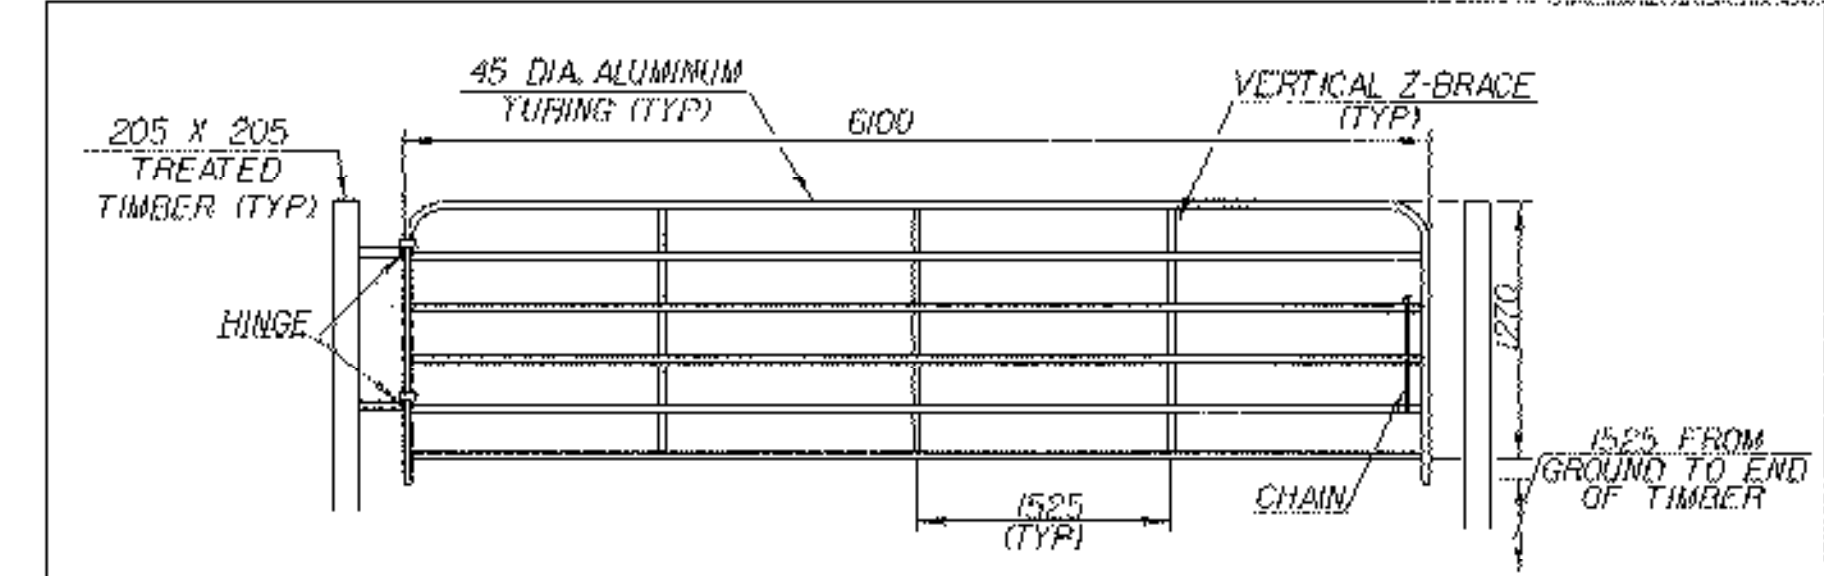

ALUMINUM DRIVE GATE
 NTS



SHEET NAME: LAYOUT SHEET 2	
PROJECT NAME: FAIR HAVEN-HAMPTON	HIGHWAY NO.: TH 6
PROJECT NUMBER: BRO 1443(32)	BRIDGE NO.: 6
FILE NAME: /s/r/93j021/sj021bdr.dgn	OVER: POULTNEY RIVER
PROJECT MANAGER: G.S. ROGERS	PLOT DATE: 28-JAN-2003
DESIGNED BY: C. MEUNIER	DRAWN BY: STRI
R.O.W. SHEET 9 OF 9 SHEETS	IPARM NAME: sj021row21
	SHEET 7 OF 53