


QUANTITY	SIGN LEGEND	SIGN DIMENSIONS		FLANGED CHANNEL	TOTAL AREA SIGNS
		WIDTH (mm)	HEIGHT (mm)		
2	W20-2	1220	1220	2 POSTS	2.977
2	W20-2	1220	1220	2 POSTS	2.977
4	M4-9 (R)	765	610	1 POST	1.867
4	M4-9 (L)	765	610	1 POST	1.867
5	M4-9 (U)	765	610	1 POST	2.333
3	1525 x 765	1525	765	2 POSTS	3.500
4	745 x 610	745	610	1 POST	1.818
2	600 x 450	600	450	1 POST	0.540
4	1525 x 765	1525	765	2 POSTS	4.667
NOT 2 INSTALLED	1525 x 765	1525	765	1 POST	2.333
1	750 x 915	750	915	1 POST	0.686
2	750 x 915	750	915	1 POST	1.373
1	750 x 915	750	915	1 POST	0.686




R11-4  
BLACK TEXT & BORDER  
WITH WHITE BACKGROUND

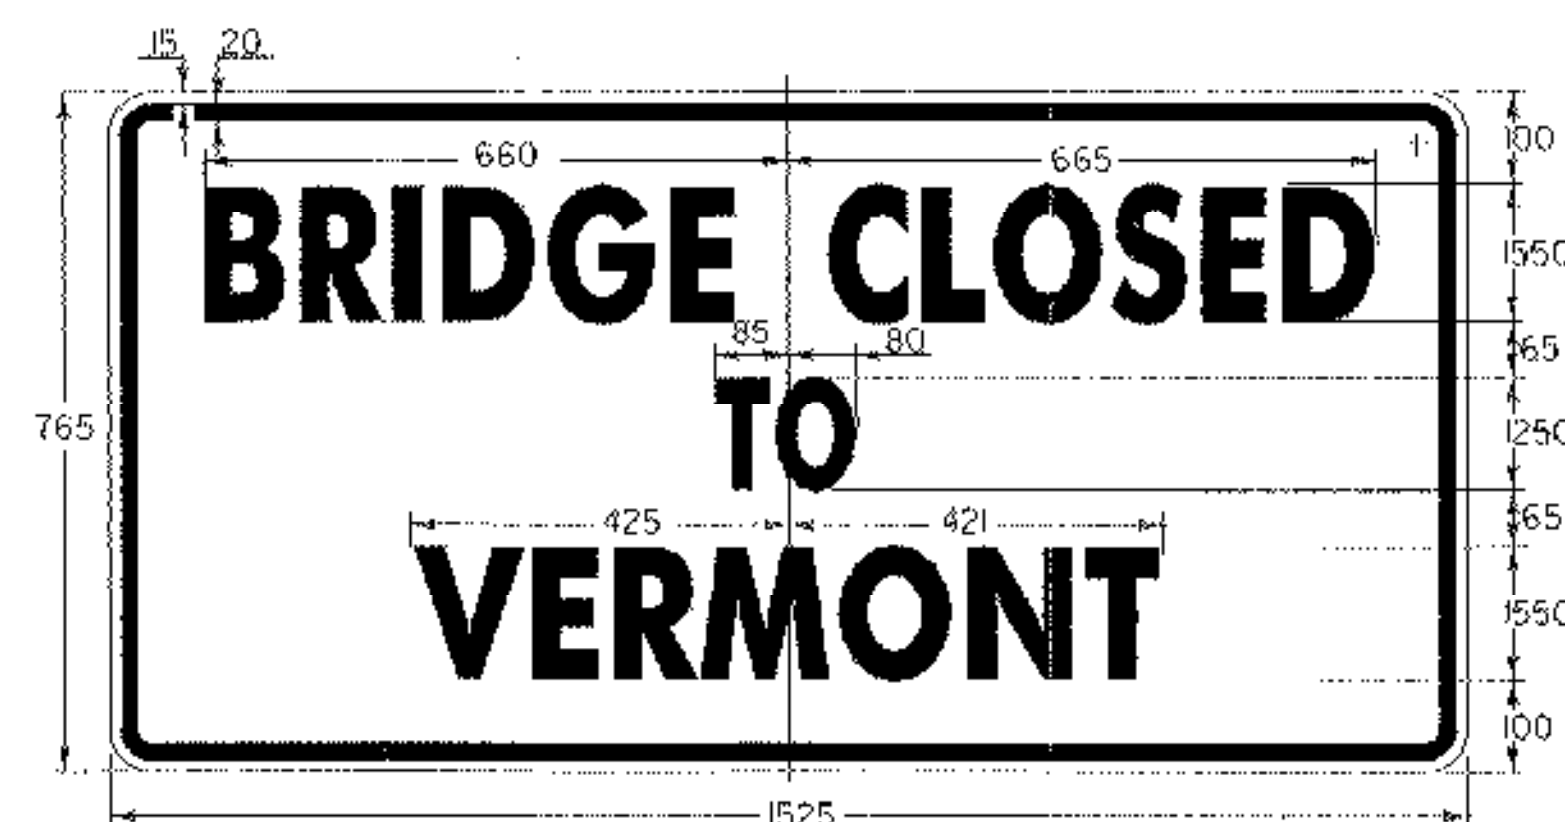


BLACK TEXT & BORDER  
WITH ORANGE BACKGROUND




BLACK TEXT & BORDER  
WITH WHITE BACKGROUND

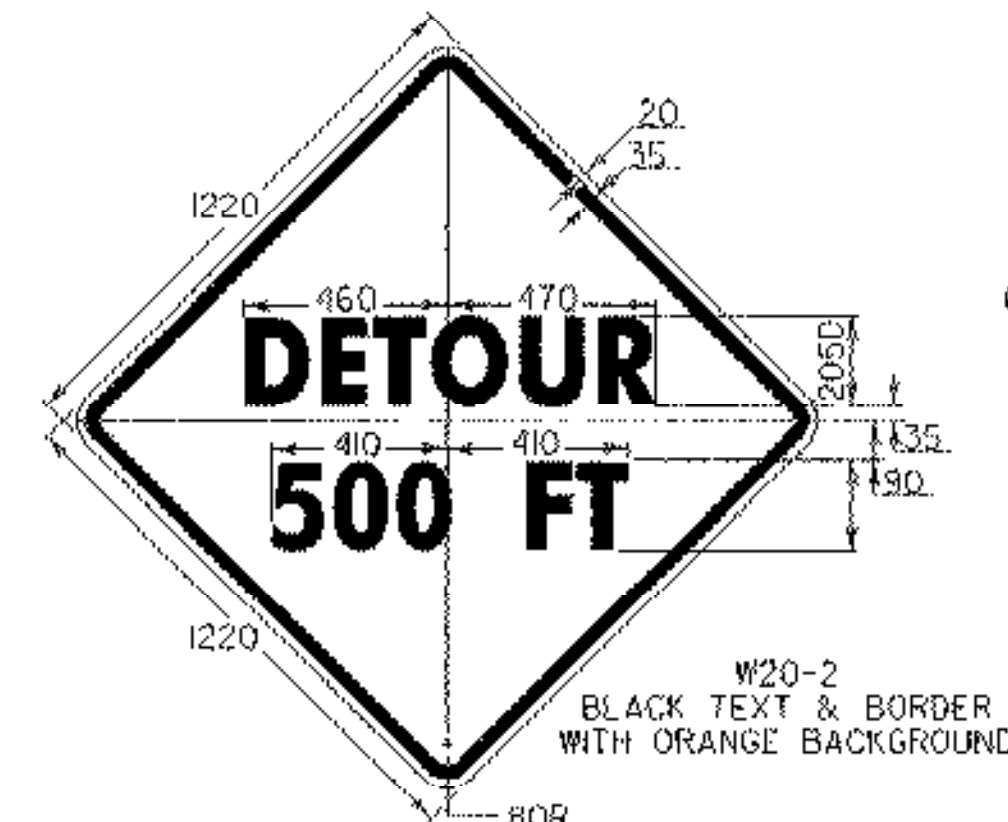


W20-2  
BLACK TEXT & BORDER  
WITH ORANGE BACKGROUND

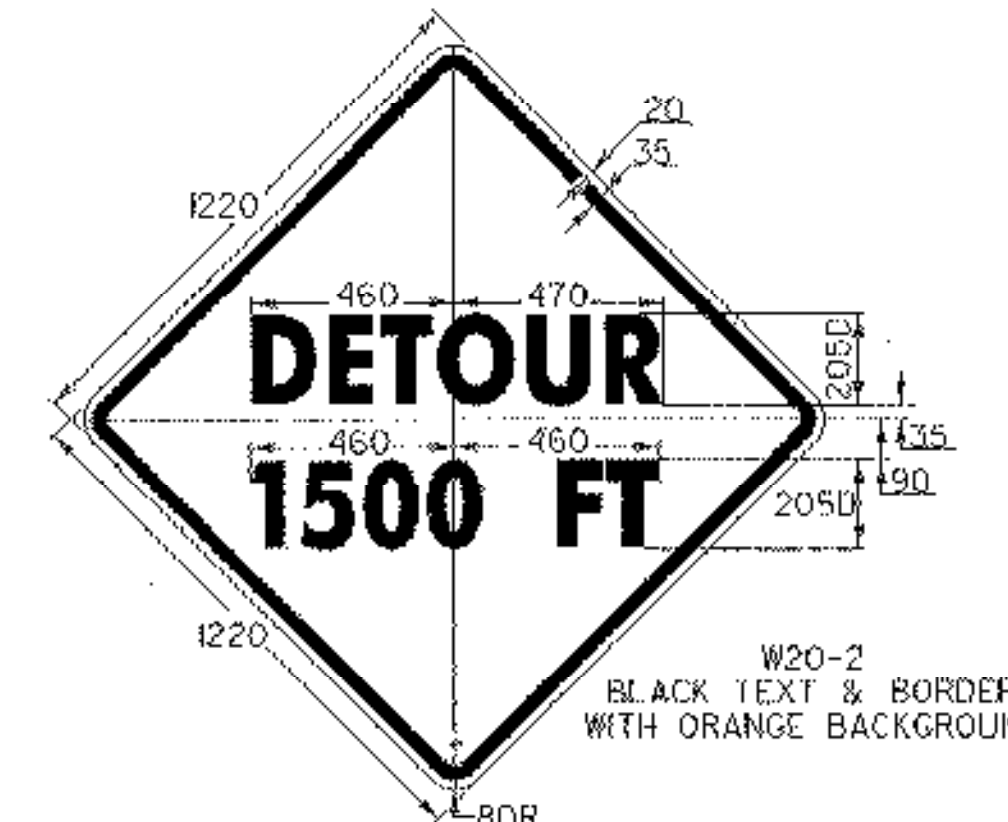


W20-2  
BLACK TEXT & BORDER  
WITH ORANGE BACKGROUND

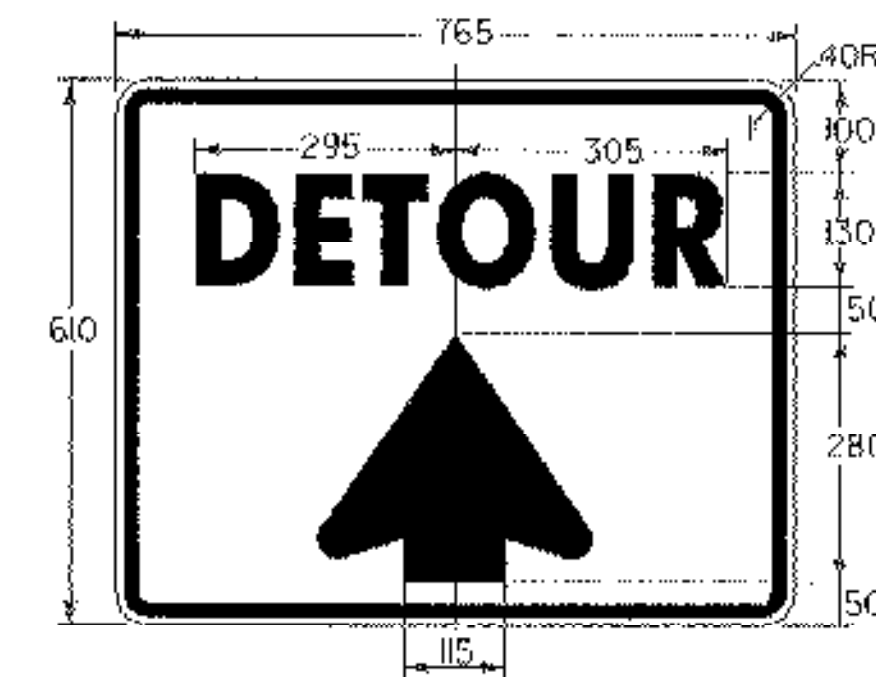


M4-9(U)  
BLACK TEXT & BORDER  
WITH ORANGE BACKGROUND

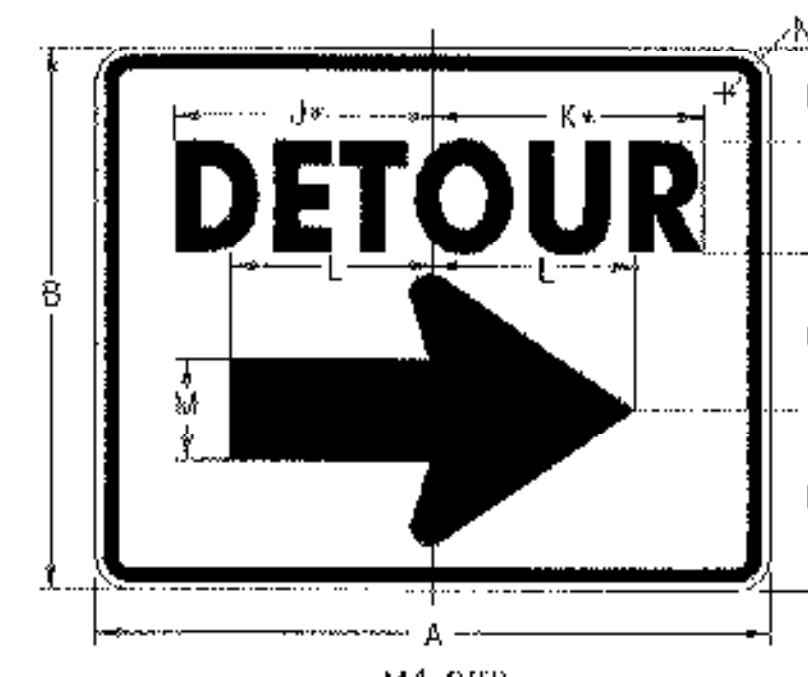


M4-9(R)  
BLACK TEXT & BORDER  
WITH ORANGE BACKGROUND

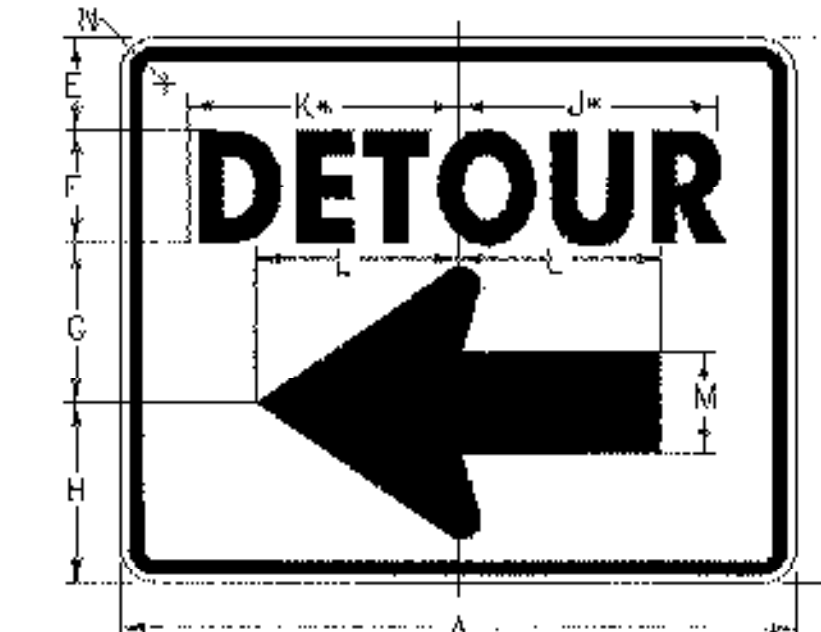


M4-9(L)  
BLACK TEXT & BORDER  
WITH ORANGE BACKGROUND

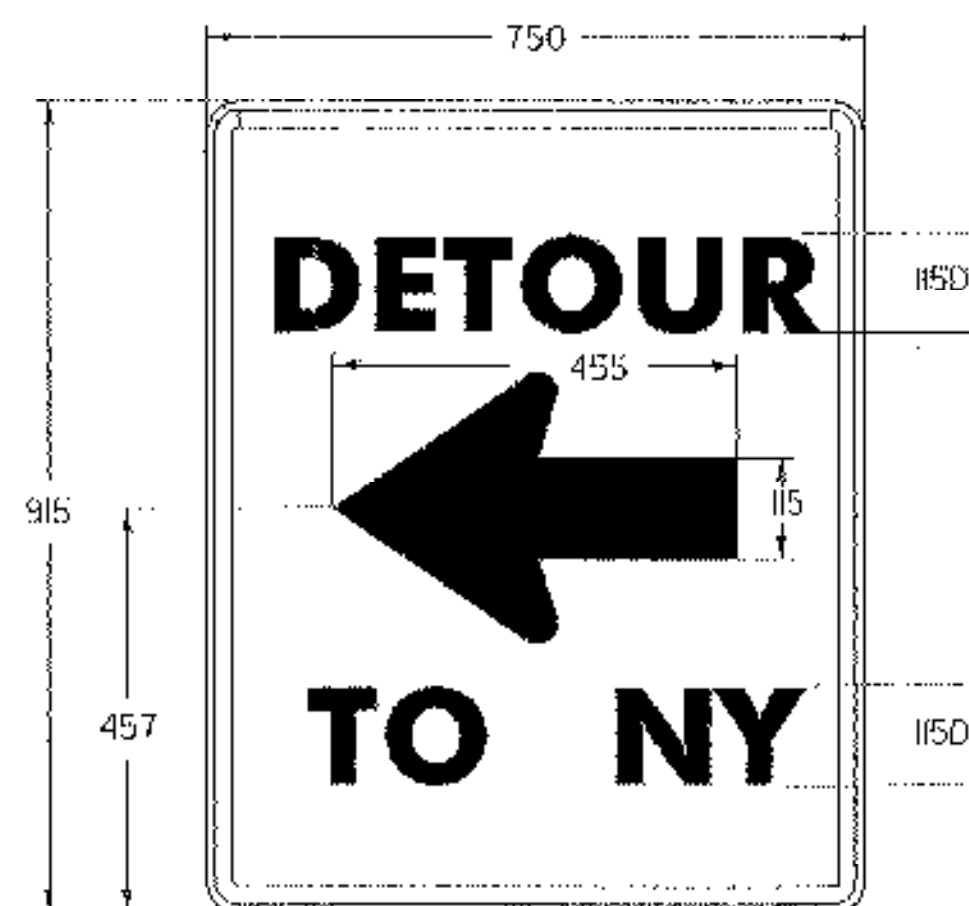


BLACK TEXT & BORDER  
WITH WHITE BACKGROUND

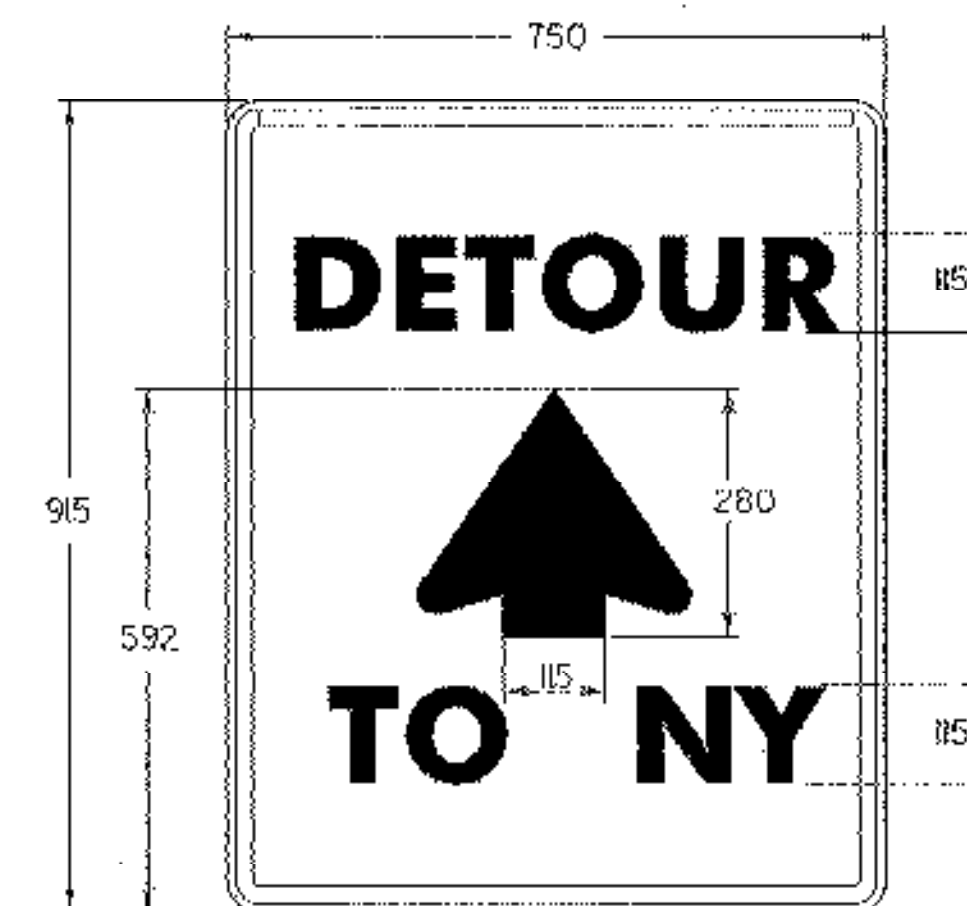


BLACK TEXT & BORDER  
WITH WHITE BACKGROUND

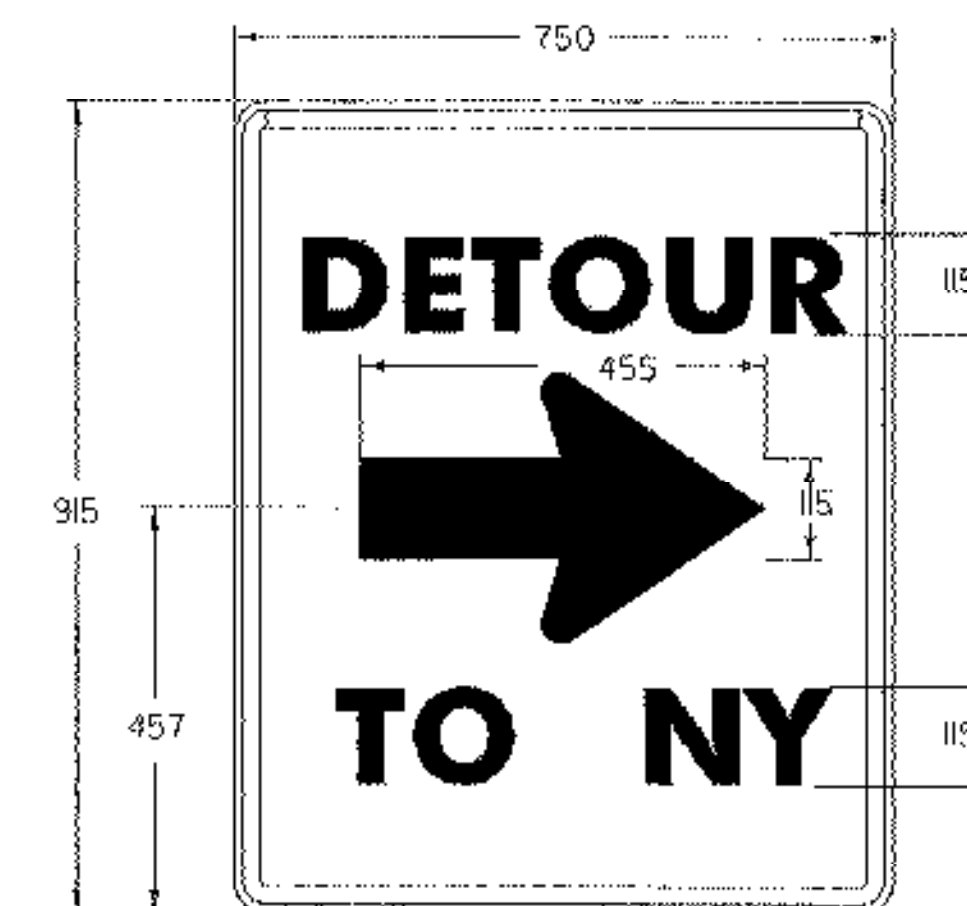

BLACK TEXT & BORDER  
WITH WHITE BACKGROUND

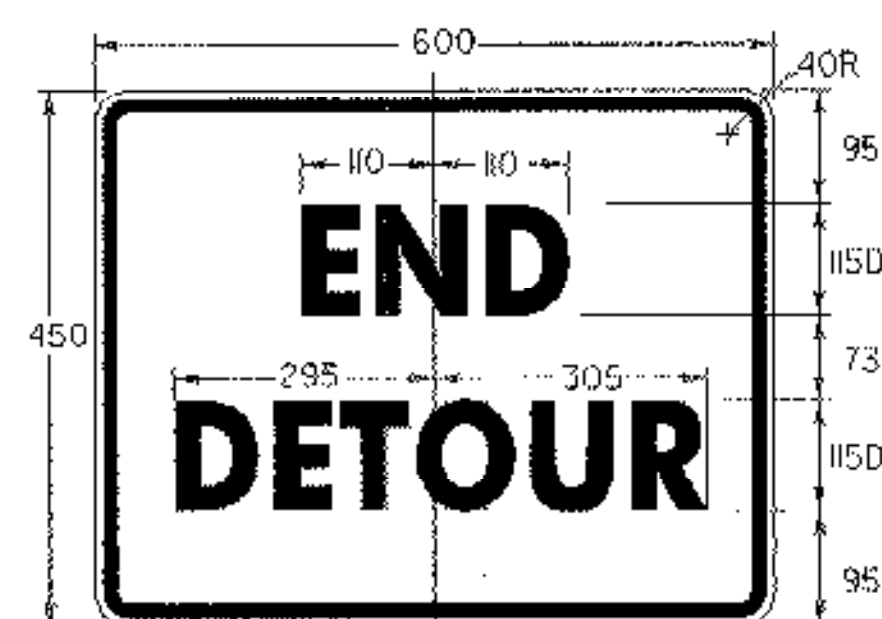

M4-8g  
BLACK TEXT & BORDER  
WITH ORANGE BACKGROUND

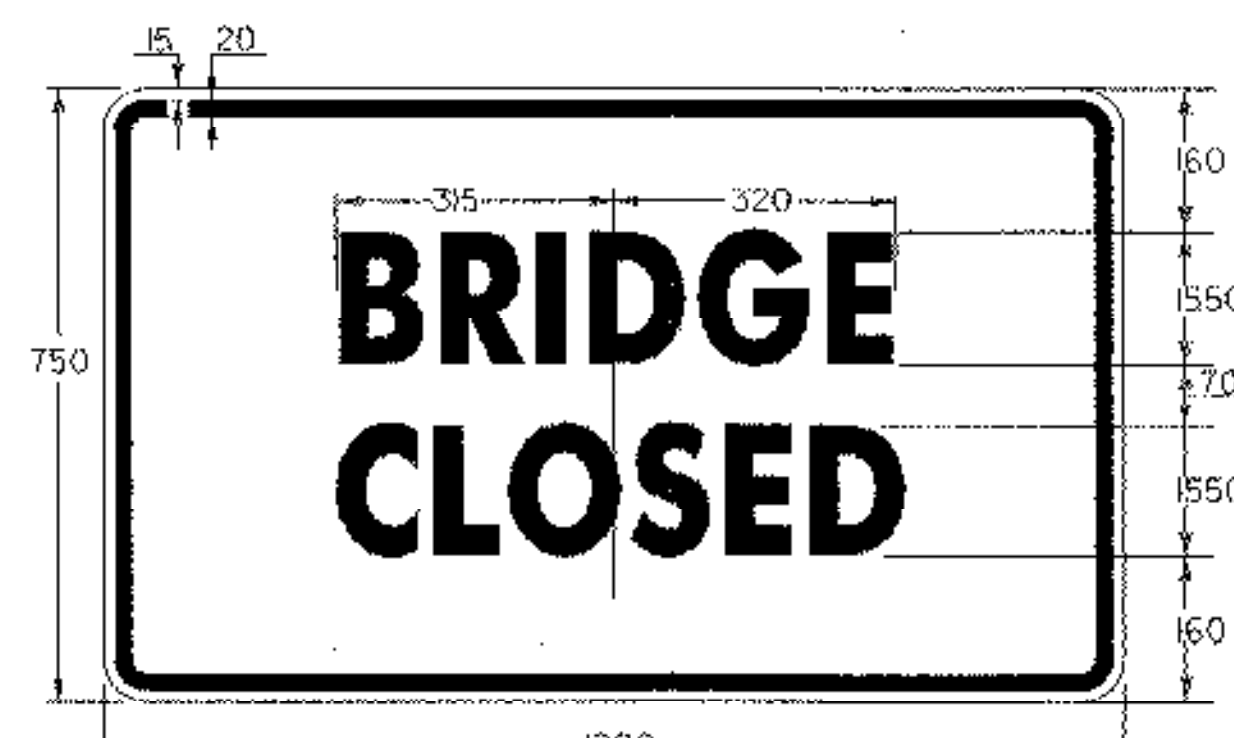

BLACK TEXT & BORDER  
WITH WHITE BACKGROUND

SIGN	DIMENSIONS (INCHES)													*REDUCE SPACING 40%
	A	B	C	D	E	F	G	H	J	K	L	M	N	
STD.	765	610	10	15	100	1300	175	205	295	305	230	115	40	
SPECIAL	1220	915	15	25	155	2050	255	305	495	515	345	180	60	
SPECIAL	1525	1220	20	35	205	2550	355	410	585	610	460	230	80	

SHEET NAME: TRAFFIC DETOUR SIGNING SHEET	
PROJECT NAME: FAIR HAVEN-HAMPTON	HIGHWAY NO.: TH 6
PROJECT NUMBER: BRO 1443(32)	BRIDGE NO.: 6
	OVER: POULTNEY RIVER
FILE NAME: /s/tr/93j021/sj021.tcs.dgn	PLOT DATE: 28-JAN-2003
PROJECT MANAGER: G.S. ROGERS	DRAWN BY: J. GILMORE
DESIGNED BY: C. MEUNIER	IPARM NAME: sj021mp3.1
BRIDGE SHEET NUMBER:	SHEET 15 OF 53