

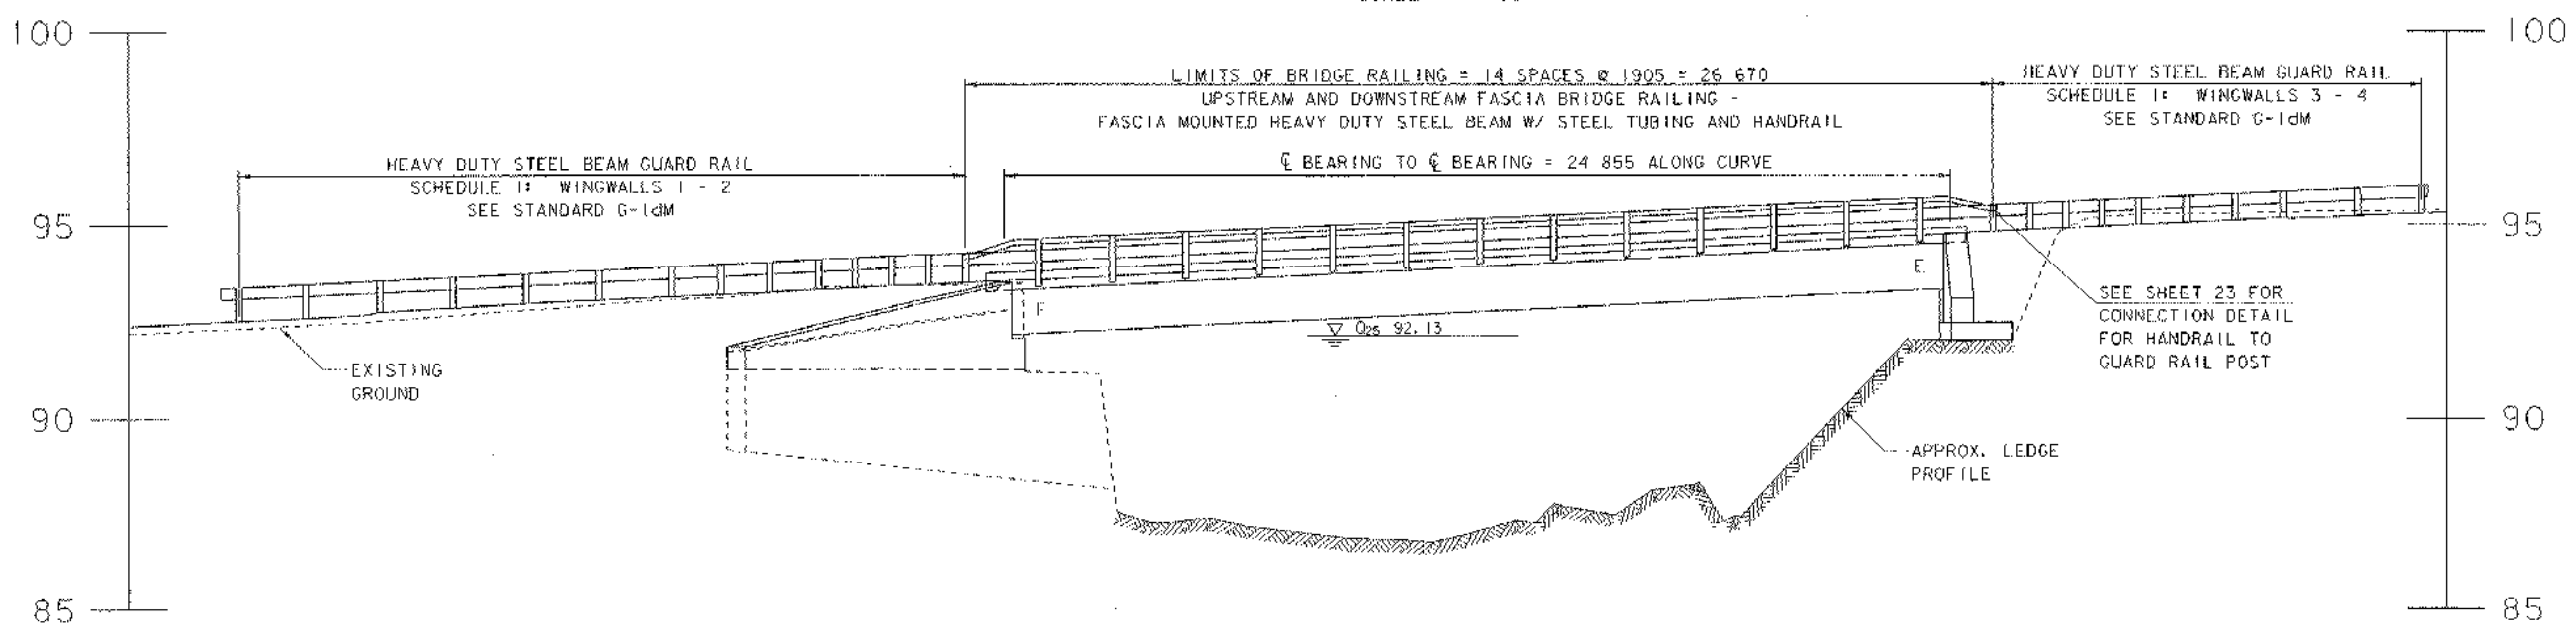


PLAN

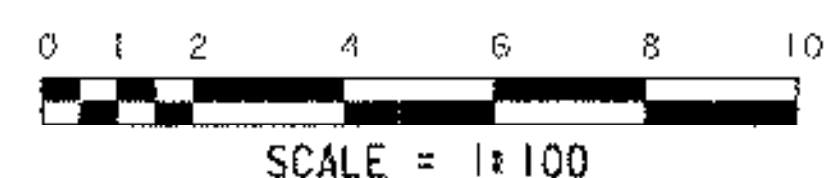

ELEVATION

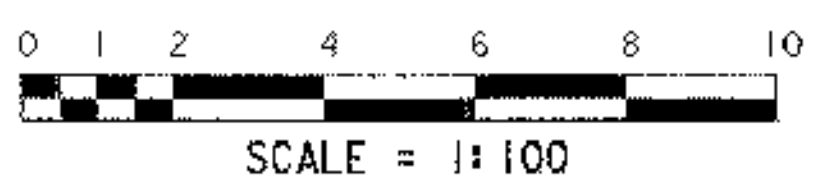

SHEET NAME: PLAN AND ELEVATION SHEET	
PROJECT NAME: FAIR HAVEN-HAMPTON	HIGHWAY NO.: TH 6
PROJECT NUMBER: BRO 1443(32)	BRIDGE NO.: 6
	OVER: POULTNEY RIVER
FILE NAME: /str/931021/sj02pe.dgn	PLOT DATE: 28-JAN-2003
PROJECT MANAGER: G.S. ROGERS	DRAWN BY: STR
DESIGNED BY: C. MELINER	IPARM NAME: s102pe.f
BRIDGE SHEET NUMBER:	SHEET 16 OF 53