




**WINGWALL NO. 2**  
SCALE 1/25

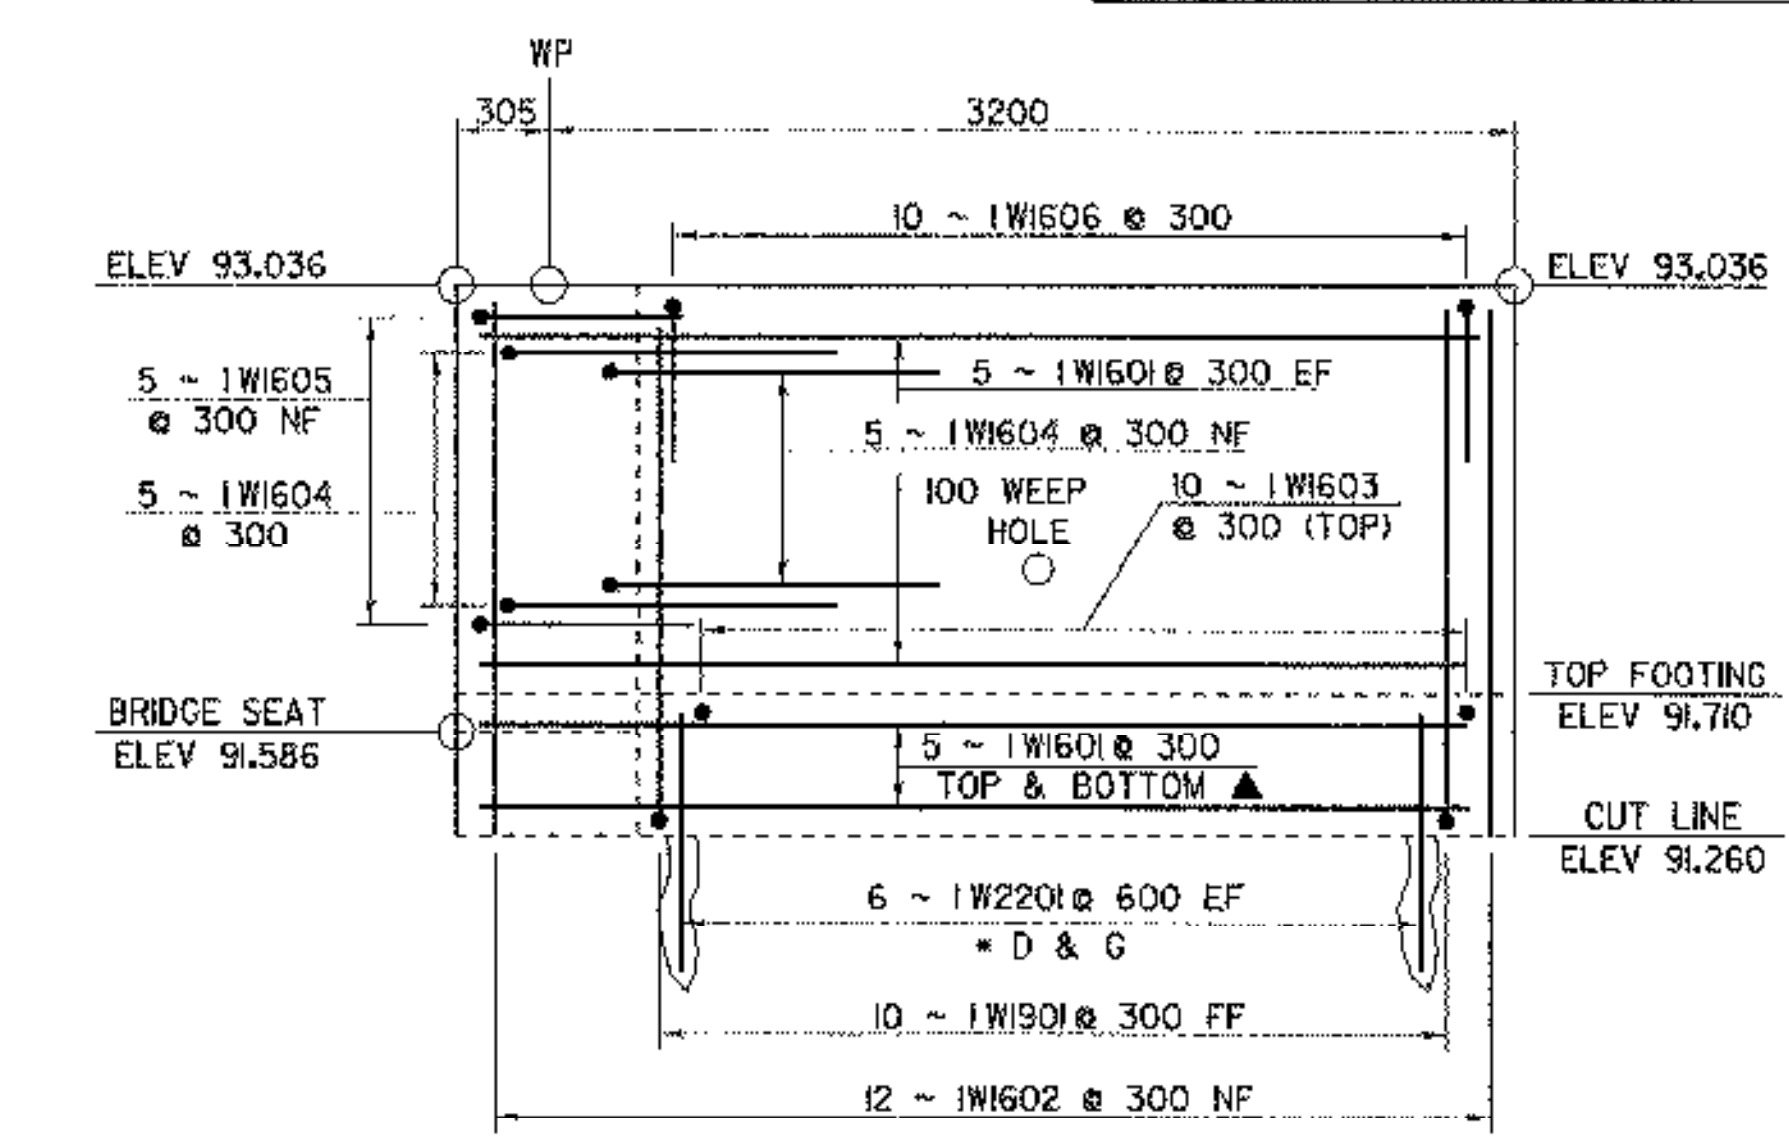


**WINGWALL NO. 1**  
SCALE 1/25

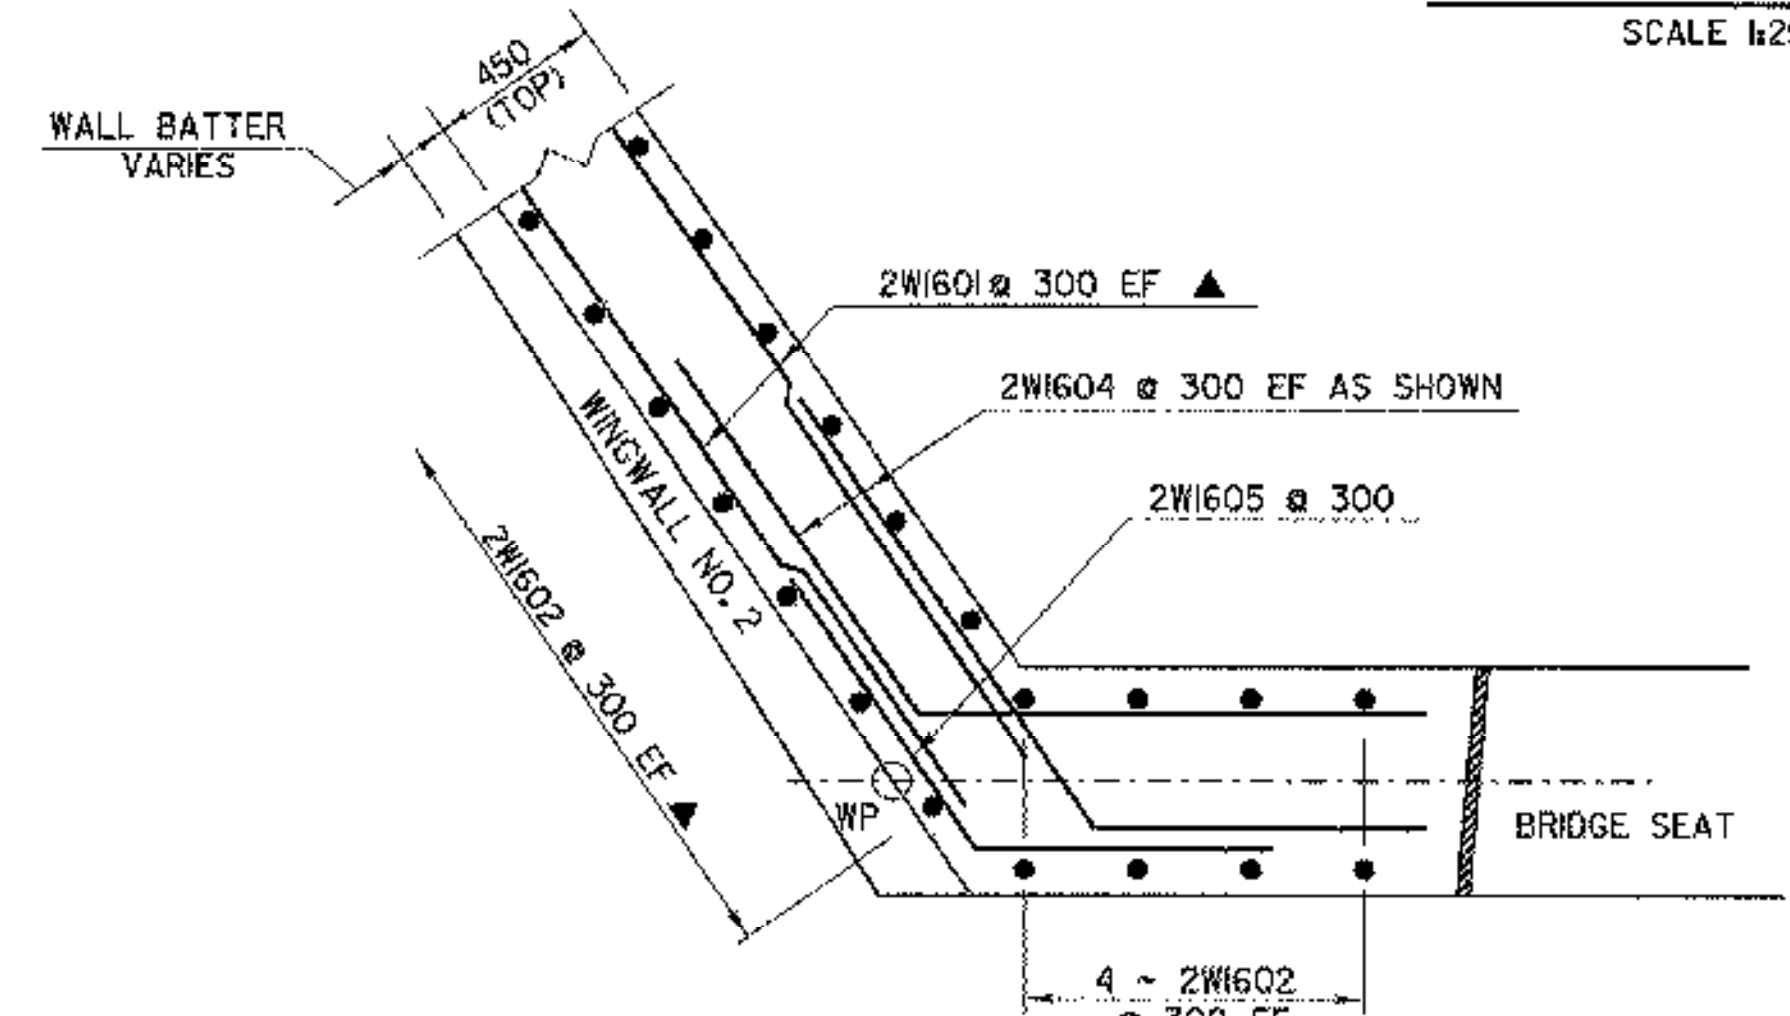


**CORNER DETAIL WINGWALL NO. 2 (ABOVE BRIDGE SEAT)**  
SCALE 1/20

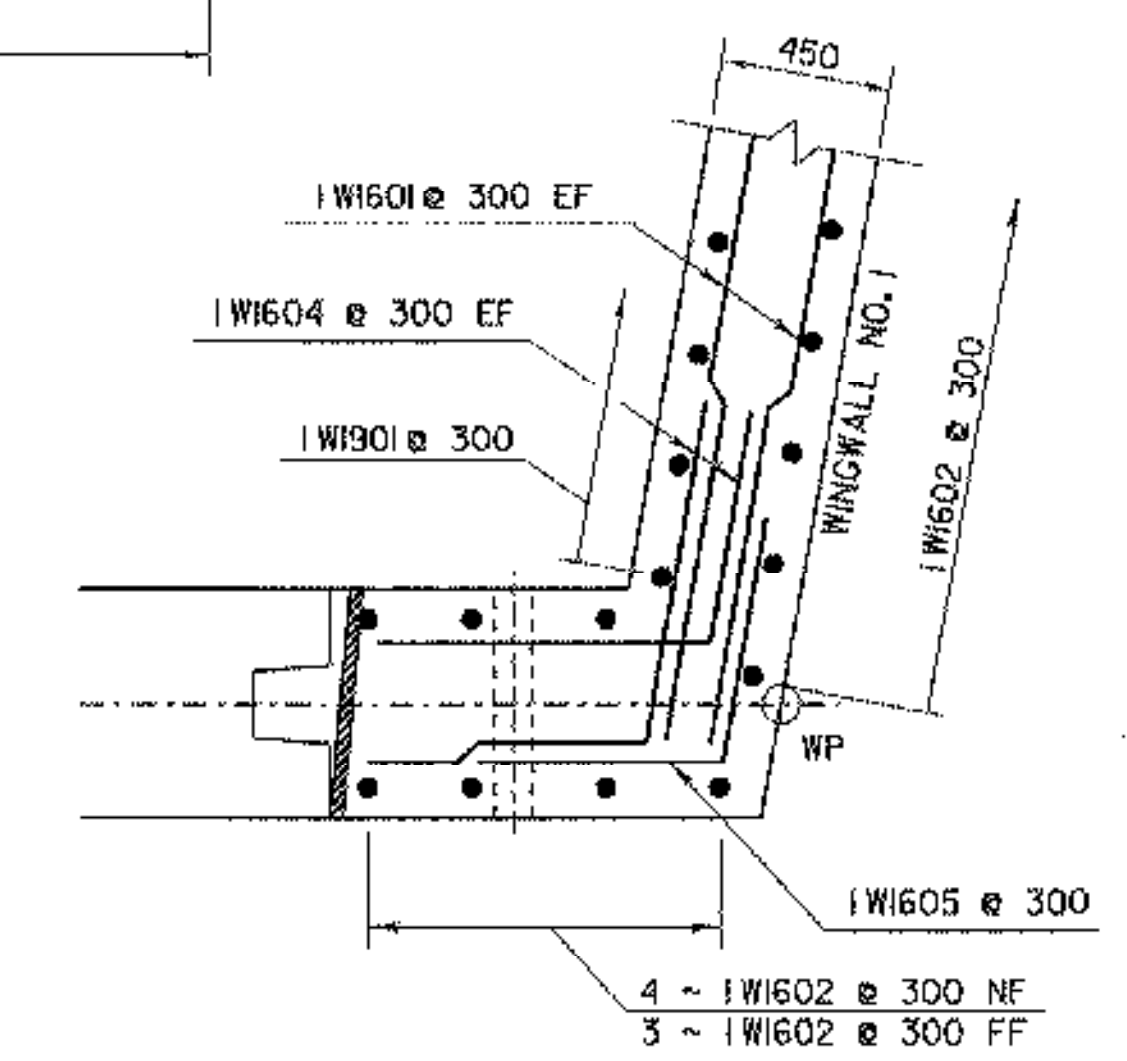


**CORNER DETAIL WINGWALL NO. 1**  
SCALE 1/20

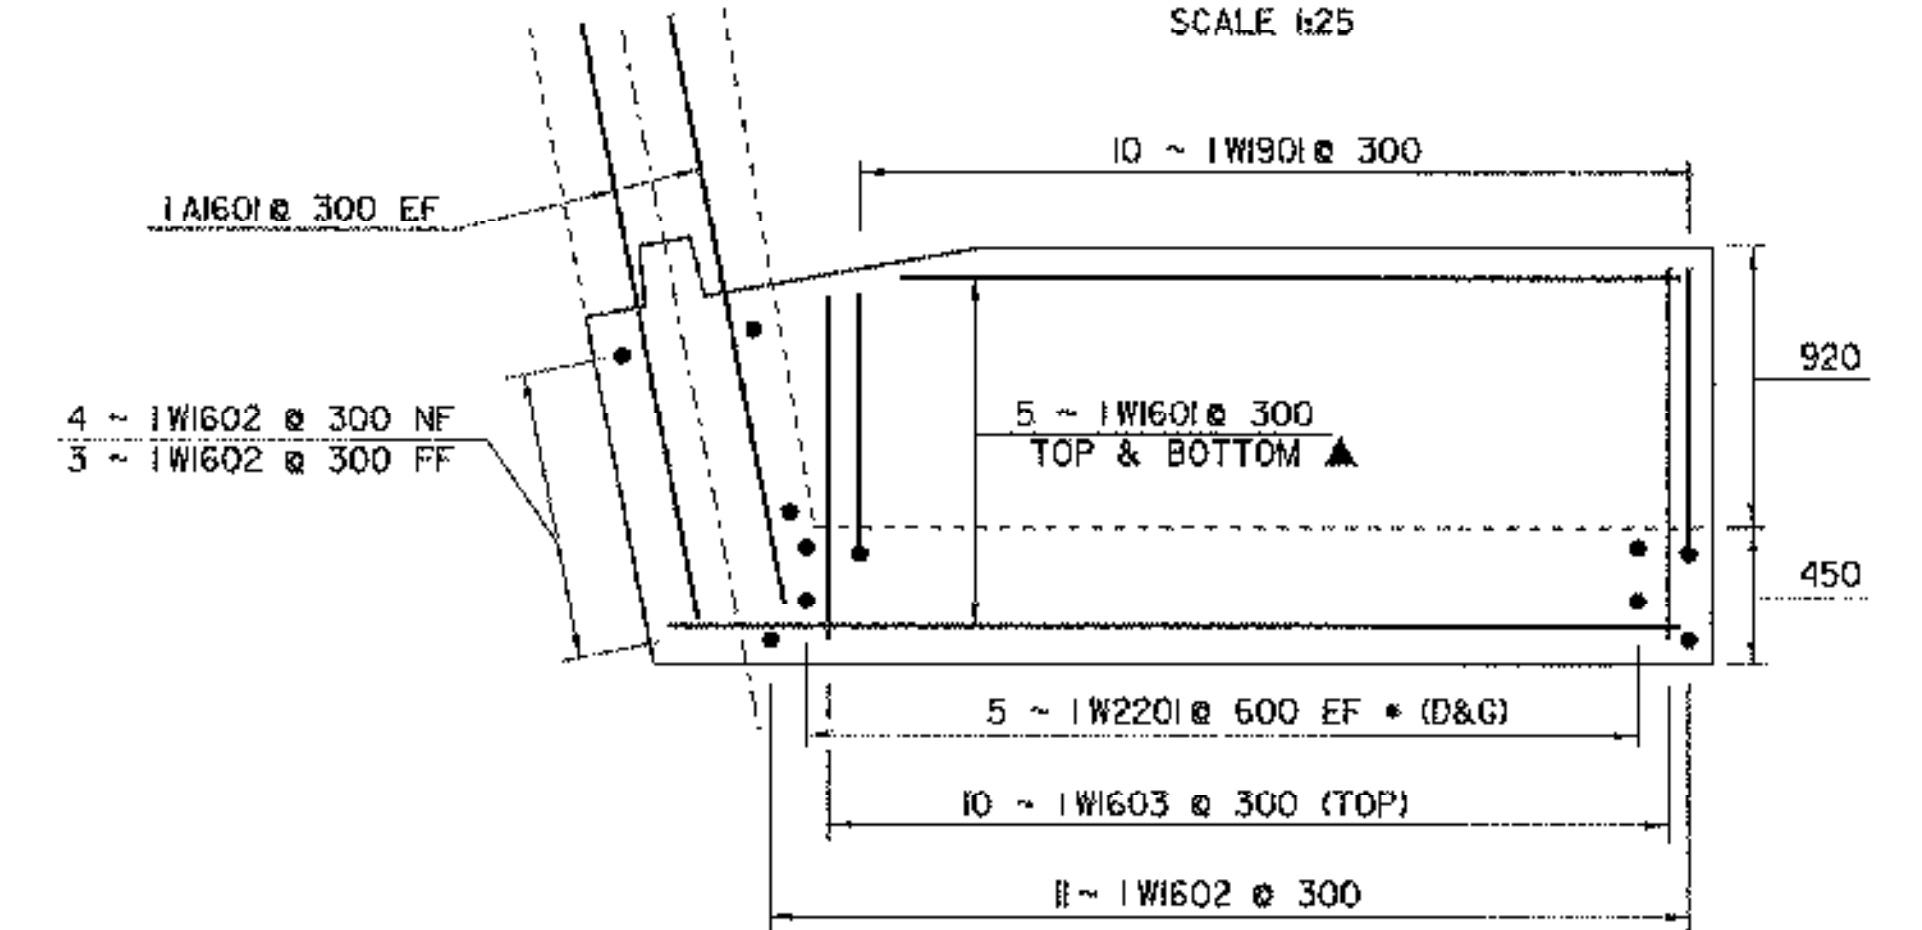


**WINGWALL NO. 1 FOOTING**  
SCALE 1/25

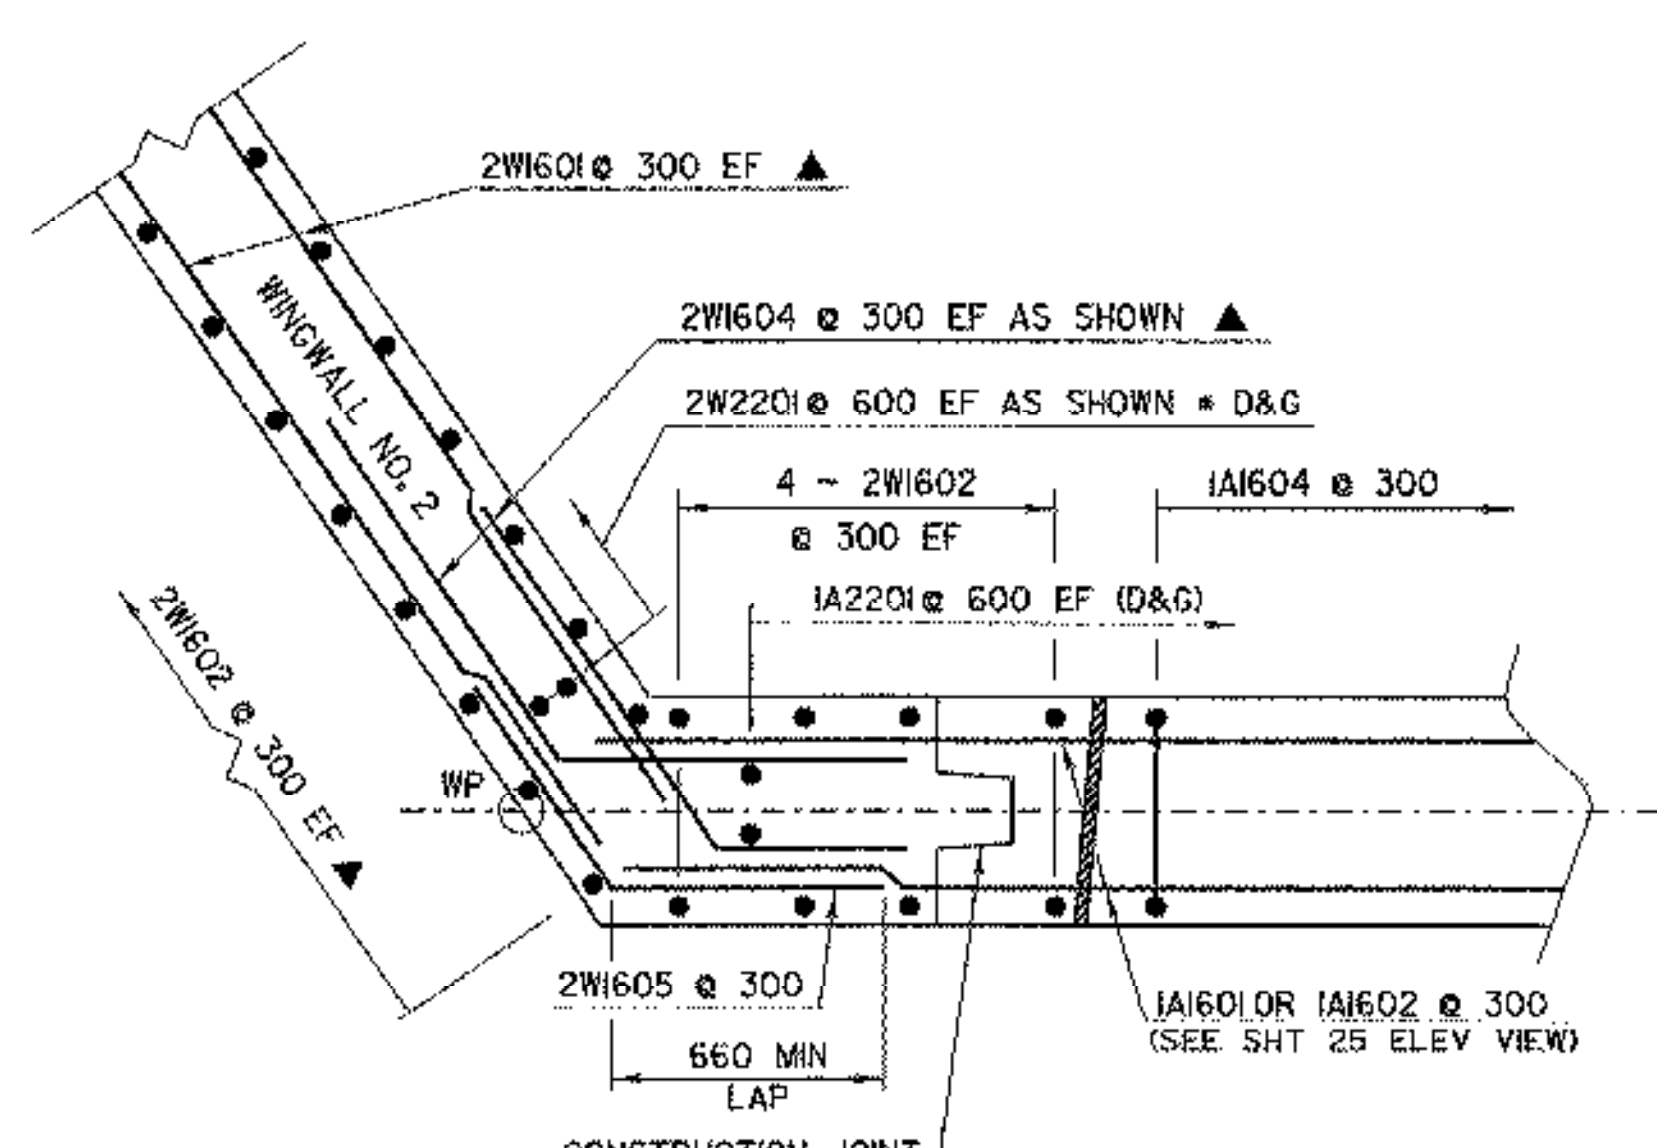


**CORNER DETAIL WINGWALL NO. 2 (BELOW BRIDGE SEAT)**  
SCALE 1/20

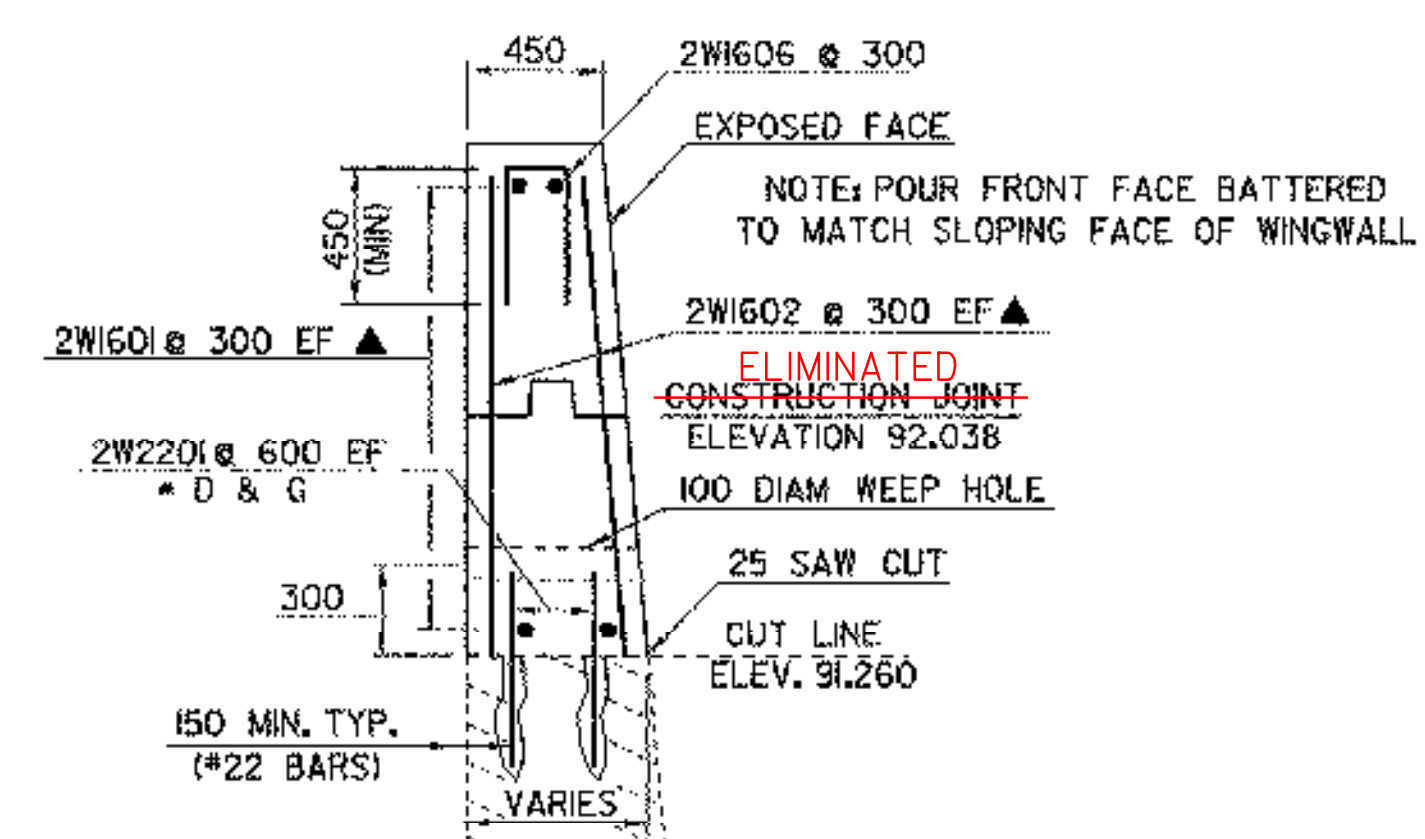


**WINGWALL NO. 2 SECTION A-A**  
SCALE 1/25

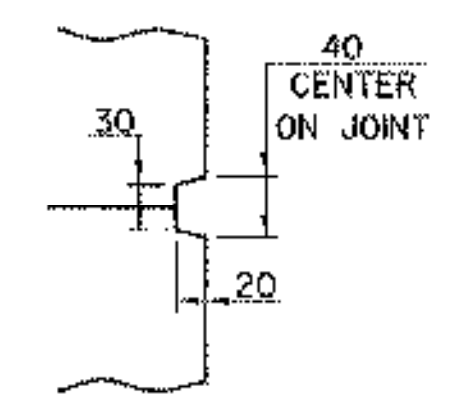


**SCORE MARK DETAIL**  
(NTS)

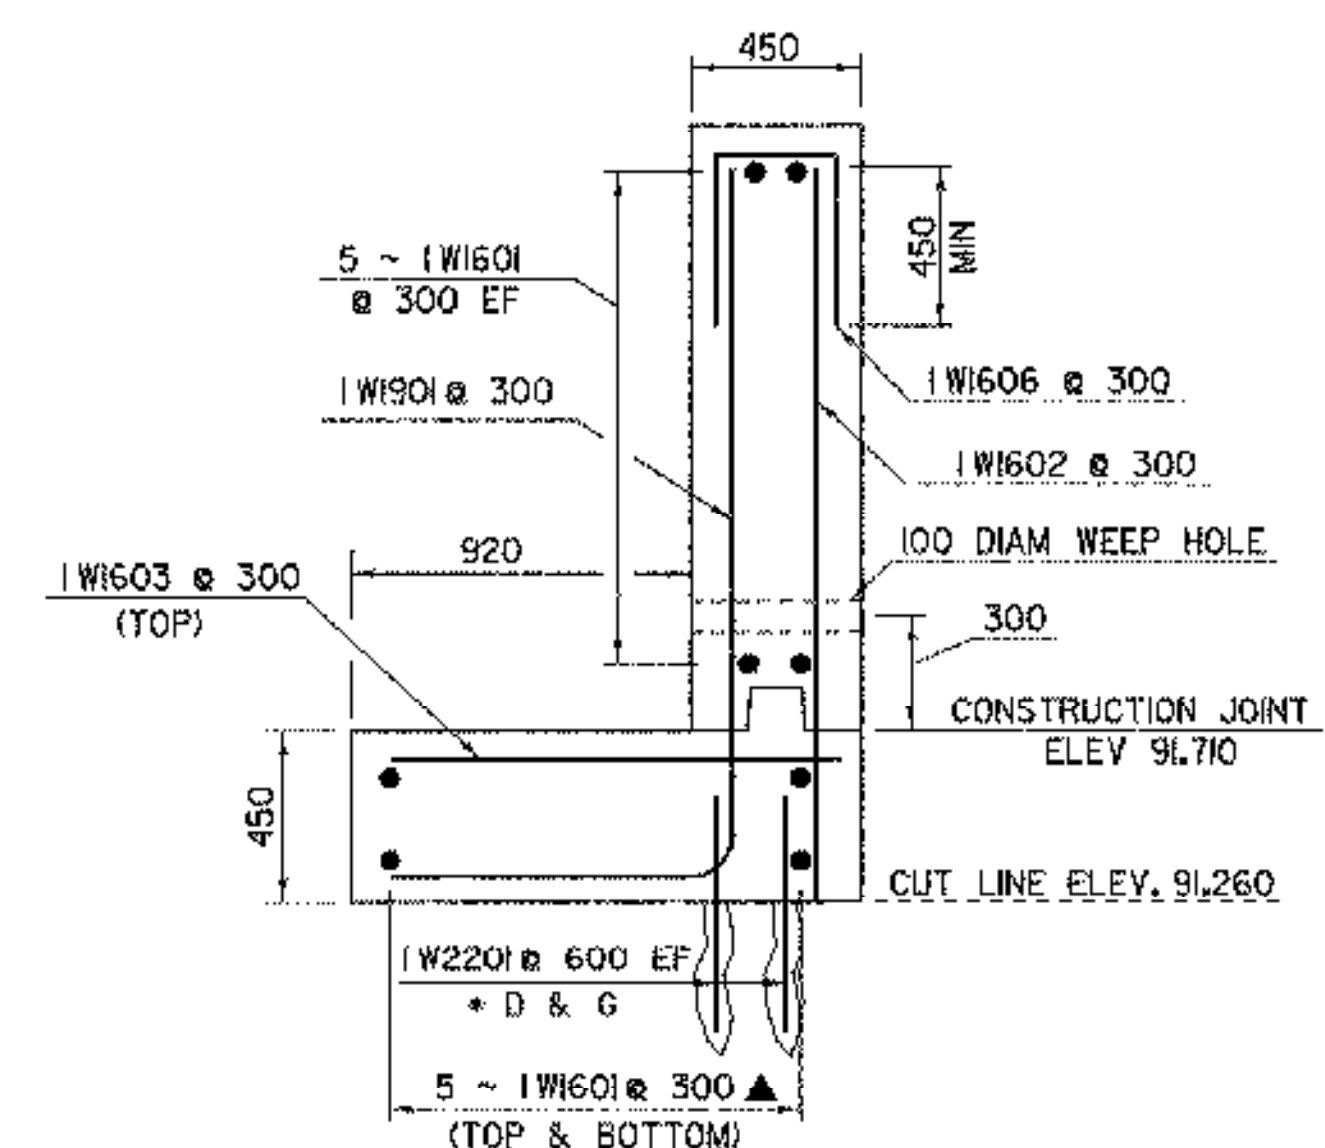

**WINGWALL NO. 1 TYPICAL SECTION**  
SCALE 1/20

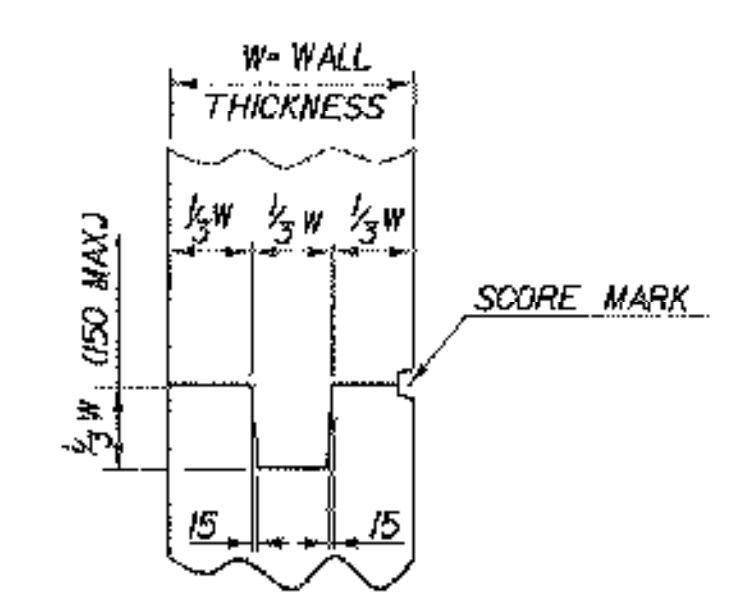

**TYPICAL CONCRETE CONSTRUCTION JOINT**  
(NTS)

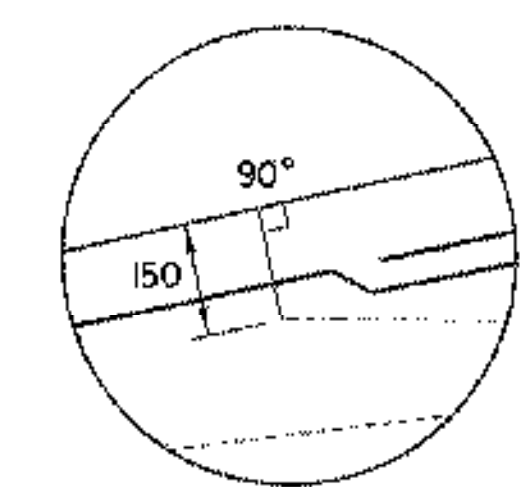

**DETAIL "A"**  
(NTS)

**NOTES:**  
NF = NEAR FACE  
FF = FAR FACE  
EF = EACH FACE  
▲ = CUT TO FIT IN FIELD  
60 CLEAR UNLESS OTHERWISE SPECIFIED ON THE PLANS  
\* DRILL & GROUT DOWELS AS SHOWN, 450 MINIMUM DEPTH OF GROUTING

SHEET NAME: <b>WINGWALLS 1 &amp; 2 DETAILS</b>	
PROJECT NAME: <b>FAIR HAVEN-HAMPTON</b>	HIGHWAY NO.: TH 6
PROJECT NUMBER: <b>BRO 1443(32)</b>	BRIDGE NO.: 6
	OVER: <b>POULTNEY RIVER</b>
FILE NAME: /s1/93j021/ej021sub2.dgn	PLOT DATE: 23-MAR-2005
PROJECT MANAGER: <b>G.S. ROGERS</b>	DRAWN BY: <b>D. BONNEAU</b>
DESIGNED BY: <b>C. MEUNIER</b>	IPARM NAME: ej021ord.1
BRIDGE SHEET NUMBER:	SHEET 26 OF 53