

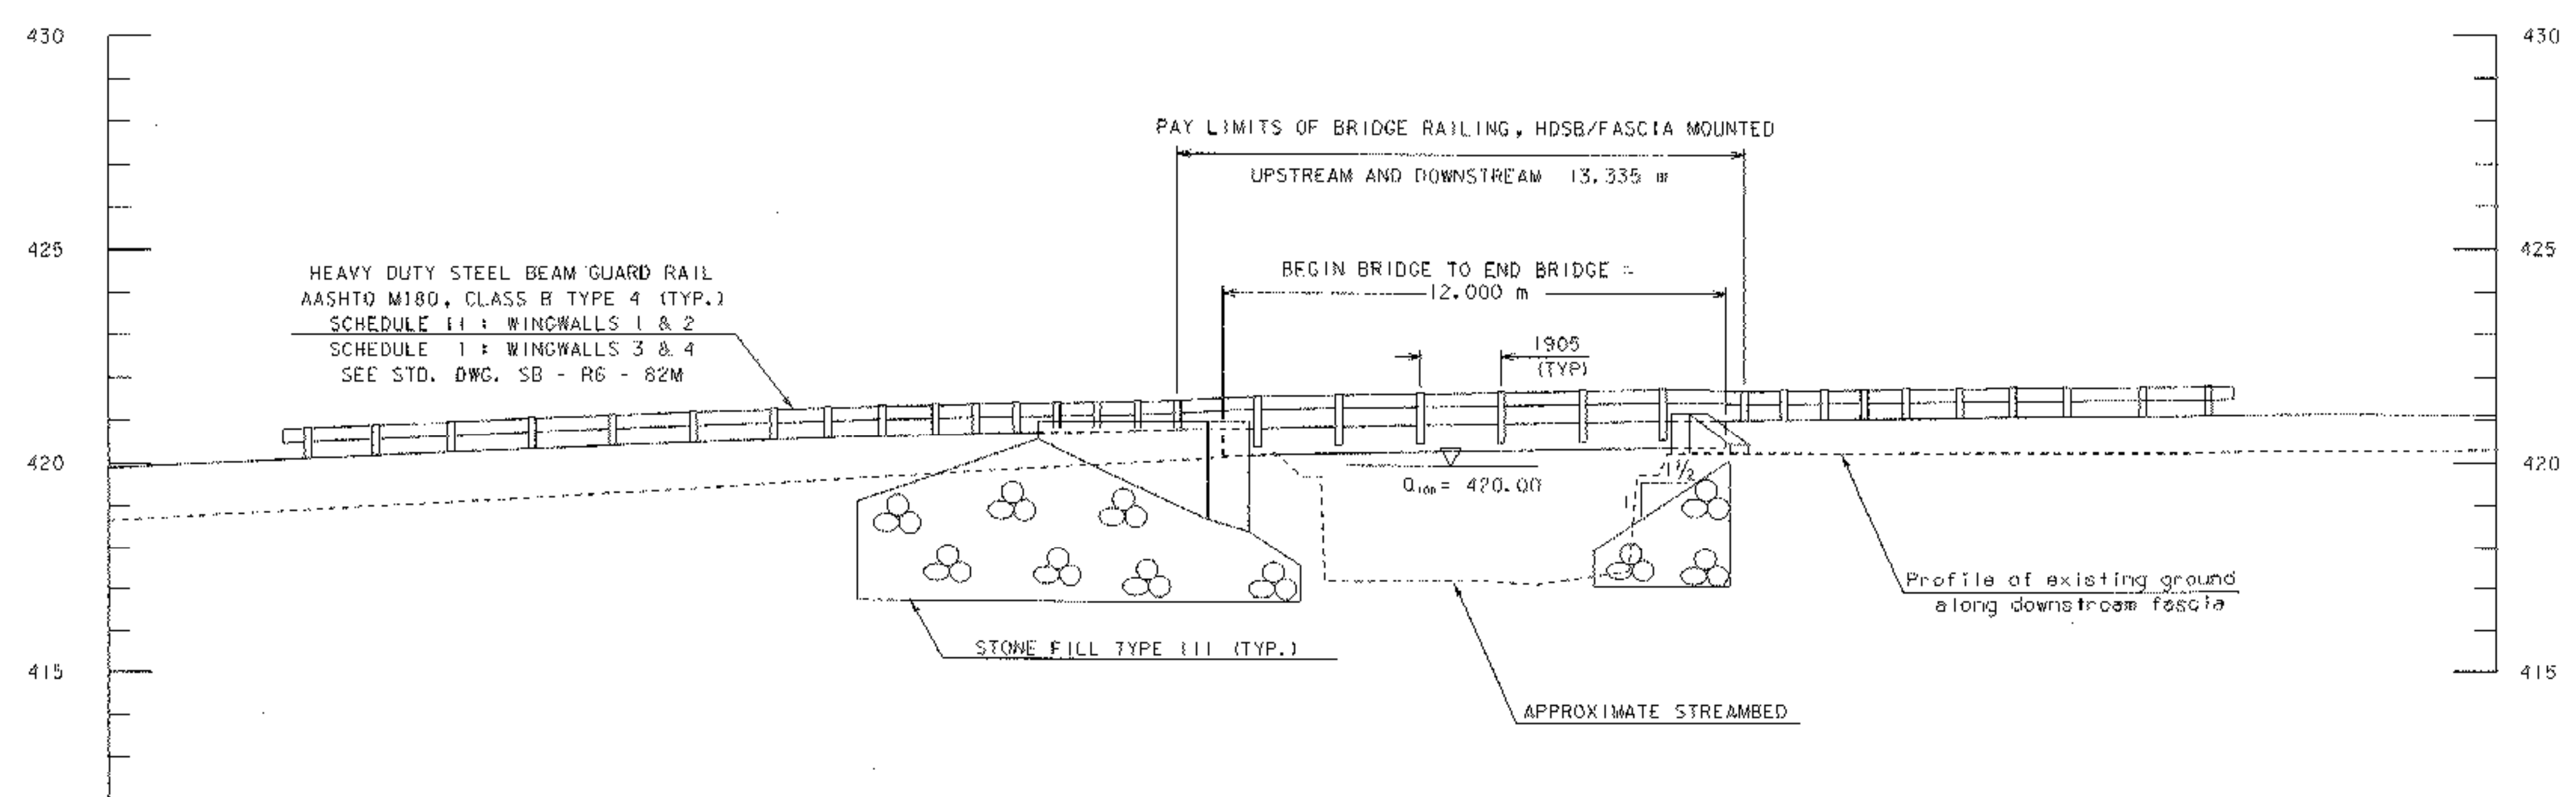
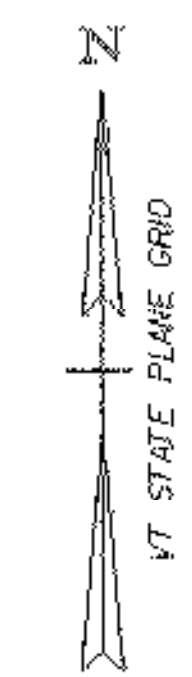


PLAN

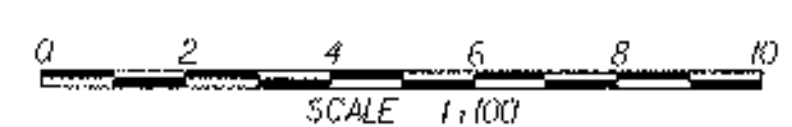

ELEVATION AT DOWNSTREAM FASCIA LOOKING UPSTREAM

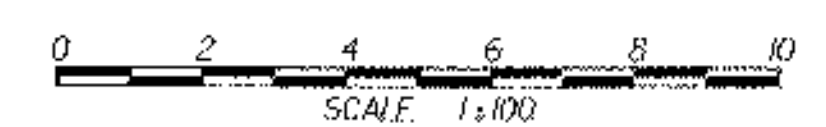

PROJECT: MENDON	PROJECT NO.: BRO 1443 (28)
DESIGN FILE NAME: /USR/STR/93J022/SJ022PE.DGN	PLOT DATE: 5-JUN-1998
IPARM FILE NAME: SJ022PEJ	
PLAN AND ELEVATION SHEET	SHEET: 18 OF 66