



**SUBBASE TRANSITION
AT BEGIN APPROACH**
NTS

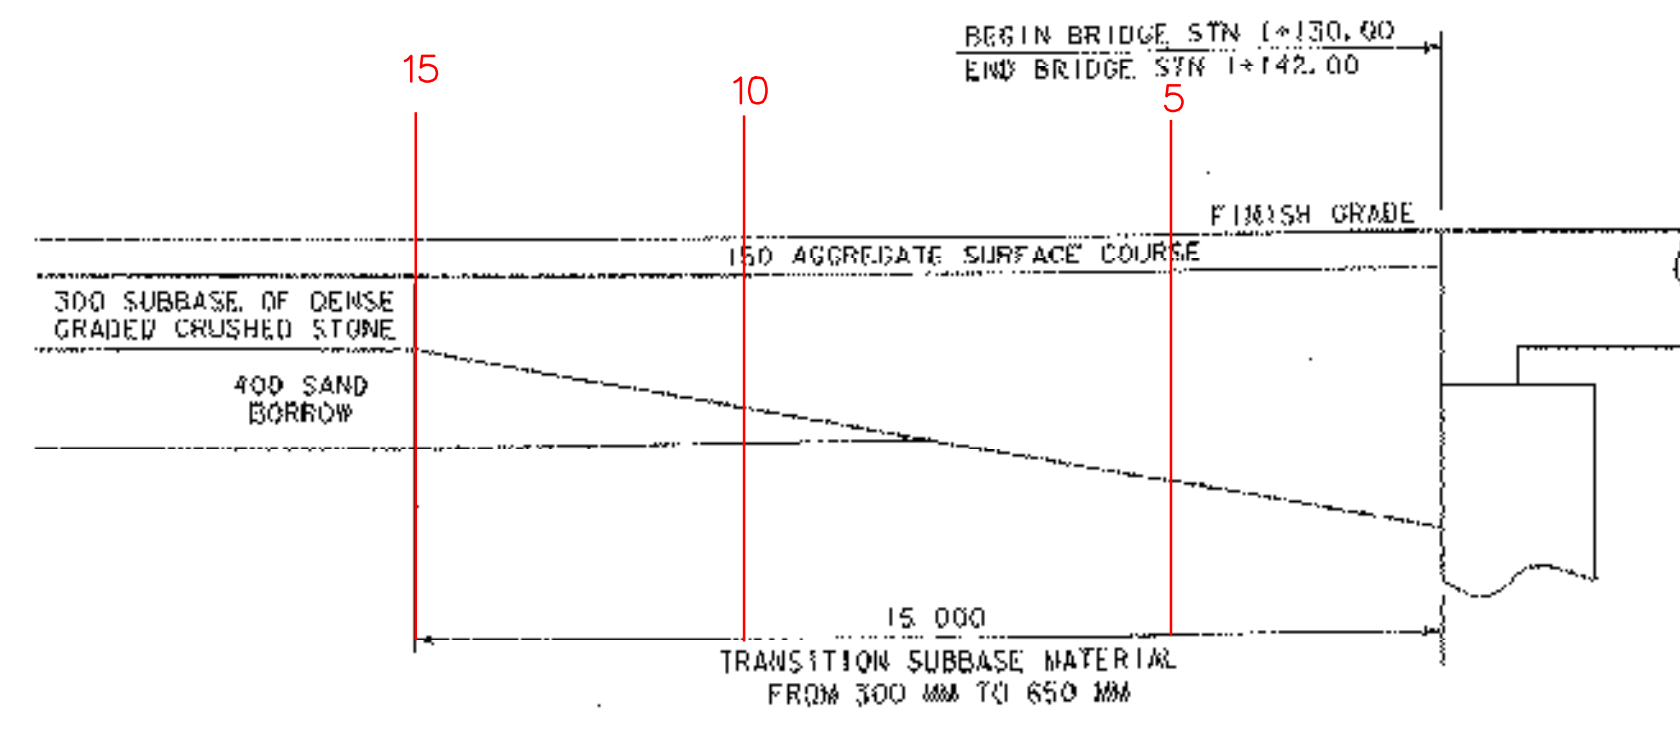

**MATERIAL TRANSITION
AT BEGIN/END BRIDGE #20**
NTS

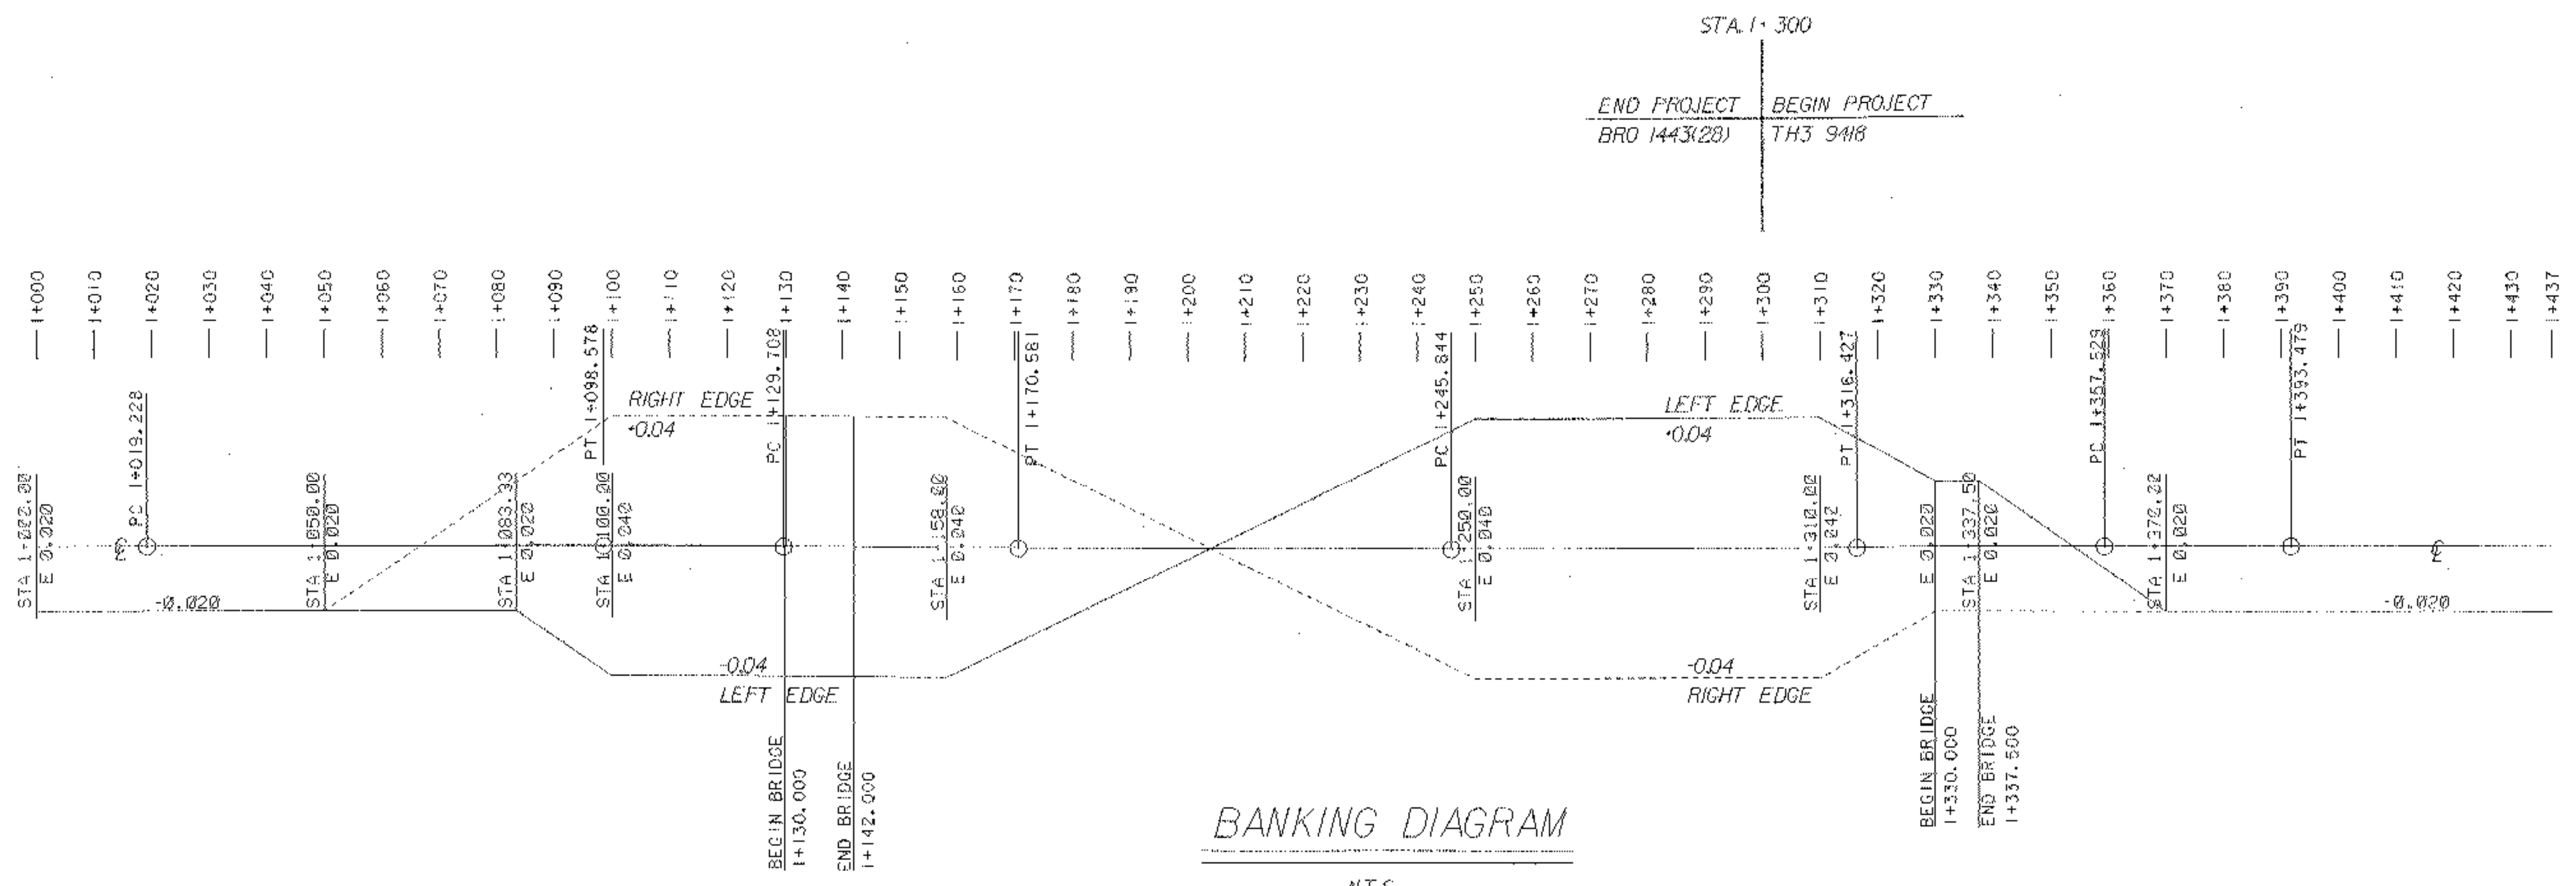

BANKING DIAGRAM
NTS

PROJECT: MENDON	PROJECT NO. & BRO 1443(28) & TH 3 9418
DESIGN FILE NAME: /USR/STR/93J022/SJ022XSI.DGN (PARM FILE NAME: SJ022BAN)	PLOT DATE: 5-JUN-1998
BANKING AND TRANSITION DIAGRAMS	
SHEET: 27 OF 66	