
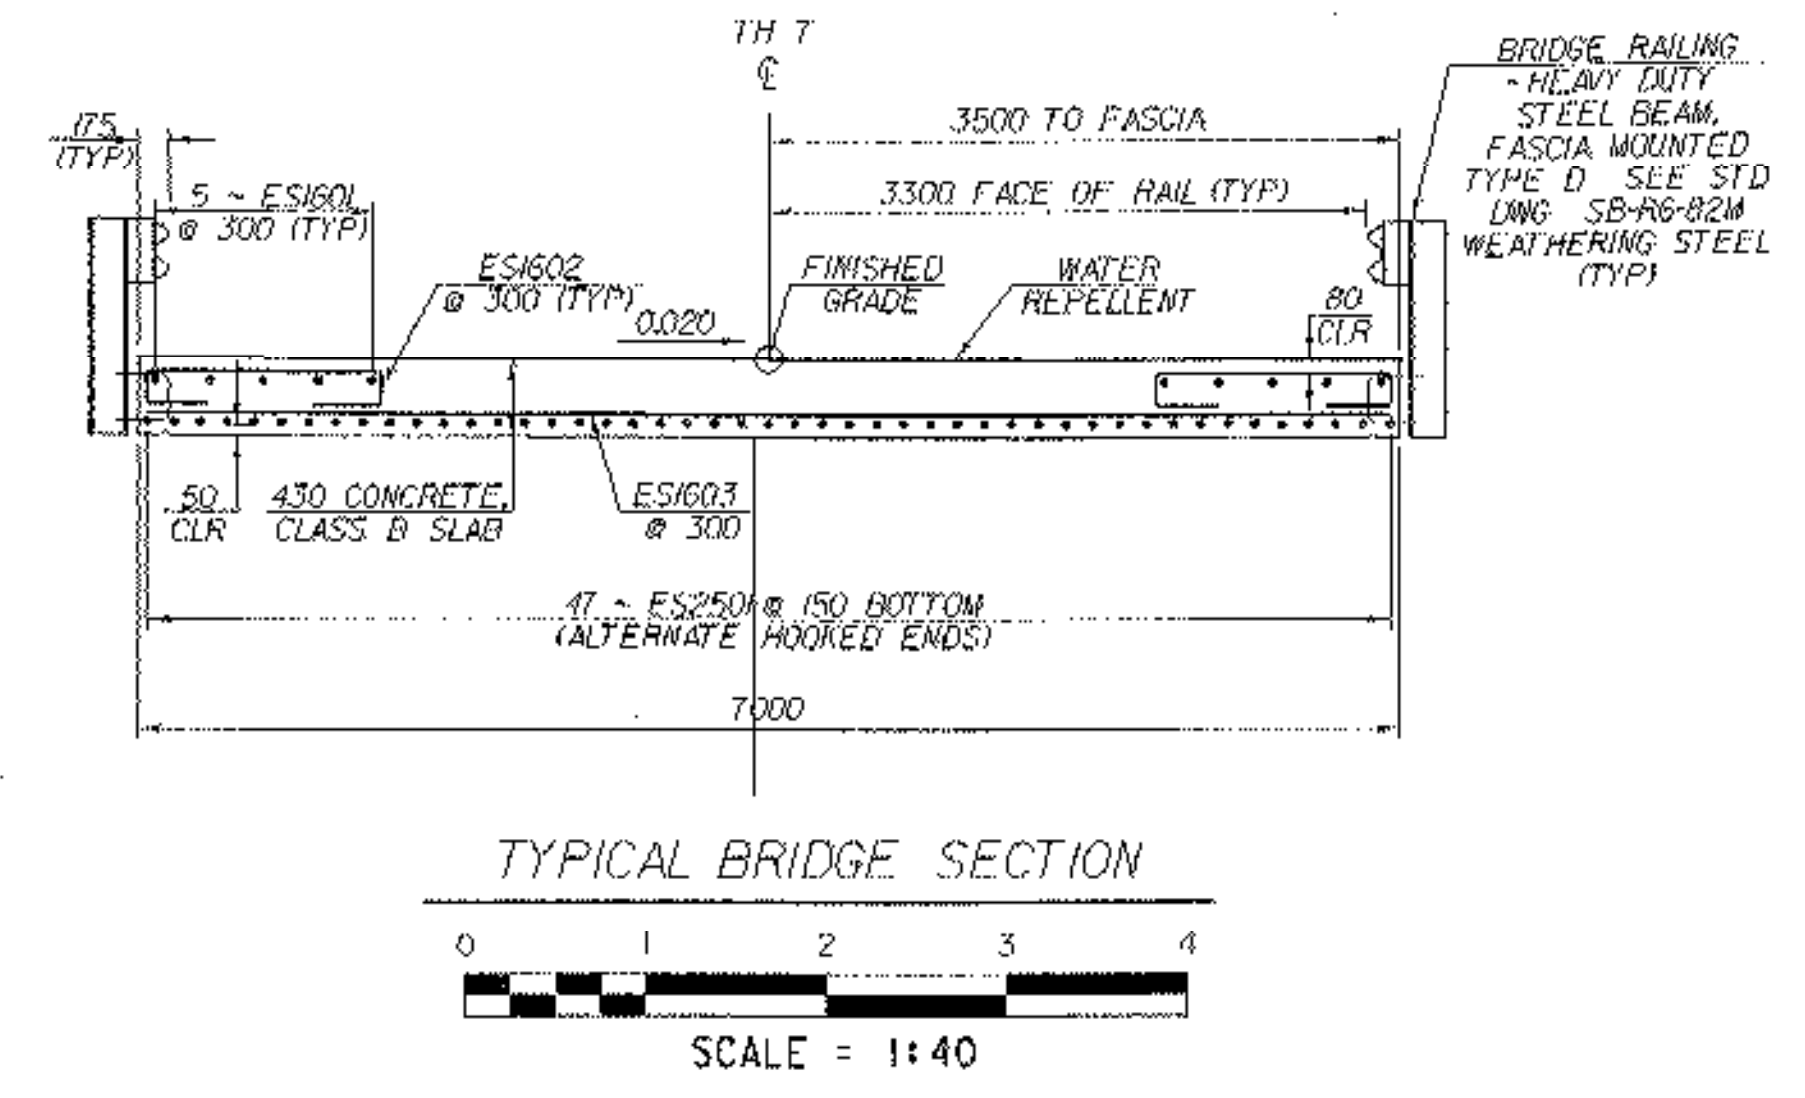


VOID: PRECAST

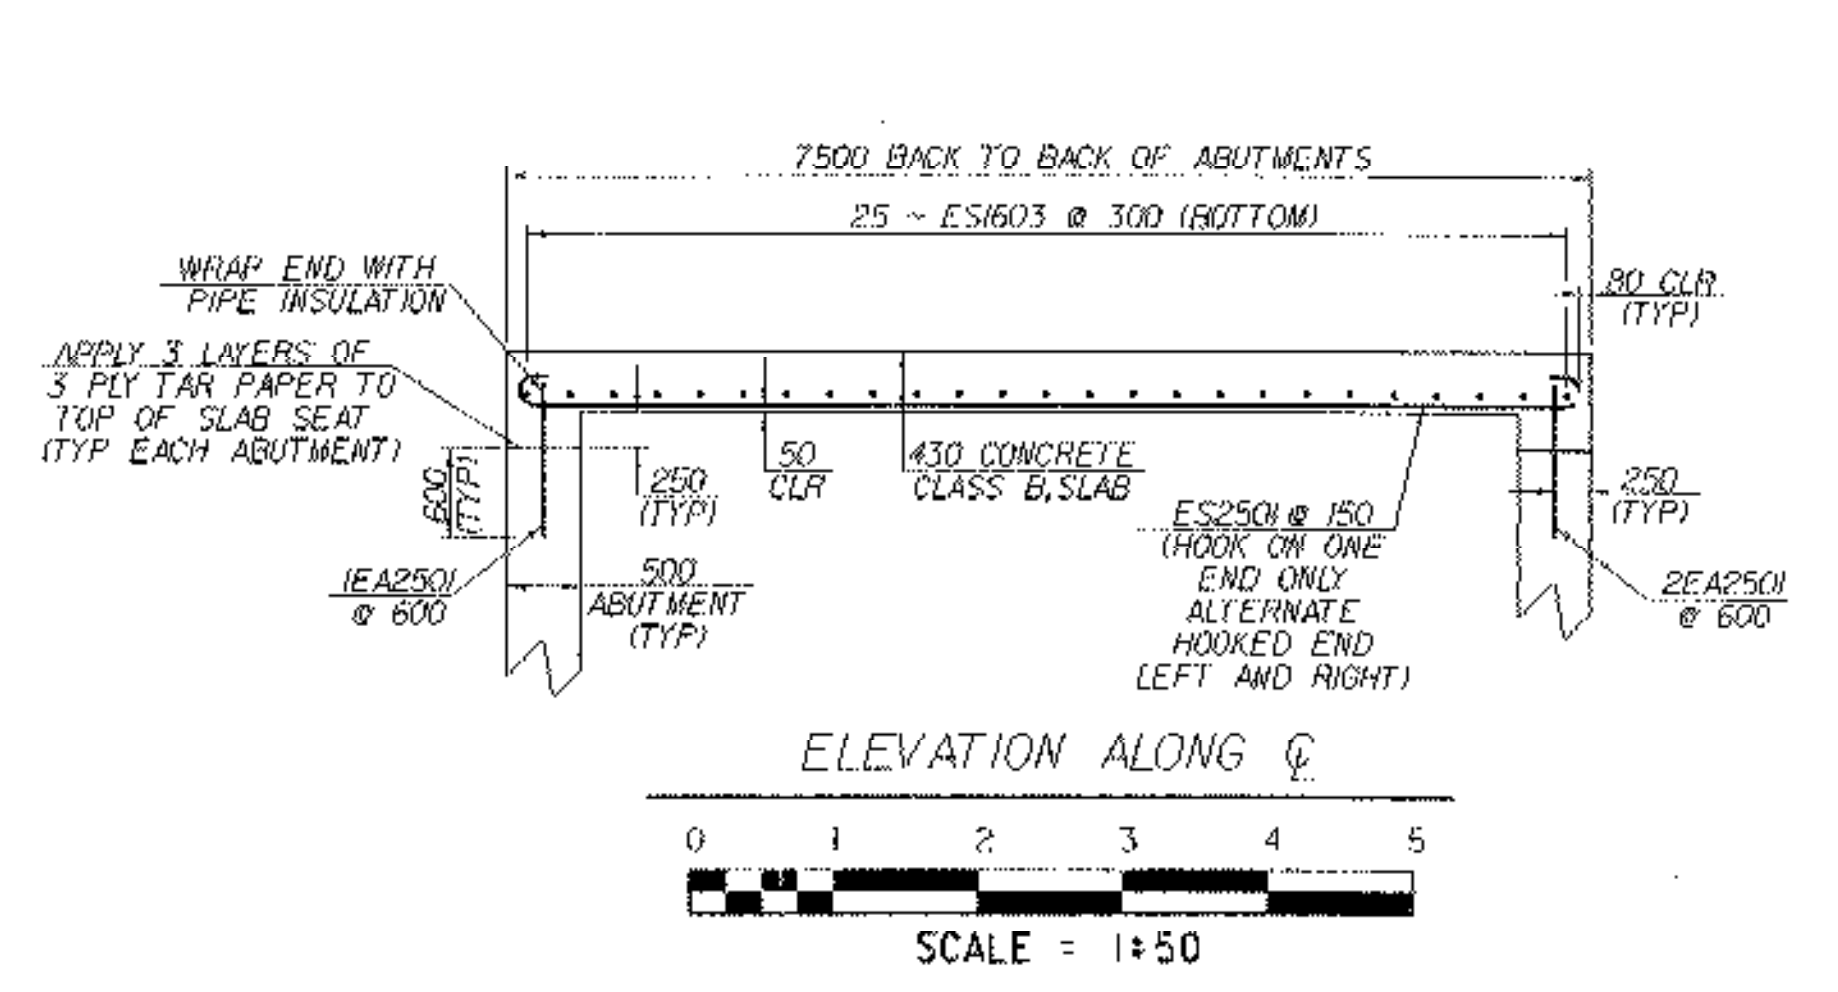

<b>STATE OF VERMONT AGENCY OF TRANSPORTATION</b>	
Town Of	MENDON
Bridge No.	14
Highway No.	T.H.7
Log Sta.	
Surv. Sta.	
<b>T.H.7 OVER BREWERS BROOK</b>	
<b>SLAB DETAIL SHEET</b>	
Designed By	M.EVANS-MONGEON
Drawn By	R.H.PELLETT
Checked By	Date
M.EVANS-MONGEON	4/98
C.KELLER	Date 4/98
PROJECT	MENDON
PROJECT NO.	TH 3 9418
L.G.C. Info. /str5/941086/s1086slb.dgn	
Bridge Sheet No.	Sheet 52 of 66