


- EXISTING STRUCTURE**
- BUILT IN 1919
 - 32' MAXIMUM SPAN
 - STEEL BEAM WITH TIMBER DECK
 - CONCRETE AND STONE ABUTMENTS
 - 13' ROADWAY WIDTH

EXISTING CONDITIONS

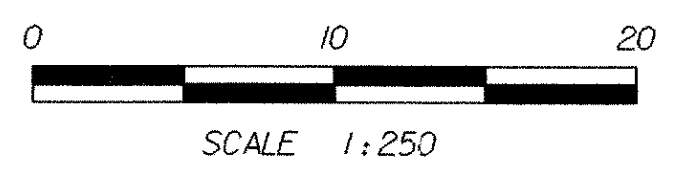

DATUM	
VERTICAL	NAVD 88
HORIZONTAL	NAD 83/92

PROJECT: VERSHIRE	PROJECT NO. : BRO 1444 (32)
DESIGN FILE NAME: pw93j027/sj027bdr_ero.dgn	PLOT DATE: 24-FEB-2006
IPARM FILE NAME: sj027excon.i	SURVEY DATE: 11/94
SURVEYED BY: R. GILMAN	DRAWN BY: M.FESSEL
SQUAD LEADER: C. P. WILLIAMS	SHEET: 24 OF 34
EXISTING CONDITIONS	