


APPROXIMATE AERIAL RELOCATION BY
WASHINGTON ELECTRIC COOPERATIVE
AND BELL ATLANTIC NEW ENGLAND



FINAL CONDITIONS

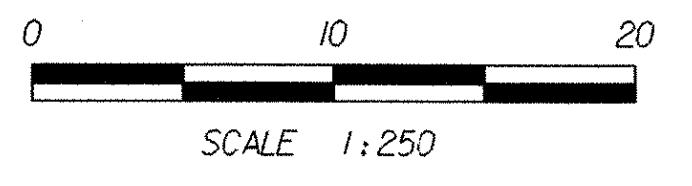

DATUM	
VERTICAL	NAVD 88
HORIZONTAL	NAD 83/92

PROJECT: VERSHIRE	PROJECT NO.: BRO 1444 (32)
DESIGN FILE NAME: pw93j027/sj027bdr_ero.dgn	PLOT DATE: 24-FEB-2006
IPARM FILE NAME: sj027fincon.i	SURVEY DATE: 11/94
SURVEYED BY: R. GILMAN	DRAWN BY: M.FESSEL
SQUAD LEADER: C. P. WILLIAMS	SHEET: 26 OF 34
FINAL CONDITIONS	