



I+050

END APPROACH  
STA I+045.000

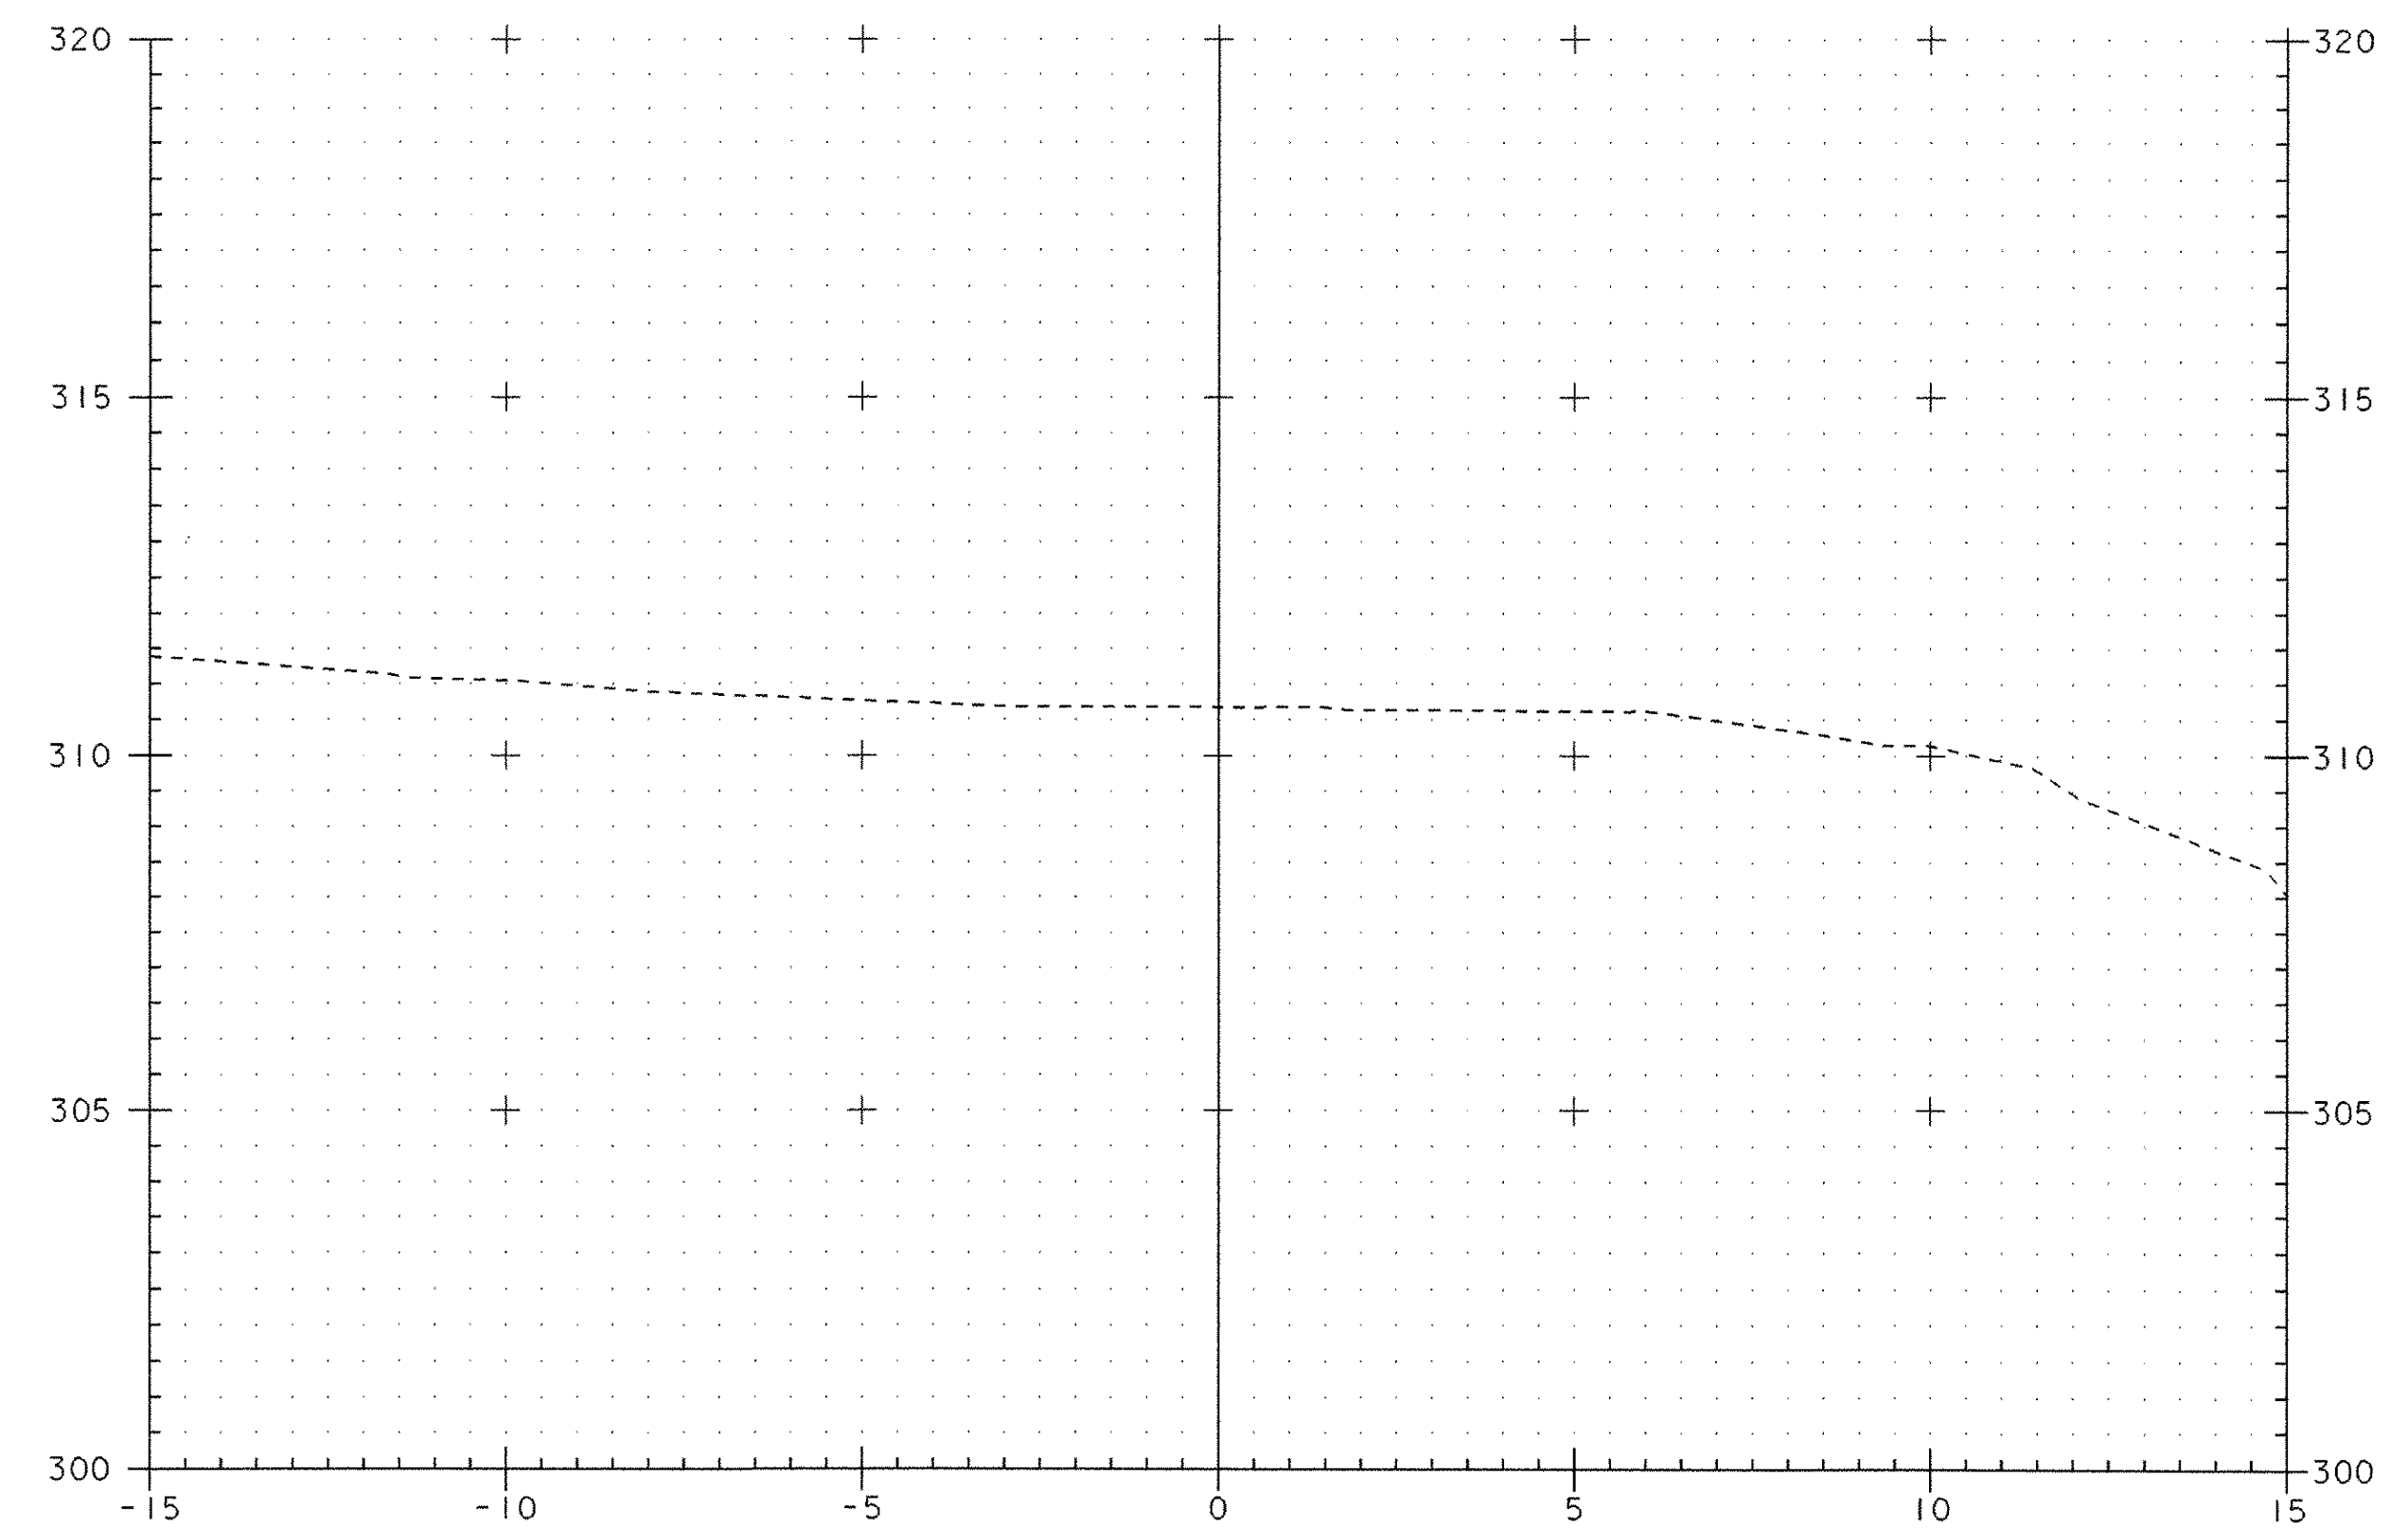


I+065

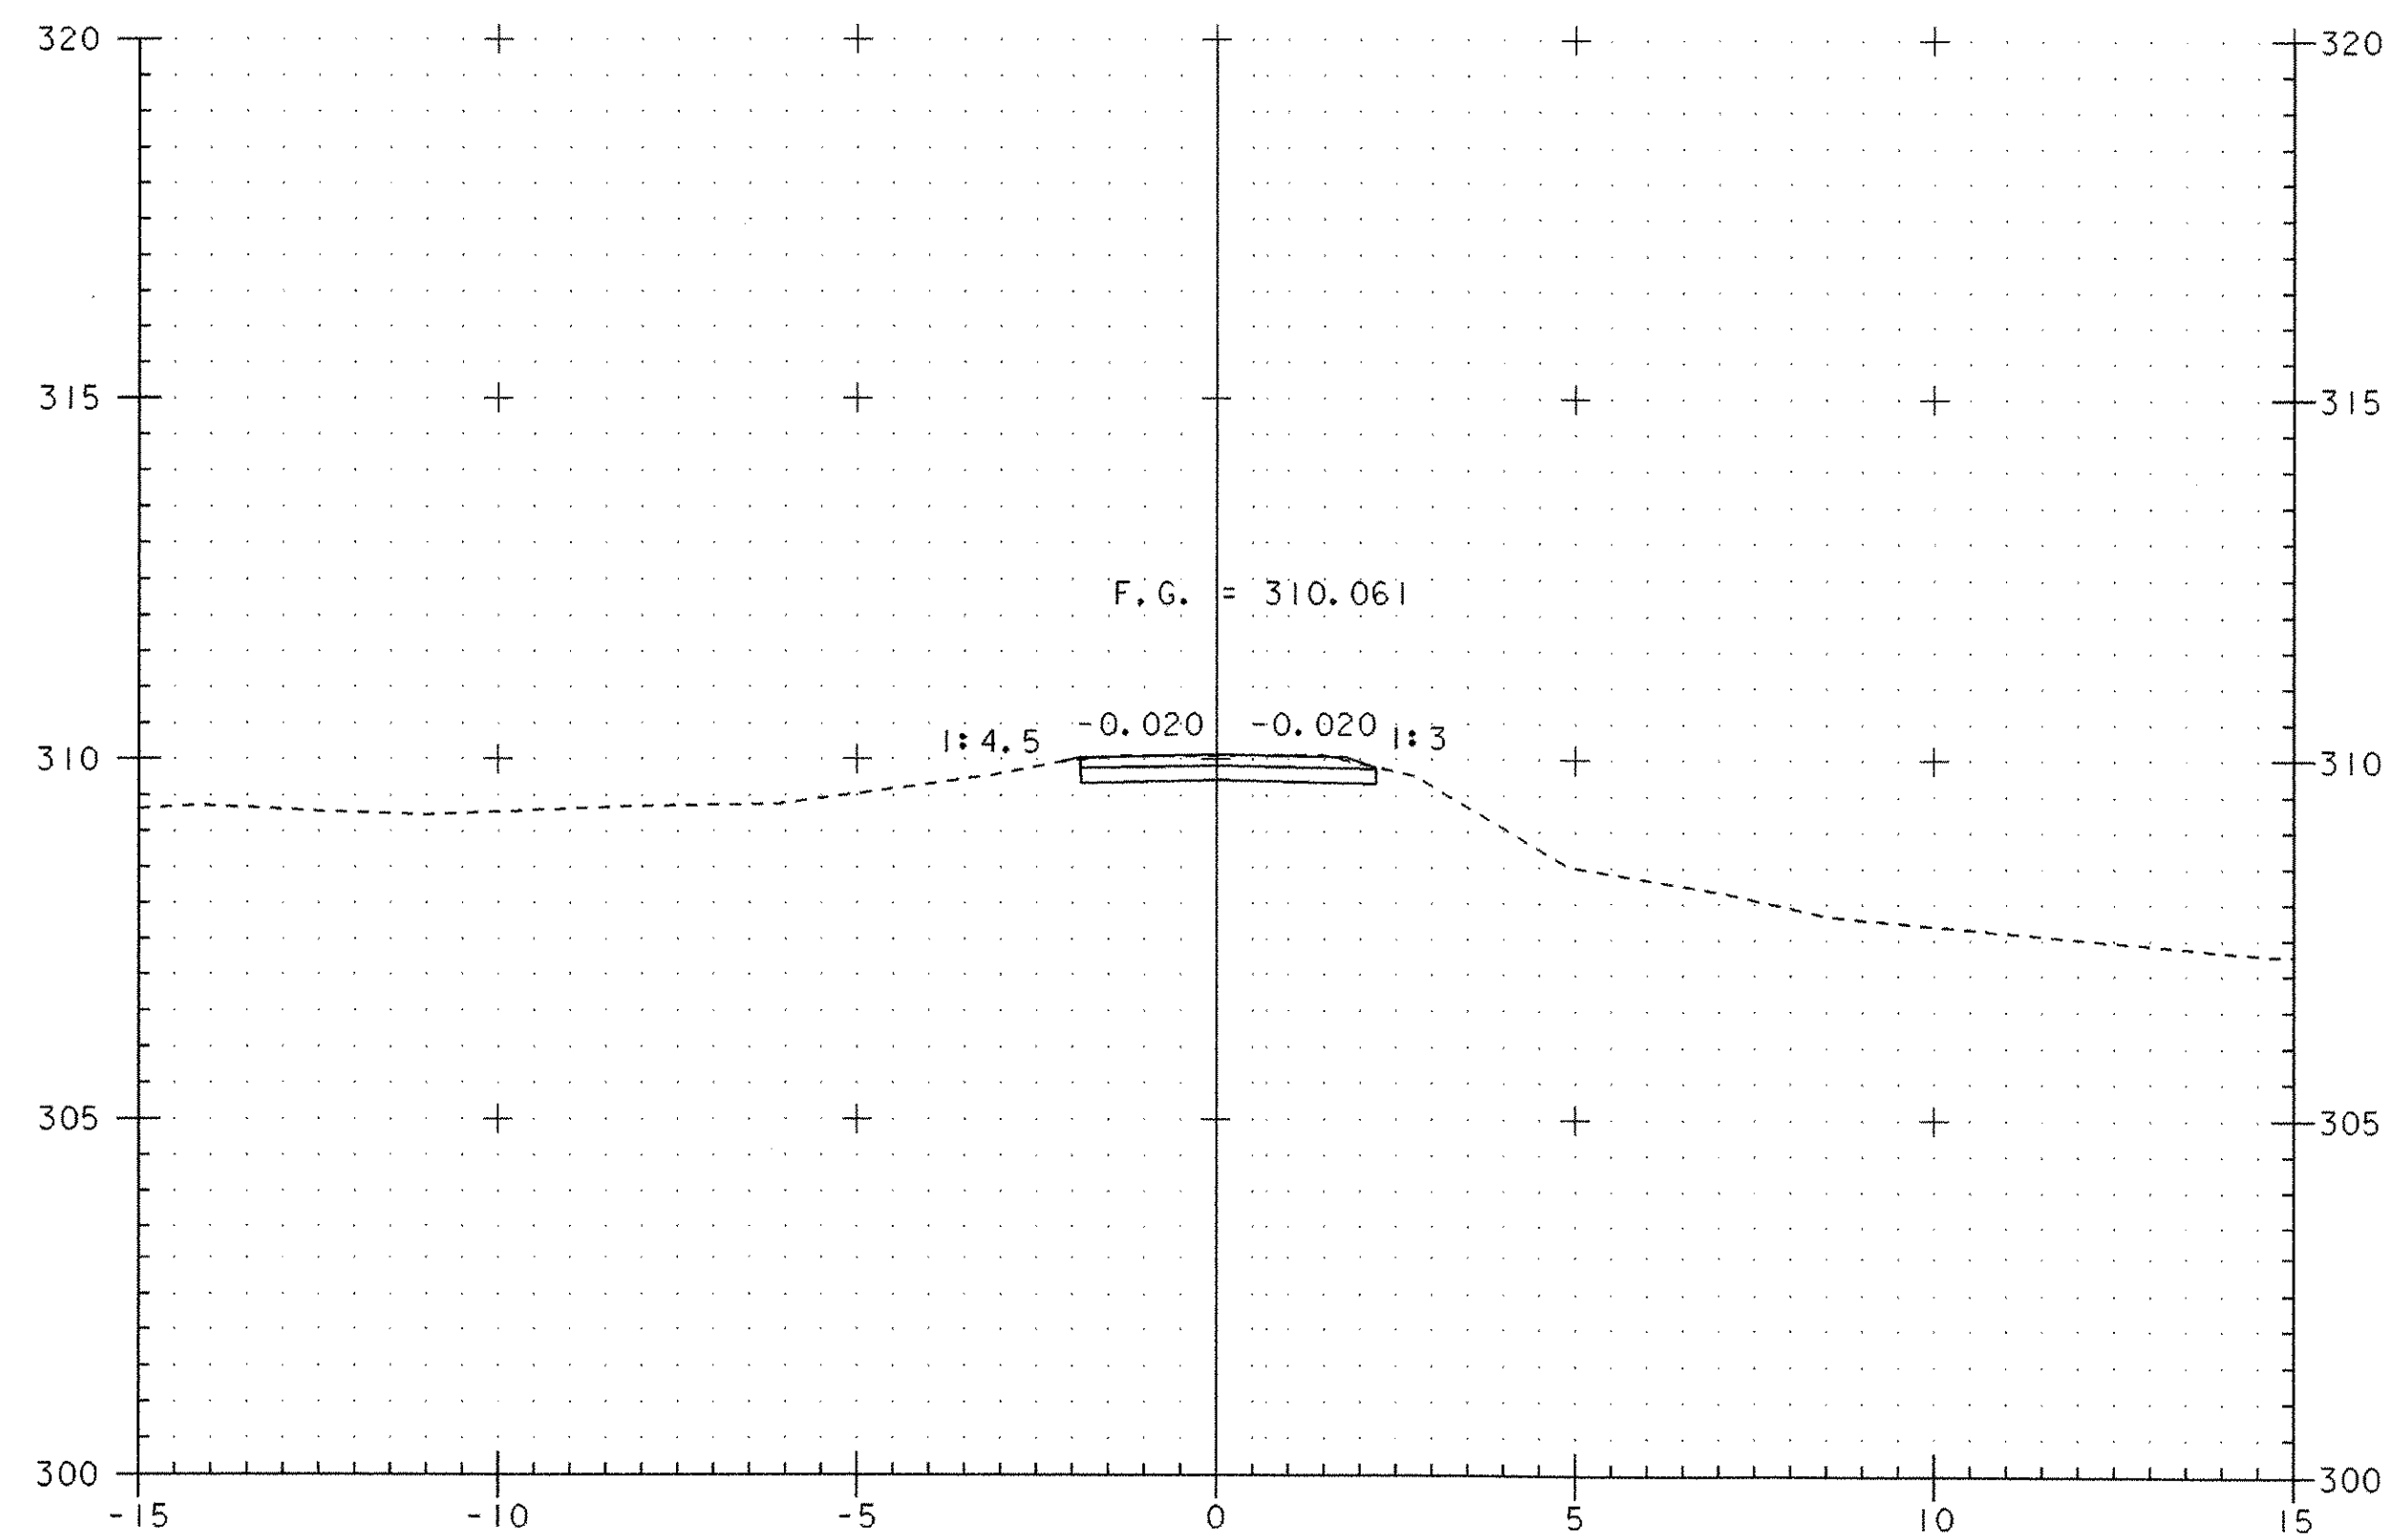

I+040

F.G. = 310.061

1:4.5 -0.020 -0.020 1:3

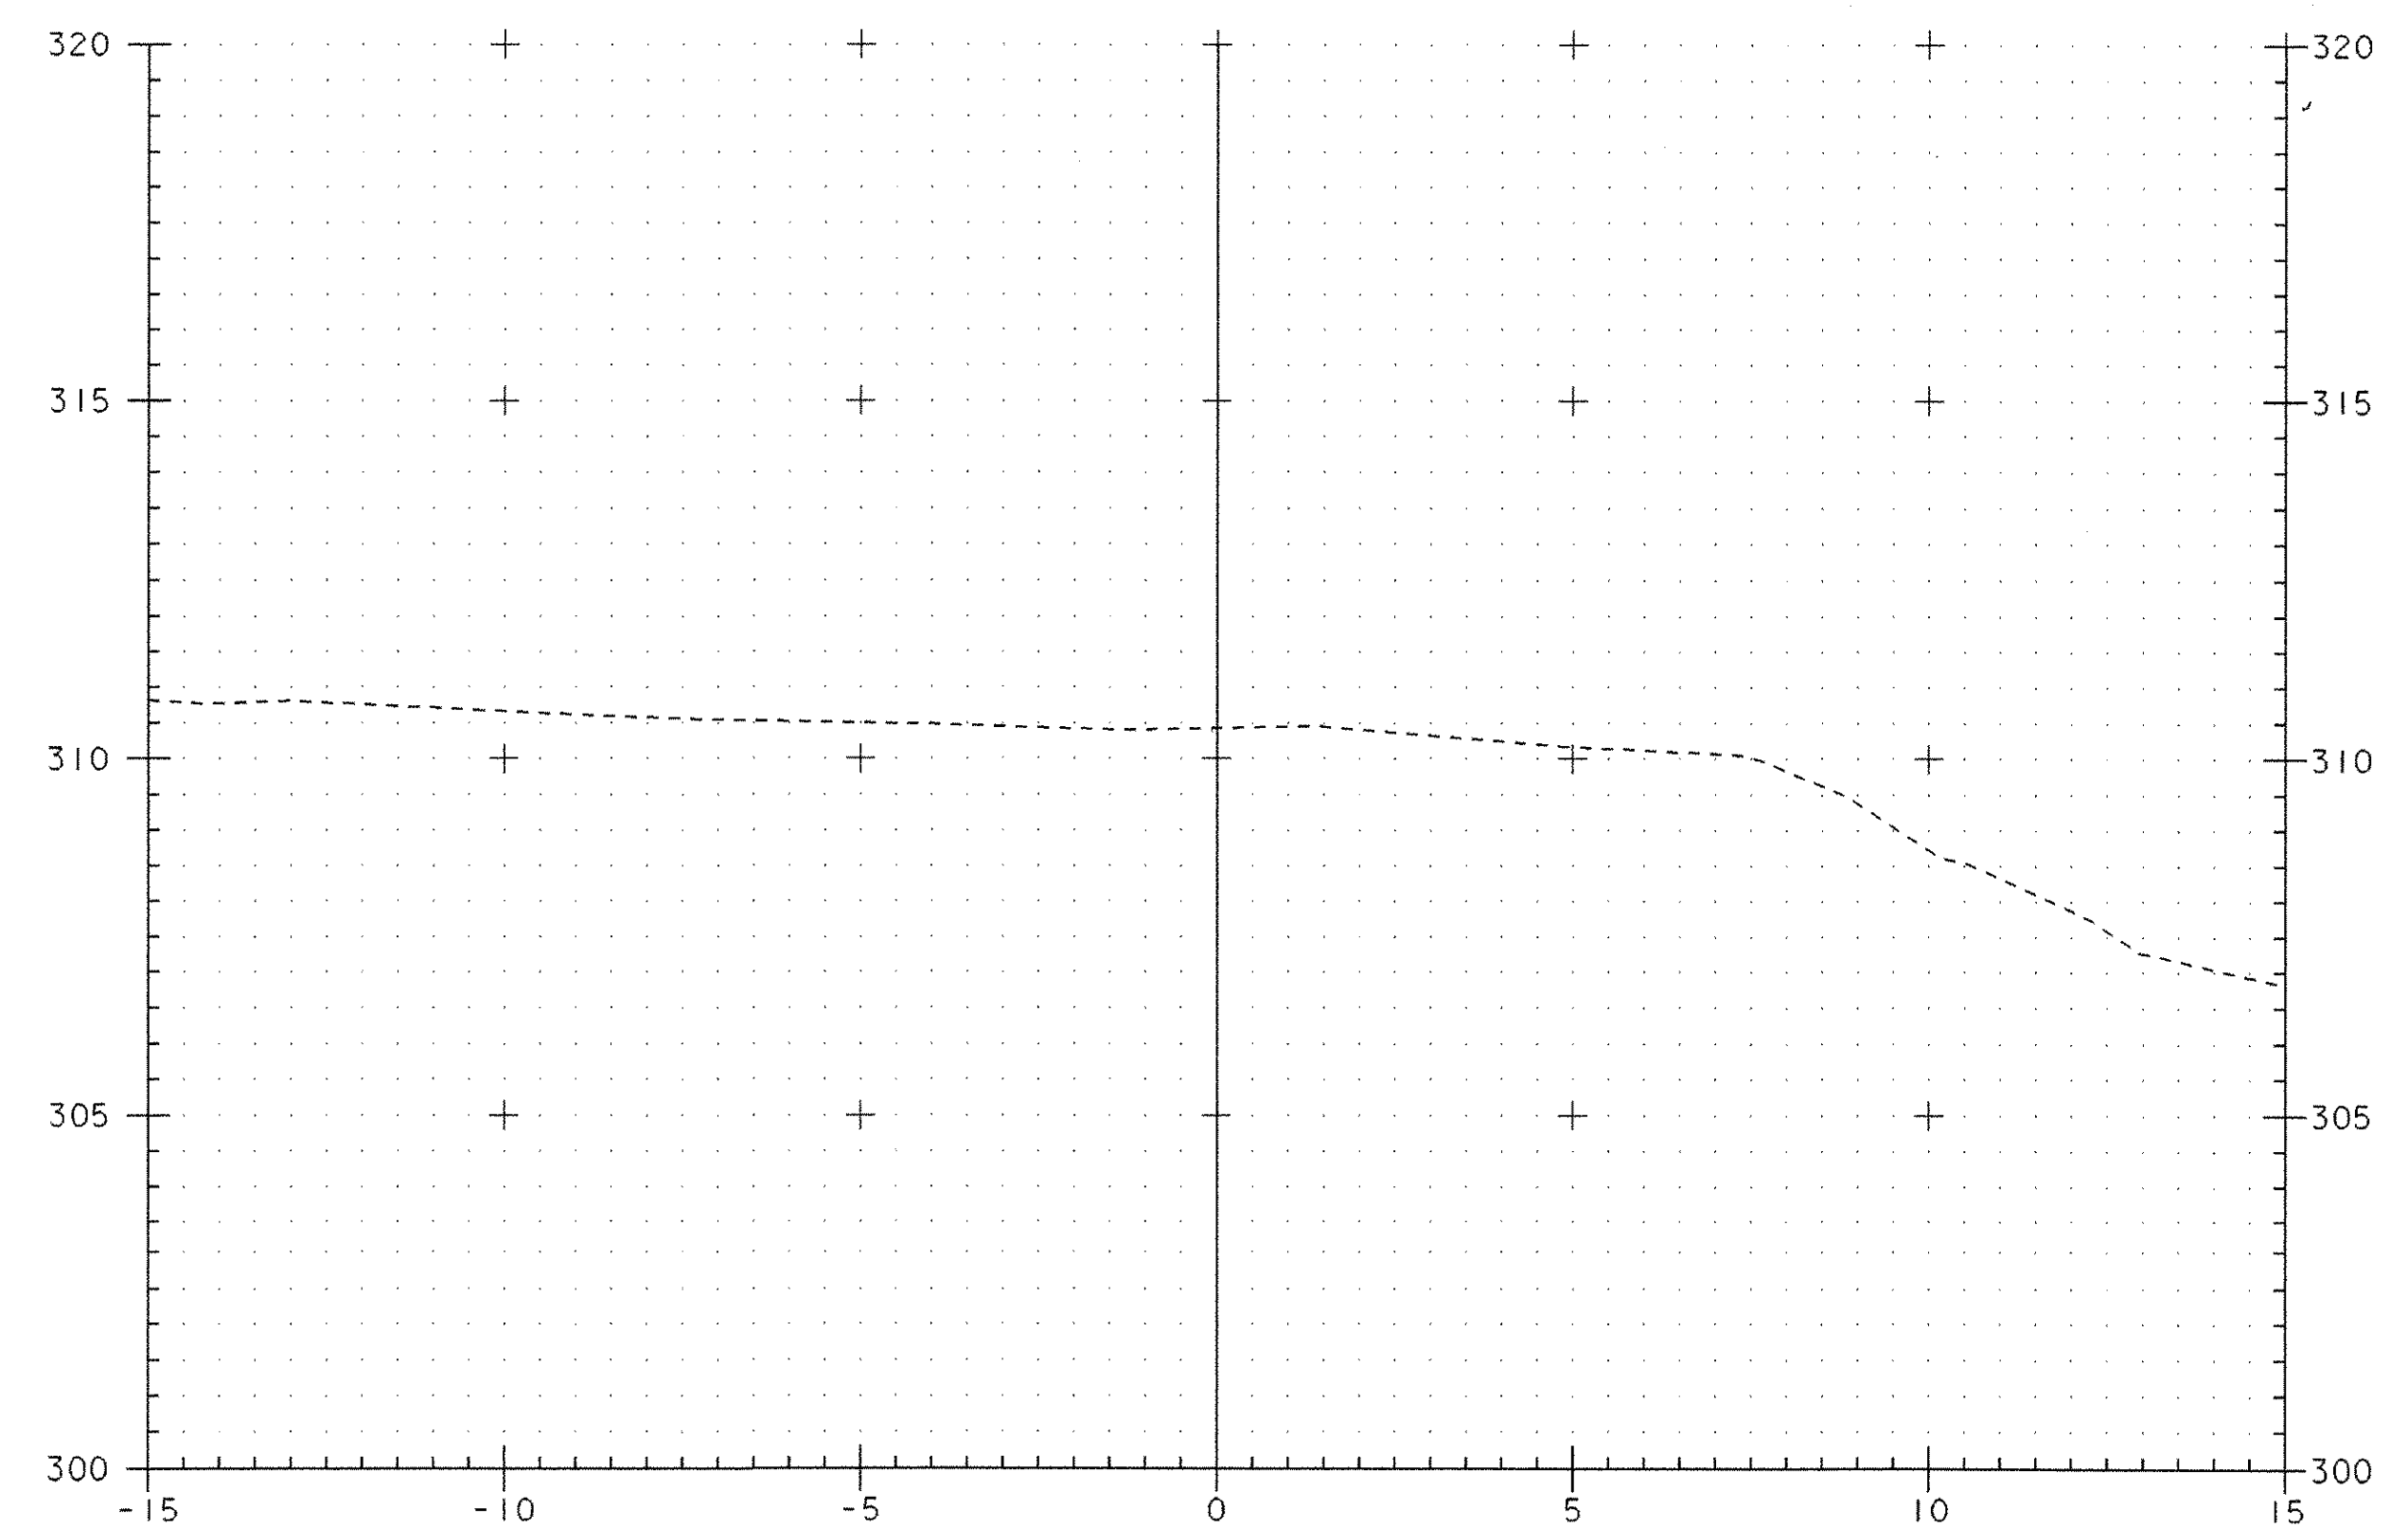

I+060



PROJECT: VERSHIRE	PROJECT NO.: BRO 1444(32)
DESIGN FILE NAME: 93j027/structures/sj027.xml.dgn	PLOT DATE: 24-FEB-2006
IPARM FILE NAME: sj027.m2.i	
MAINLINE CROSS SECTIONS	
SECTION I+040.000 THROUGH I+065.000	SHEET: 32 OF 34