

GPS CONTROL POINTS


**K-1:**  
STATION MARK IS A SURVEY DISK WITH SETTING IN TOP OF A LARGE ROCK OUTCROP.  
THE MARK IS STAMPED K-1 RESET 1986.

NORTHING: NOT AVAILABLE  
EASTING: NOT AVAILABLE  
ELEVATION: 249.147 M (817.41 FT)


**LOCATION:**  
HUNTINGTON CENTER

TO REACH FROM JUNCTION OF MAIN RD. (CL 2-1) AND EAST ST. (CL 3-4) PROCEED EAST ALONG EAST ST. FOR 0.6 MI (0.97 KM) TO THE JUNCTION OF FOREST CITY RD. (CL 3-22) AND THEN SOUTHEAST ALONG FOREST CITY RD. FOR 0.2 MI (0.32 KM). BENCHMARK IS APPROX. 550 FT (167.6 M) NORTHWEST OF THE FOREST CITY RD. BRIDGE OVER BRUSH BROOK; APPROX. 600 FT (182.9 M) SOUTHEAST OF THE "TAFT" RESIDENCE; 91 FT (27.7 M) SOUTHWEST OF FOREST CITY RD. CENTERLINE; 68 FT (20.7 M) SOUTHWEST OF NW-SE WIRE FENCE; 35.5 FT (10.8 M) NORTHWEST OF A NE-SW WIRE FENCE; 36 FT (11.0 M) NNW OF THE NORTHEAST GATEPOST OF AN IRON GATE IN THE NE-SW WIRE FENCE; 10 FT (3.0 M) WEST OF A 24 IN CLUMP MAPLE; 5 FT (1.5 M) SOUTHEAST OF AN 18 IN CLUMP MAPLE; IN A PASTURE; SET IN THE TOP OF A LARGE ROCK OUTCROP WHICH PROJECTS 4 FT (1.2 M) ABOVE GROUND.

TRAVERSE TIES

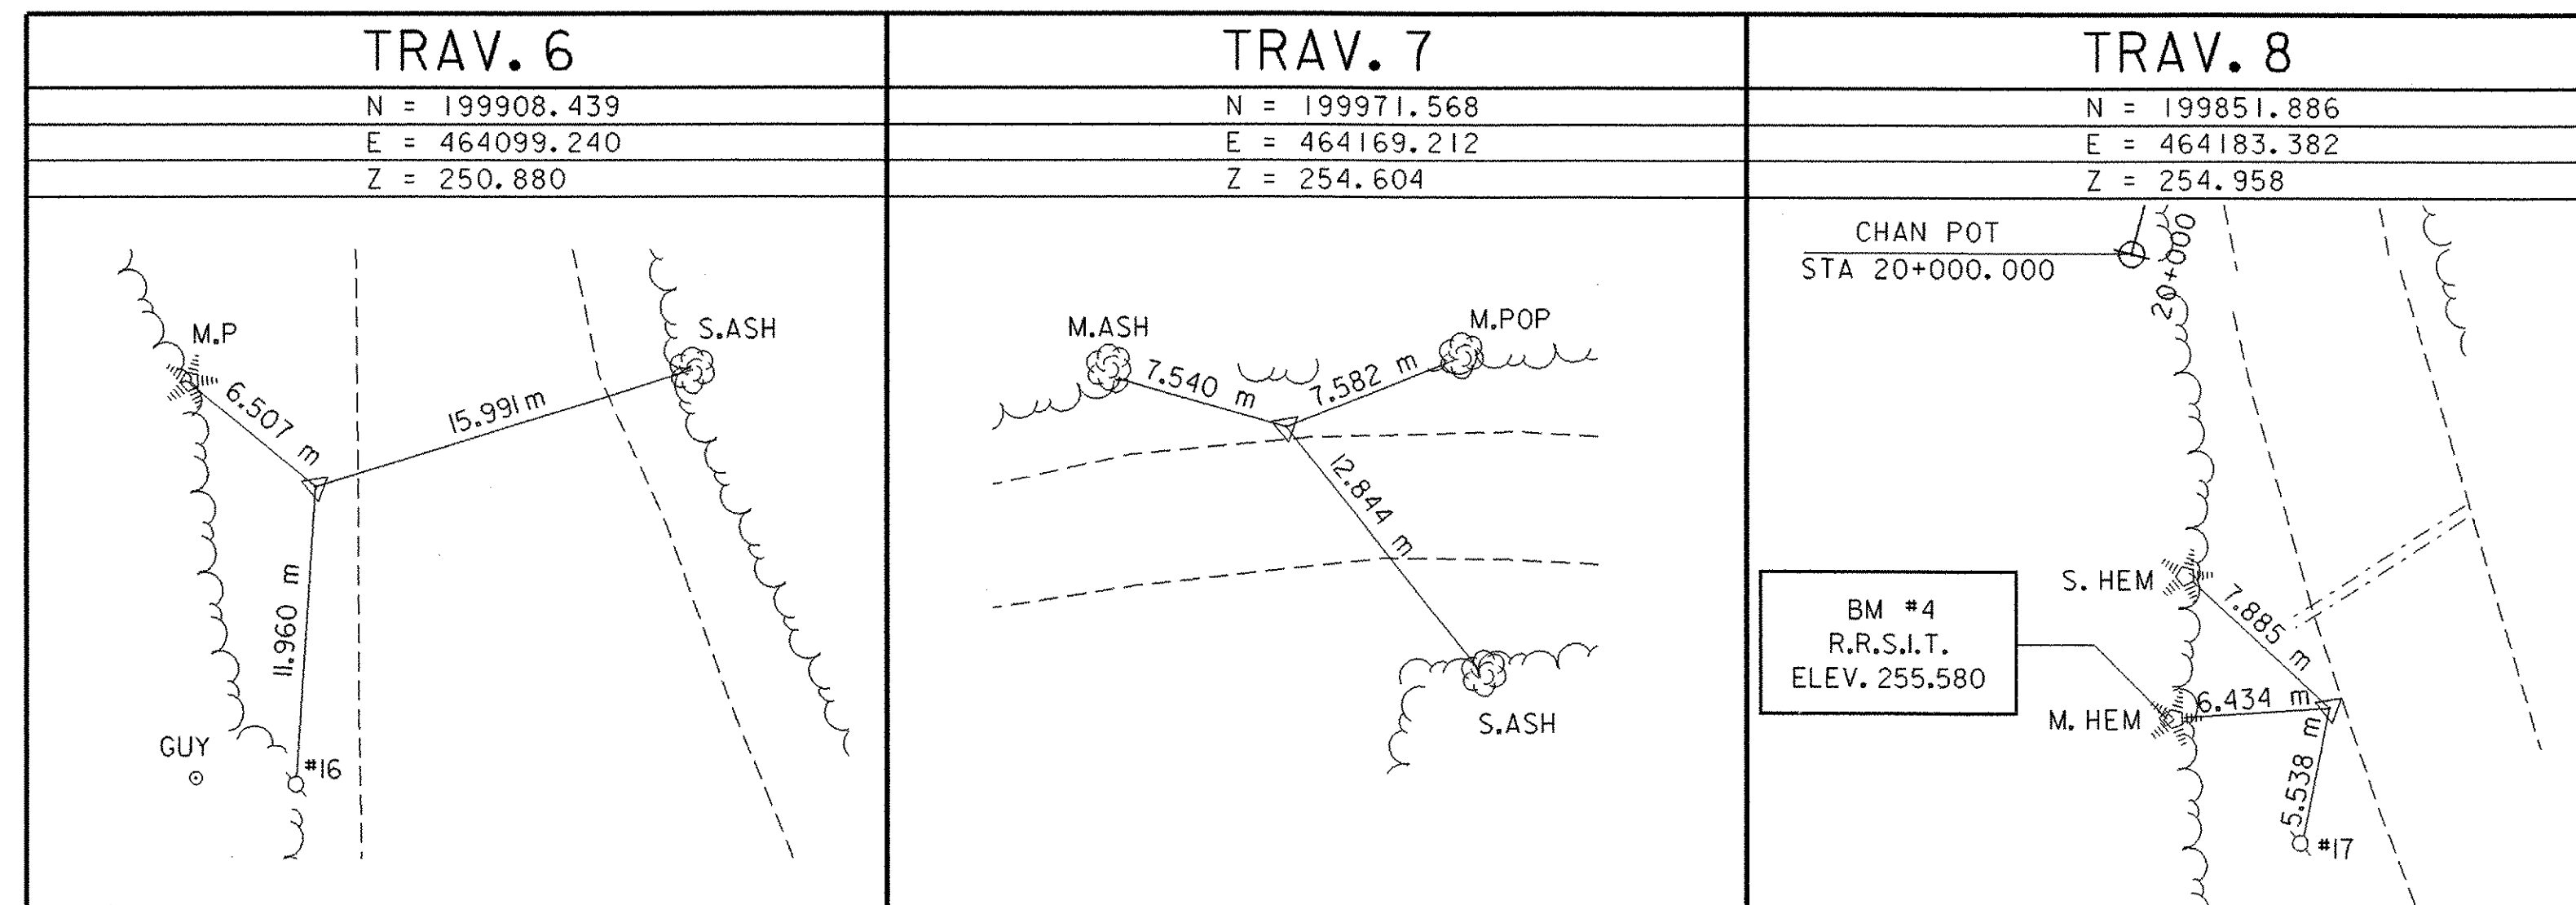

ALIGNMENT TIES

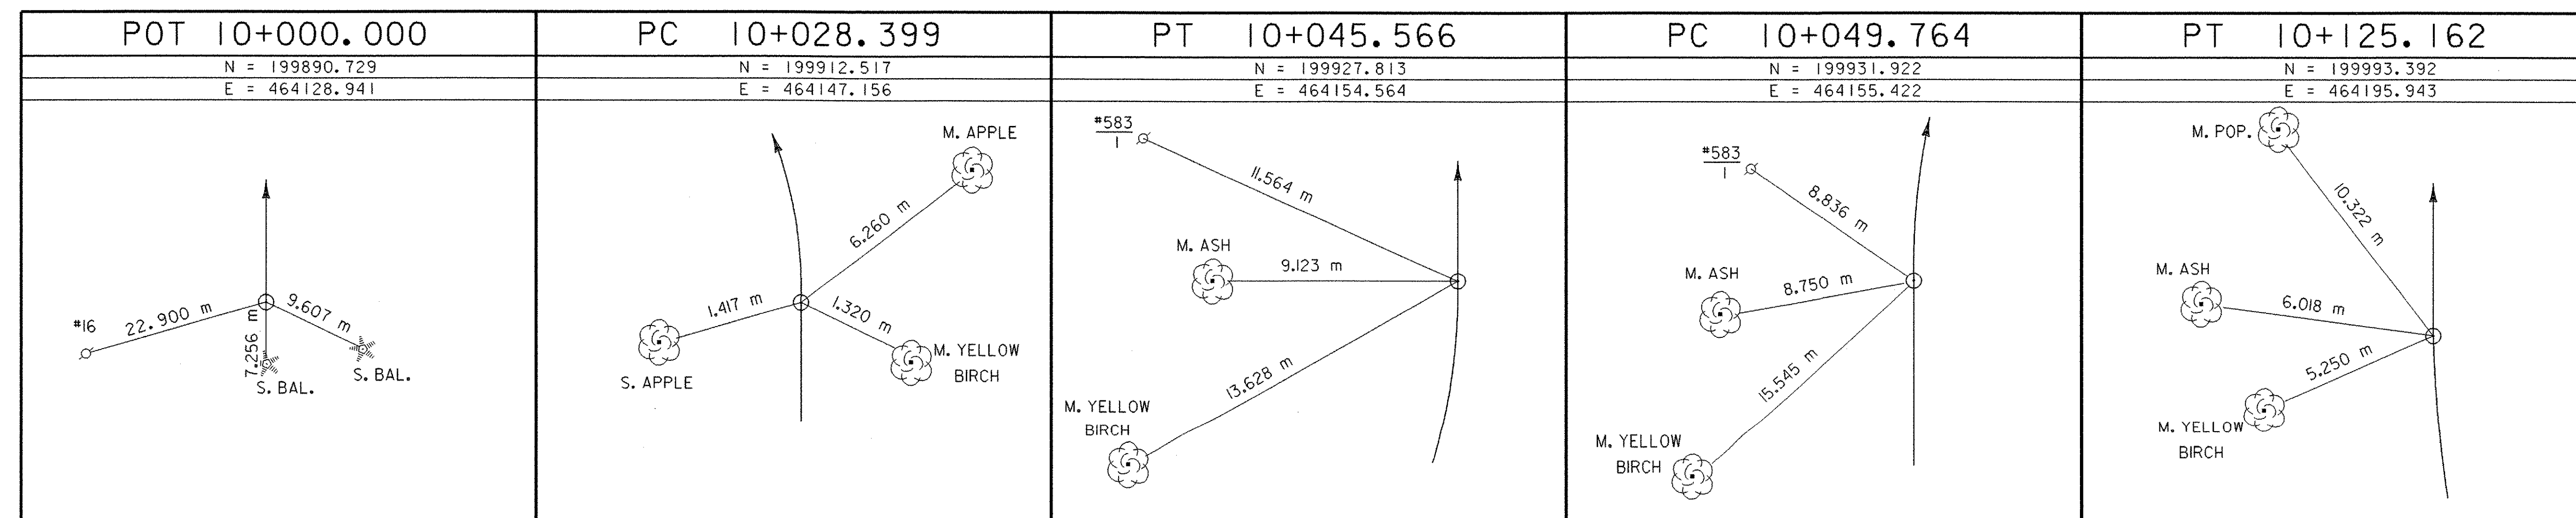

TIE SHEET

**DATUM**  
VERTICAL NAVD 88  
HORIZONTAL NAD 83 (92)

PROJECT NAME: HUNTINGTON  
PROJECT NUMBER: BRO 1445 (21)  
FILE NAME: 93J029\Structures\sj029tie.1 PLOT DATE: 09-JAN-2004  
PROJECT MANAGER: R.R. WHITCOMB DRAWN BY: J. ARMSTRONG  
DESIGNED BY: VAOT SURVEY CHECKED BY: M. LOZIER  
SHEET 7 OF 34