



PROFILE ALONG PROPOSED T.H. 21 CENTERLINE

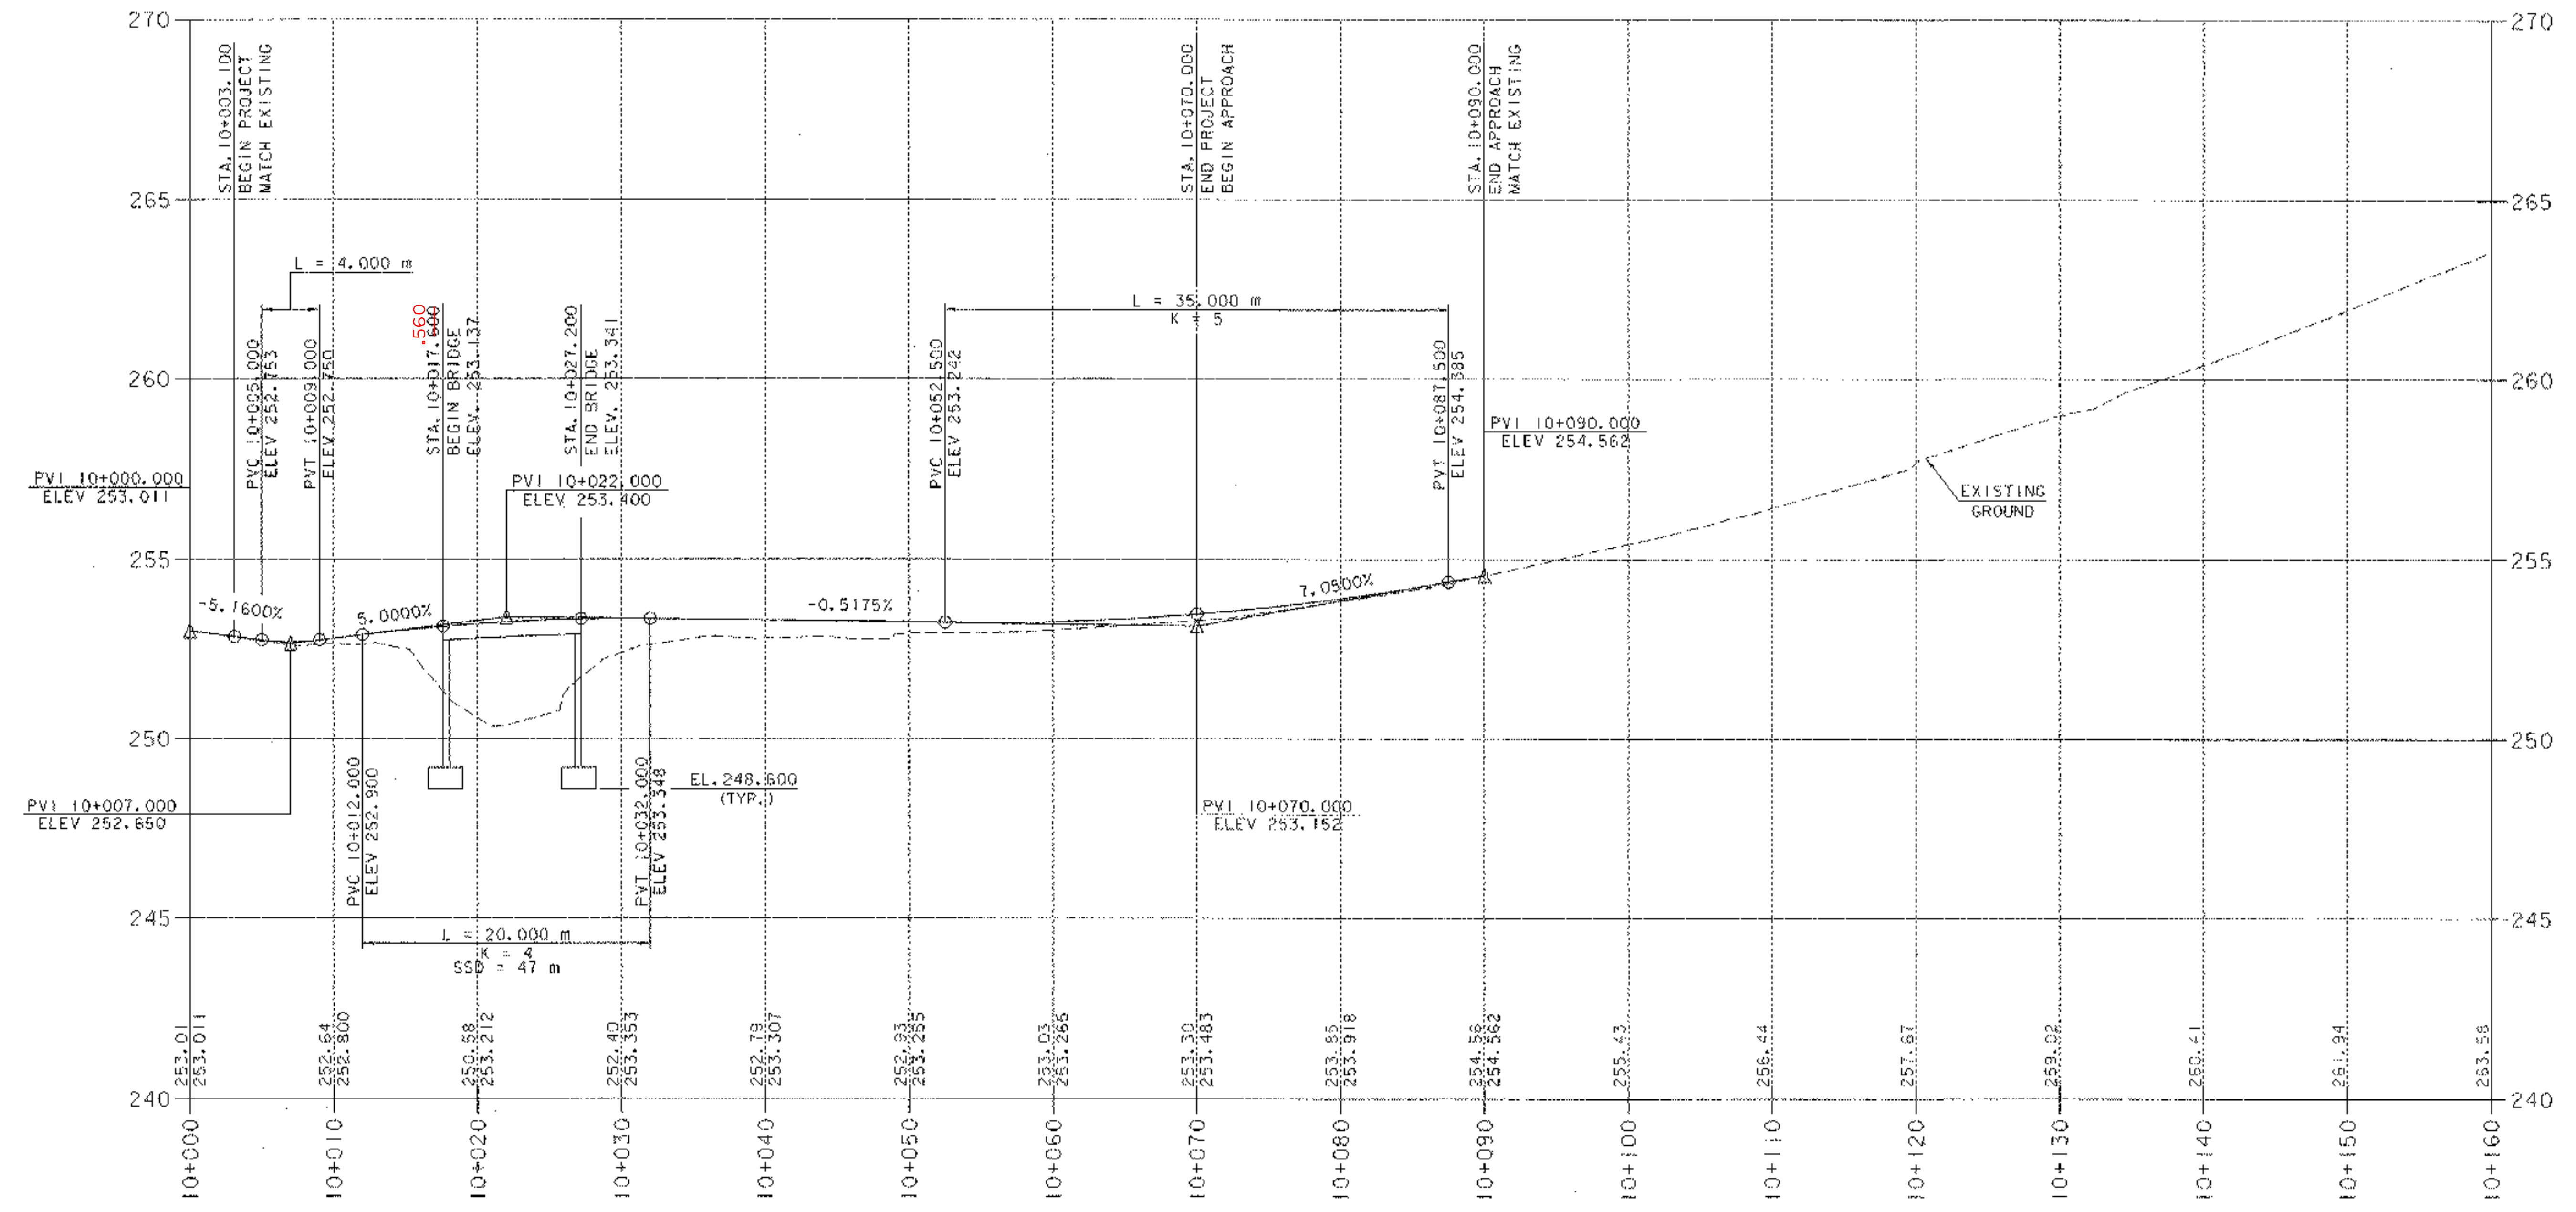

NOTE:
 ELEVATIONS TO THE NEAREST HUNDREDTH ARE
 EXISTING GROUND ALONG PROPOSED CENTERLINE.
 ELEVATIONS TO THE NEAREST THOUSANDTH ARE
 FINISH GRADE ALONG PROPOSED CENTERLINE.

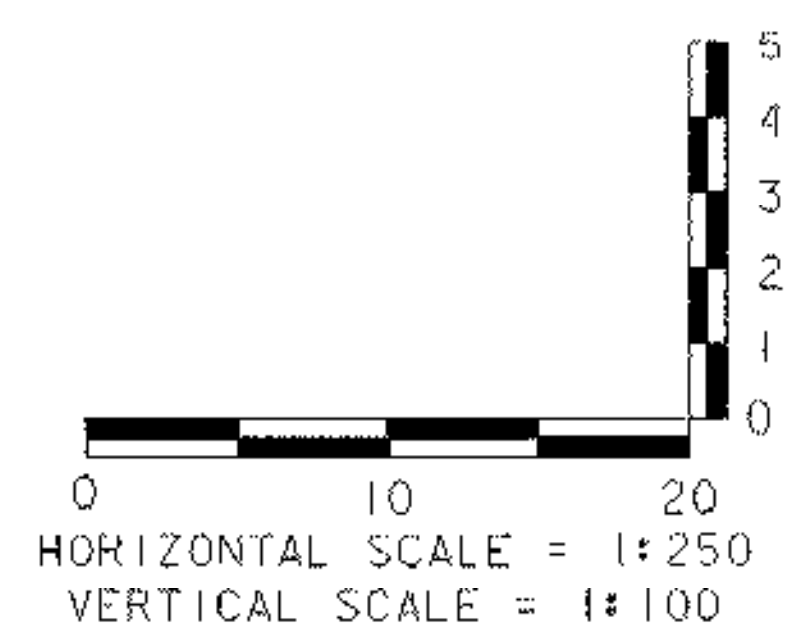

PROFILE SHEET

PROJECT NAME:	HUNTINGTON
PROJECT NUMBER:	BRO 1445 (21)
FILE NAME:	93J029\structures\sj029pf.1
PROJECT MANAGER:	R.R. WHITCOMB
DESIGNED BY:	R.R. WHITCOMB
PLOT DATE:	09-JAN-2004
DRAWN BY:	J. ARMSTRONG
CHECKED BY:	M. LOZIER
SHEET	9 OF 34