

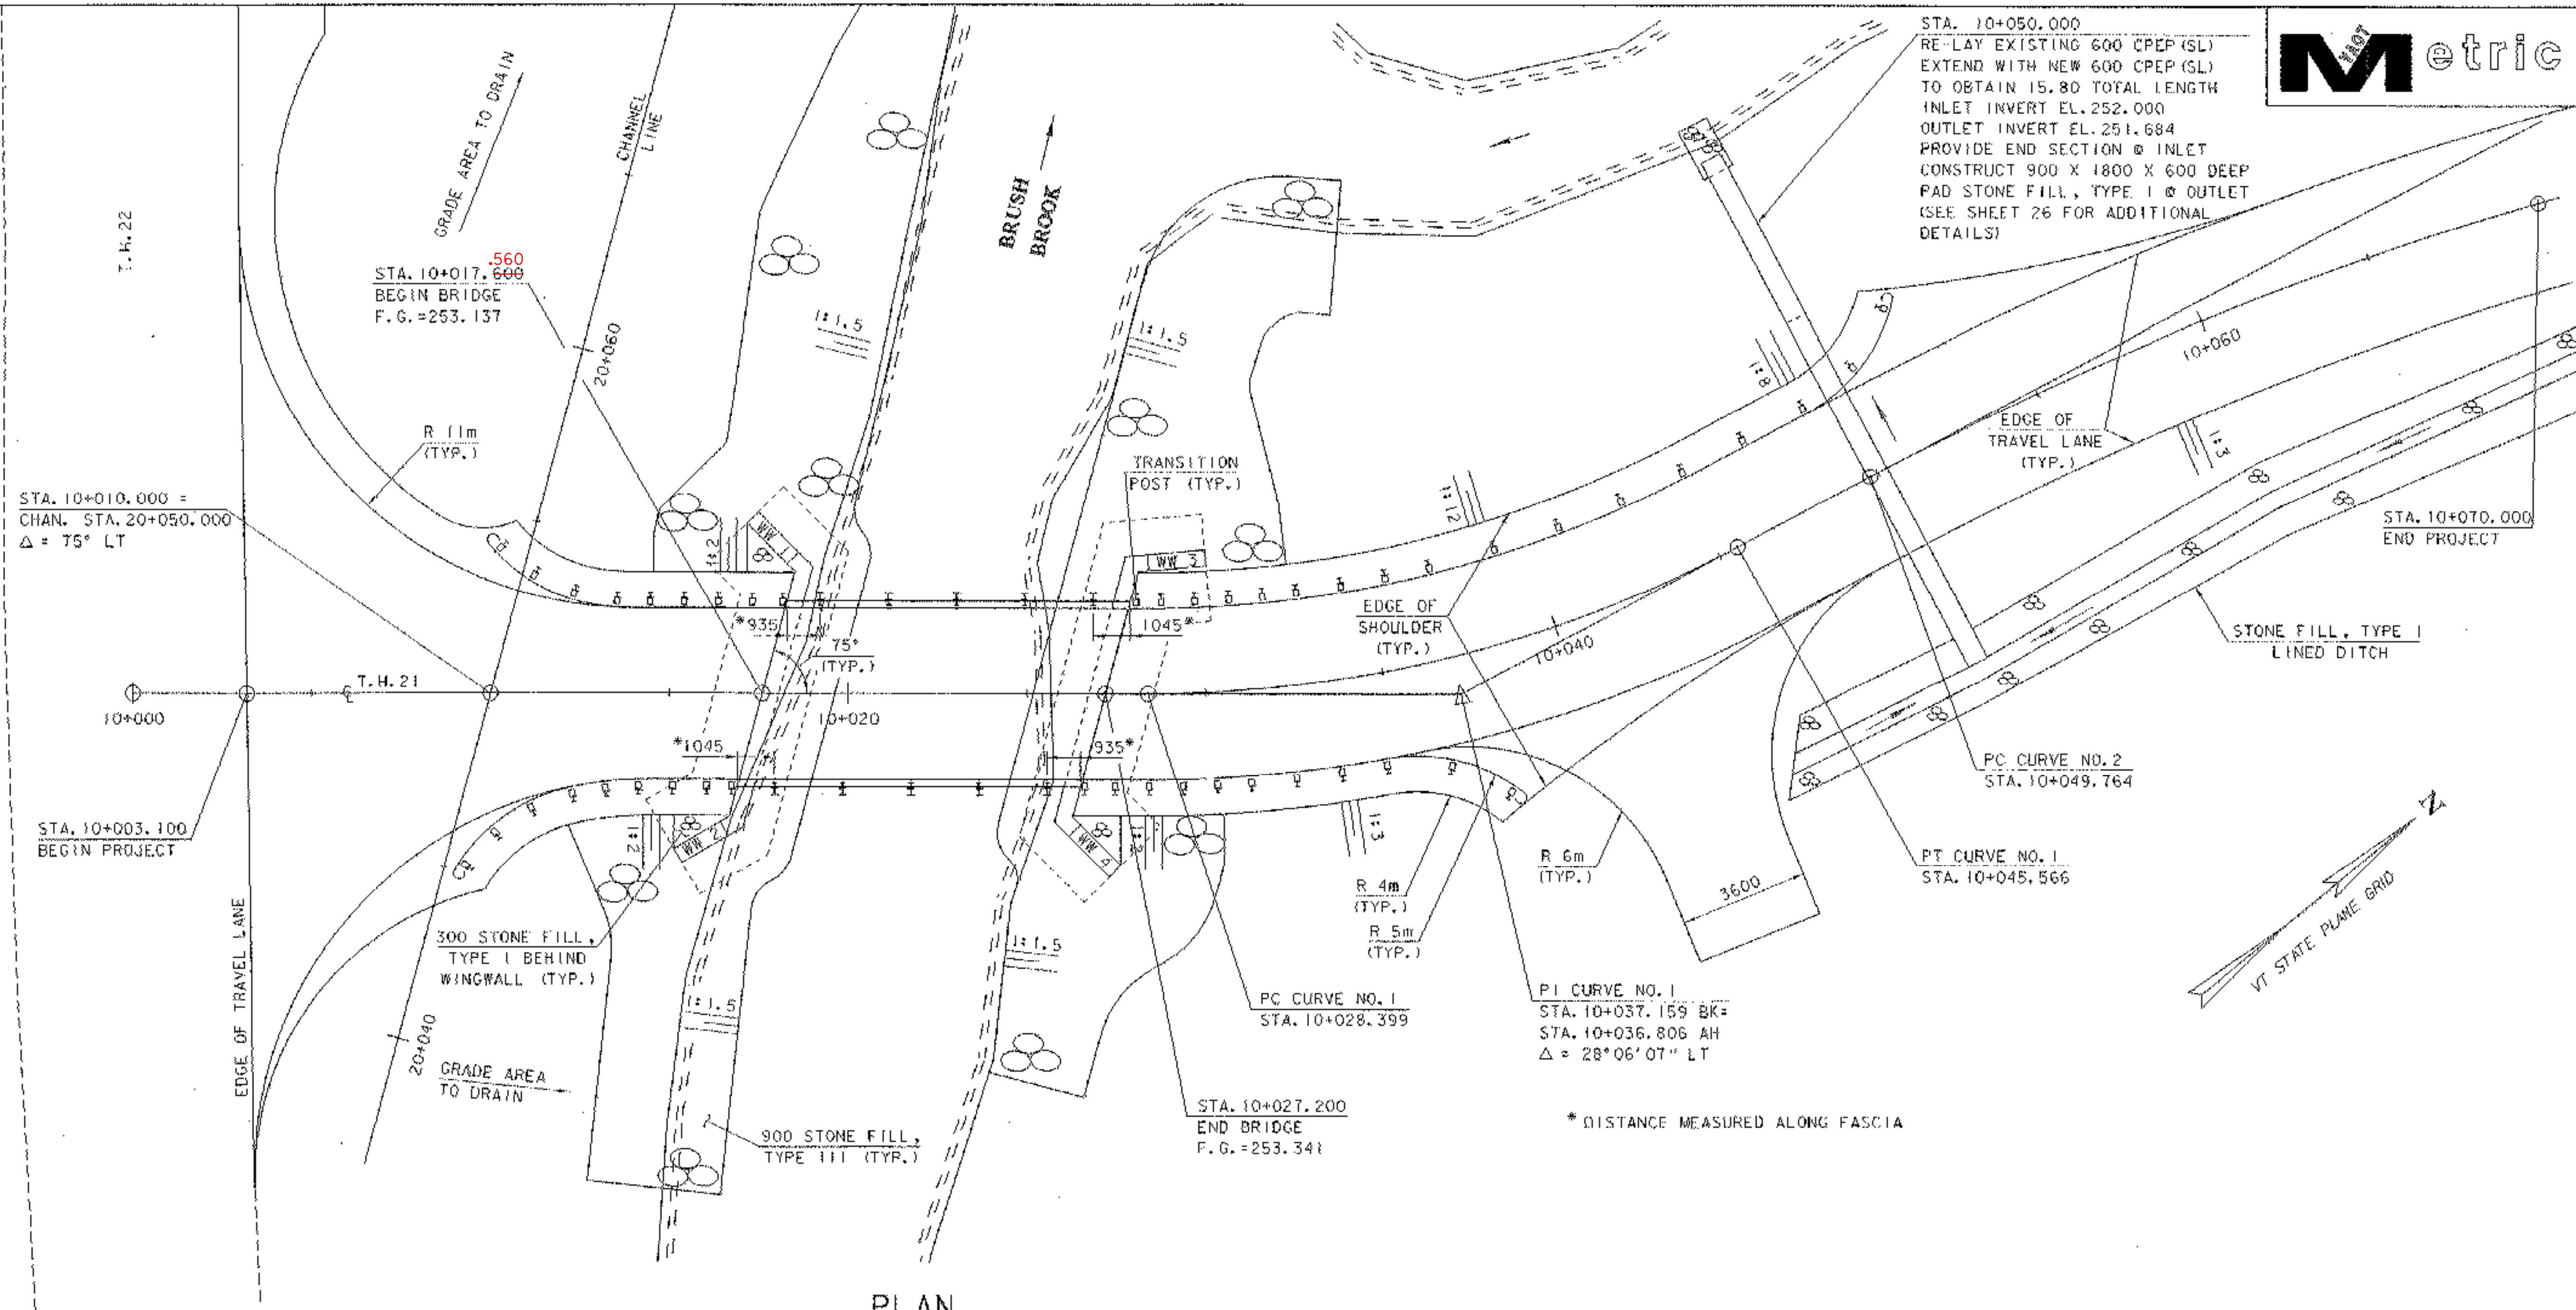


STA. 10+050.000
 RE-LAY EXISTING 600 CPEP (SL)
 EXTEND WITH NEW 600 CPEP (SL)
 TO OBTAIN 15.80 TOTAL LENGTH
 INLET INVERT EL. 252.000
 OUTLET INVERT EL. 251.684
 PROVIDE END SECTION @ INLET
 CONSTRUCT 900 X 1800 X 600 DEEP
 PAD STONE FILL, TYPE I @ OUTLET
 (SEE SHEET 26 FOR ADDITIONAL
 DETAILS)

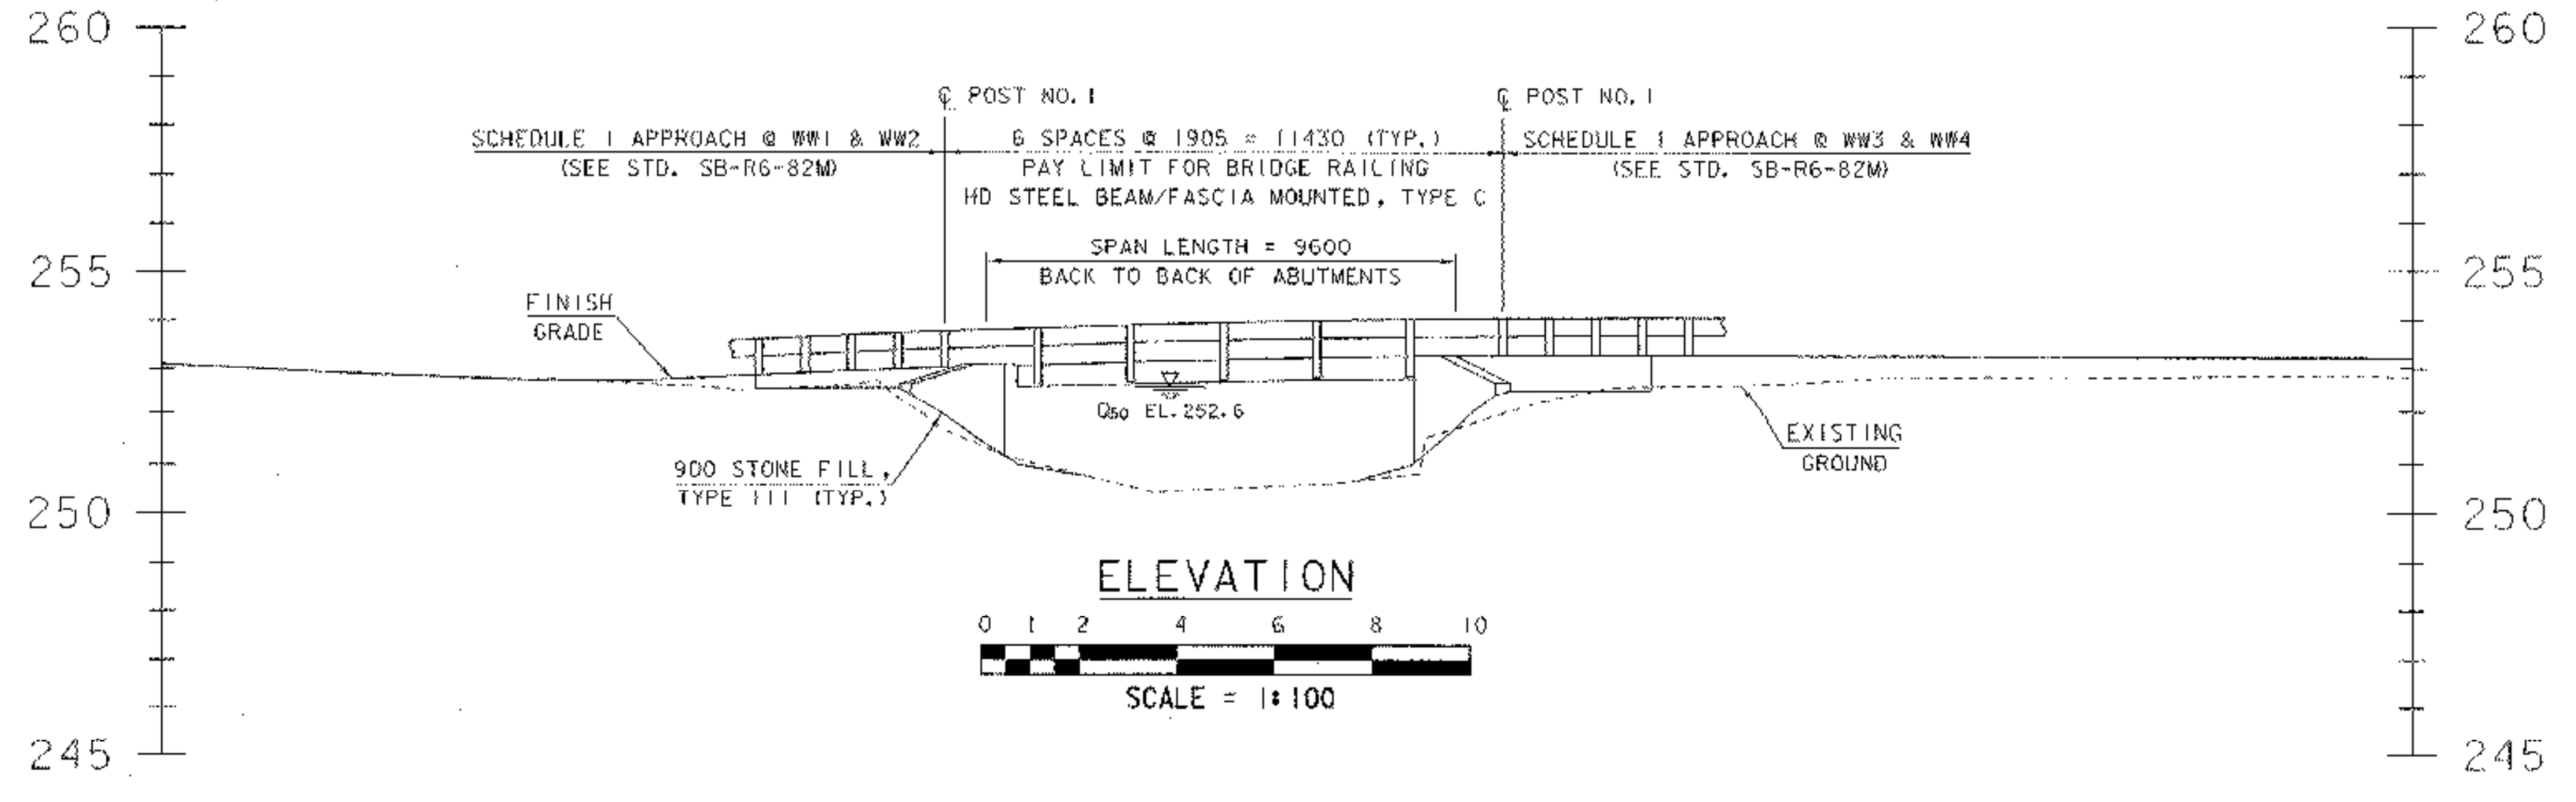

PLAN

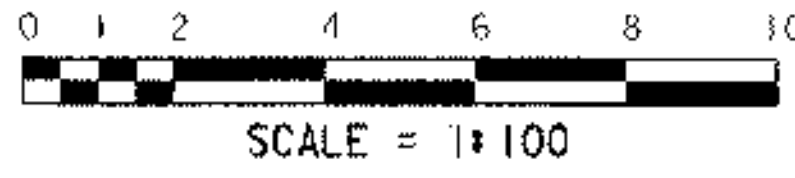

PLAN AND ELEVATION

PROJECT NAME:	HUNTINGTON	PLOT DATE:	09-JAN-2004
PROJECT NUMBER:	BRO 1445 (2)	DRAWN BY:	J. ARMSTRONG
FILE NAME:	93J029\structures\sj029pe1	CHECKED BY:	M. LOZIER
PROJECT MANAGER:	R.R. WHITCOMB	SHEET	12 OF 34
DESIGNED BY:	RRW / JEL		